


U. S. PUBLIC LAND SURVEY MONUMENT RECORD

SECTION 12 T 15 N, R 6 W, TOWN OF GREENFIELD

LA CROSSE COUNTY

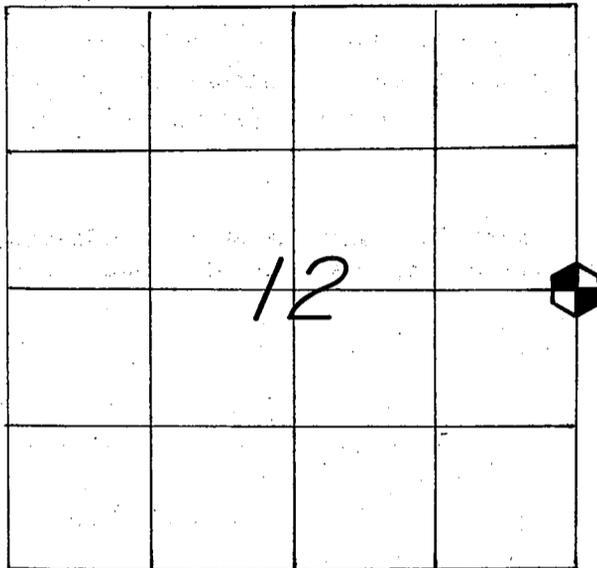

LOCATION OF LANDMARK

CREW: **BRYAN H. MEYER**
PETER F. FOLLANSBEE
DATE: **8/27/2009**

WISCONSIN COORDINATE SYSTEM	
North	654,142.247
East	1,696,260.435
Theta Angle	
Horiz. Order	
Vert. Order	
DATUM:	NAD 1983 ('91)
TYPE OF LANDMARK	
BRASS CAP LUNDE MARKER.	
BEARINGS ARE REFERENCED TO	
GRID NORTH AS PER SECTION DATA.	

Describe any record evidence, monument evidence, testimonial evidence or any other material evidence you considered and whether the monument was found or restored through acceptance of an obliterated evidence location.


While gathering GPS coordinate values for this corner, we located the Lunde marker at the corner and the iron pipe tie to the South. We also found that the three bearing trees shown on the previous tie sheet were gone. We established three new ties as shown.

Describe or show any material discrepancy between the location of the restored corner and that of the corner previously restored or reestablished.

None.


RECORD OF DURABLE WITNESS MONUMENTS

NO	DESCRIPTION	BEARING	DISTANCE
1	EX. IRON PIPE ON W.-SIDE OF FENCE, LEANING EAST	SOUTH ±	32.26 FT.
2	SET A 3/4"x30" IRON BAR DOWN 3"s IN 1/2 FIELD ROAD	N.-WESTERLY ±	41.41 FT.
3	SET A NAIL IN N.E.-SIDE OF A 9-1/4" SPRUCE	S.-EASTERLY ±	45.55 FT.
4	SET A NAIL IN N.E.-SIDE OF A 7" RED PINE	S.-EASTERLY ±	39.14 FT.

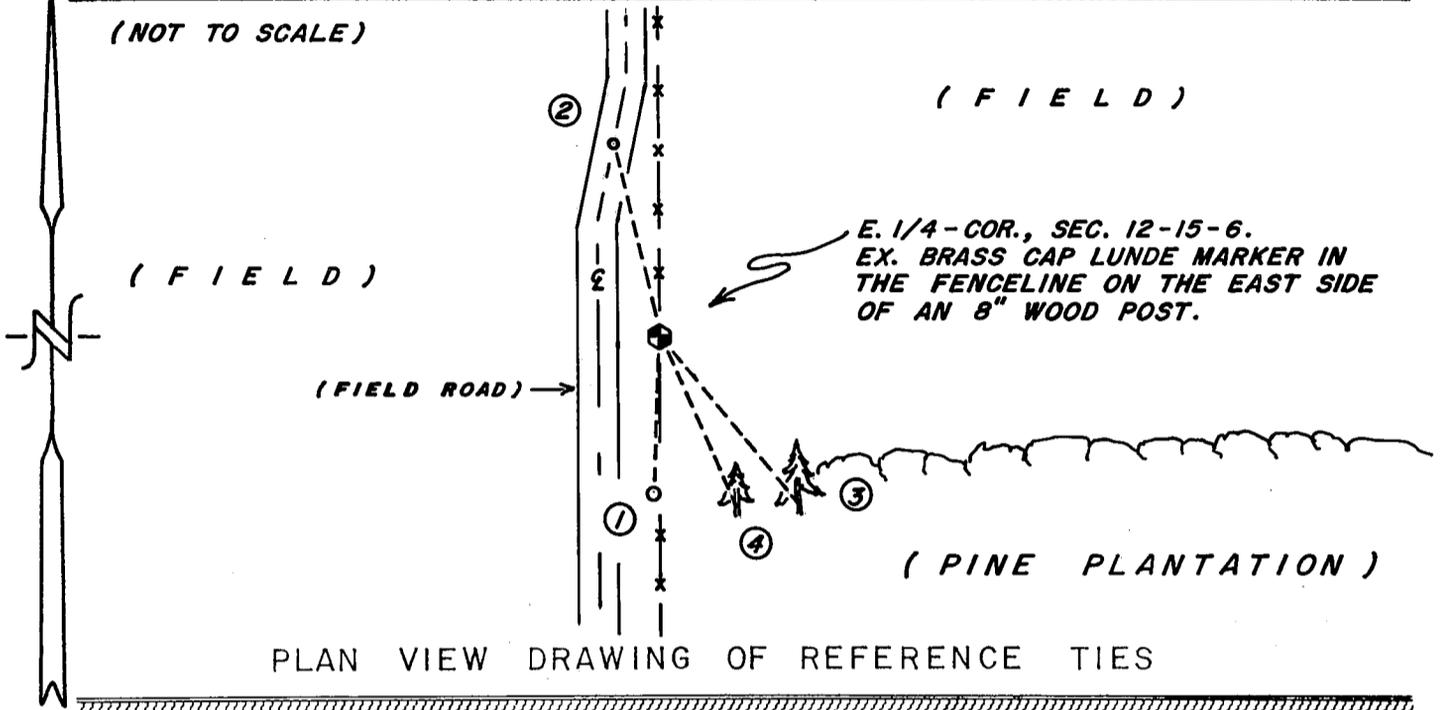

MAP SHOWING DISTANCE AND DIRECTION TO OTHER PUBLIC LAND SURVEY CORNERS USED FOR REESTABLISHING THE CORNER


(GRID BEARINGS AND DISTANCES)
(GRID FACTOR: 0.9998964)
(NOT TO SCALE)

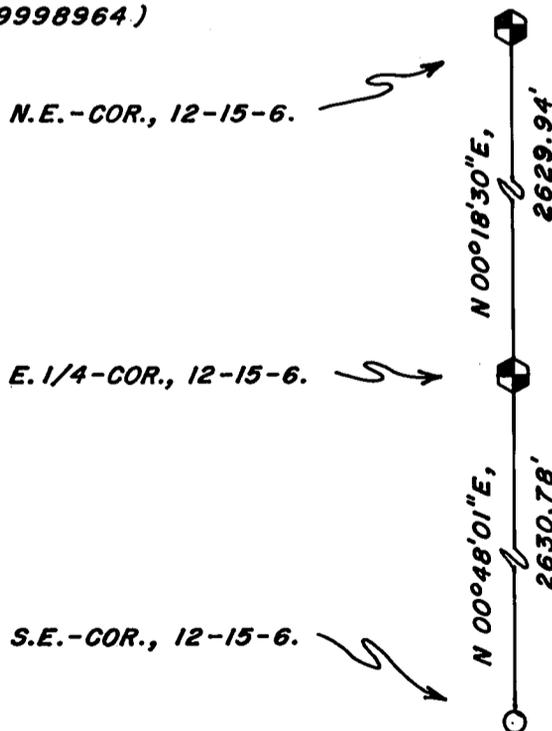

I, BRYAN H. MEYER, COUNTY SURVEYOR
HEREBY CERTIFY THAT THE CORNER LOCATION SHOWN ON THIS RECORD WAS DETERMINED BY ME OR UNDER MY DIRECTION AND CONTROL AND THAT THIS U. S. PUBLIC LAND SURVEY MONUMENT RECORD IS CORRECT AND COMPLETE TO THE BEST OF MY KNOWLEDGE AND BELIEF.

Bryan H. Meyer
Signature

2/15/2010
Date

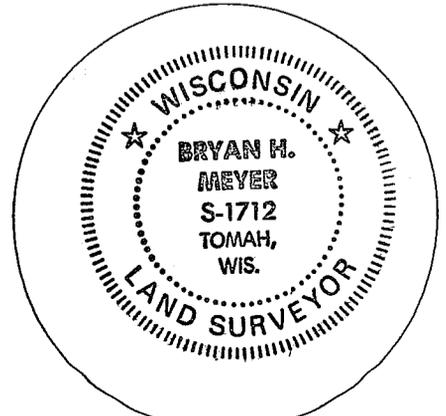


Seal

U. S. PUBLIC LAND SURVEY MONUMENT RECORD

SECTION 12 T 15 N, R 6 W, TOWN OF Greenfield

LA CROSSE COUNTY

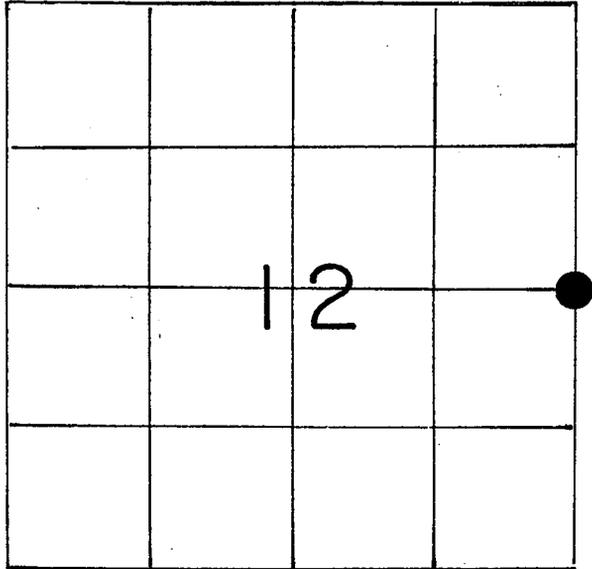

LOCATION OF LANDMARK

WISCONSIN COORDINATE SYSTEM

North

East

Theta Angle

Horiz. Order

Vert. Order

TYPE OF LANDMARK

Brass capped Lunde marker

BEARINGS ARE REFERENCED TO

True

Crew: William C. Jung
Peter F. Follansbee

Date: February 4, 1991

Describe any record evidence, monument evidence, testimonial evidence or any other material evidence you considered and whether the monument was found or restored through acceptance of an obliterated evidence location.


I accepted the old North-South fence as the best available evidence of the North-South direction of the original survey and set the the corner in this fence at distances equidistant between the section corners. I set a Lunde marker at the corner with a whiskey bottle and shell casing buried to the South and a sign with post South of the bottle.

Describe or show any material discrepancy between the location of the restored corner and that of the corner previously restored or reestablished.

I believe that the pipe 32.26 feet to the South was set by Clayton Solberg and was intended to be the 1/4 corner. I do not agree with it.


RECORD OF DURABLE WITNESS MONUMENTS

NO	DESCRIPTION	BEARING	DISTANCE
1	Existing iron pipe by wood fence post	S2.5°W	32.26
2	Set nail on West side of unblazed 7" pine	2' East of P.L.	40.06
3	" " 8" "	14' "	40.69
4	" " 5" "	34' "	49.25

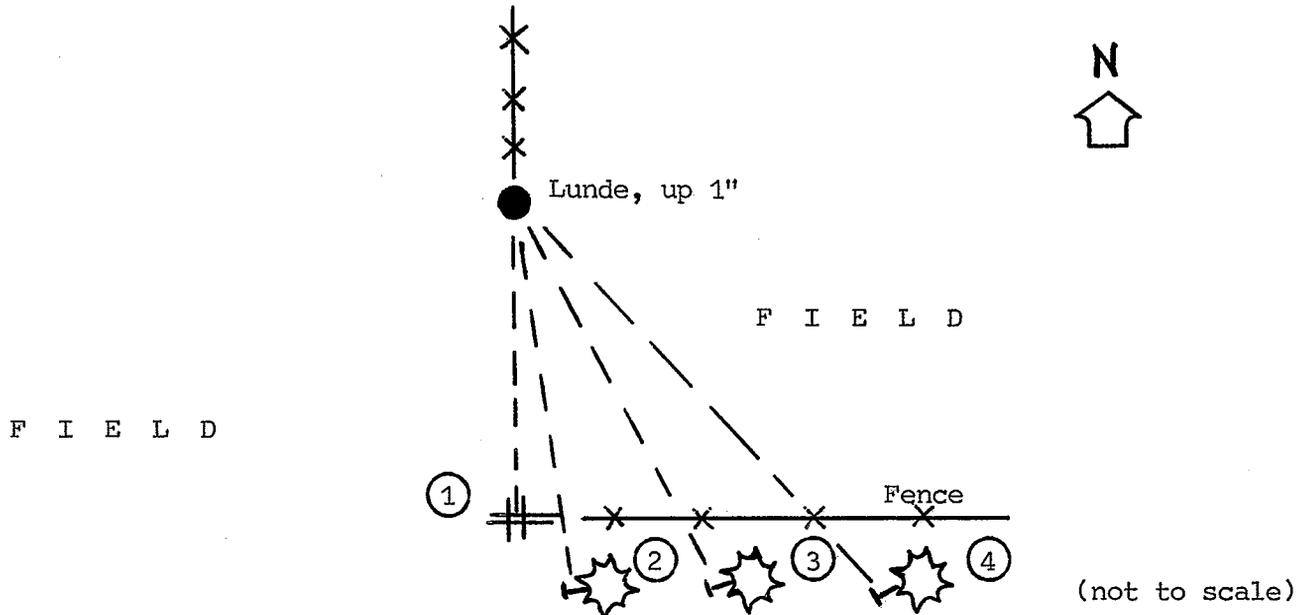

PLAN VIEW DRAWING OF REFERENCE TIES

MAP SHOWING DISTANCE AND DIRECTION TO OTHER PUBLIC LAND SURVEY CORNERS USED FOR REESTABLISHING THE CORNER

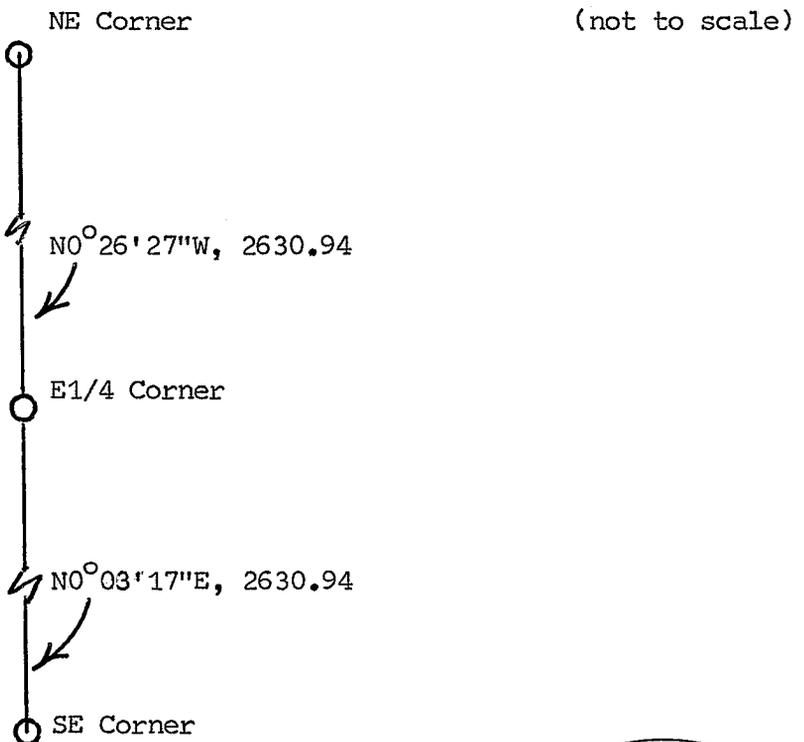


I, William C. Jung, Deputy County Surveyor,
 HEREBY CERTIFY THAT THE CORNER LOCATION SHOWN ON THIS RECORD
 WAS DETERMINED BY ME OR UNDER MY DIRECTION AND CONTROL AND
 THAT THIS U. S. PUBLIC LAND SURVEY MONUMENT RECORD IS CORRECT
 AND COMPLETE TO THE BEST OF MY KNOWLEDGE AND BELIEF.

William C. Jung
 Signature

February 5, 1991
 Date

Revised: 3/9/95 weg

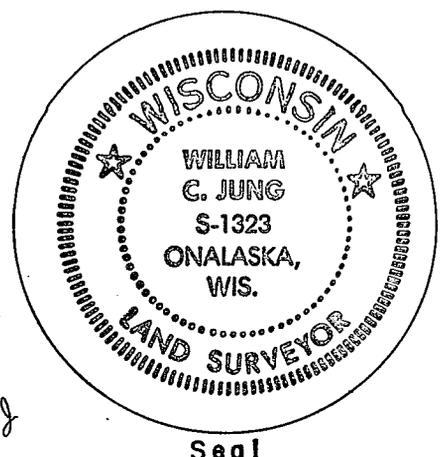

Seal