


U. S. PUBLIC LAND SURVEY MONUMENT RECORD

SECTION 13 T 15 N, R 6 W, TOWN OF GREENFIELD
 LA CROSSE COUNTY

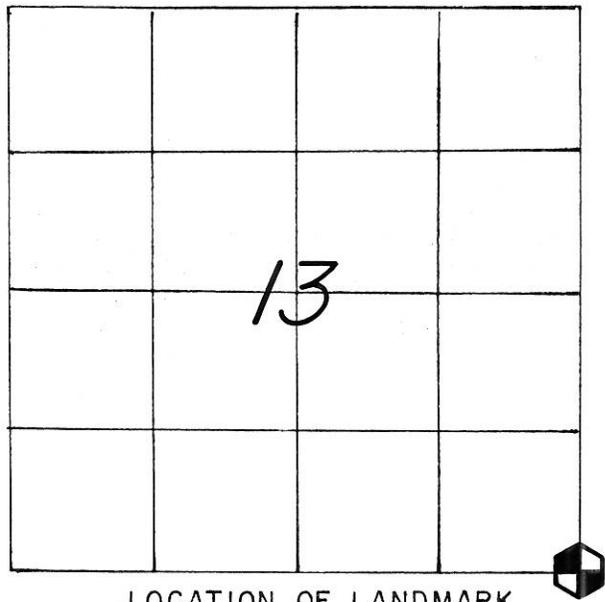

LOCATION OF LANDMARK

CREW: **BRYAN H. MEYER**
PETER F. FOLLANSBEE
 DATE: **9/01/2009**


WISCONSIN COORDINATE SYSTEM	
North	646,296.549
East	1,696,171.618
Theta Angle	
Horiz. Order	
Vert. Order	
DATUM:	NAD 1983('91)
TYPE OF LANDMARK	
BRASS CAP LUNDE MARKER.	
BEARINGS ARE REFERENCED TO	
GRID NORTH AS PER SECTION DATA.	

Describe any record evidence, monument evidence, testimonial evidence or any other material evidence you considered and whether the monument was found or restored through acceptance of an obliterated evidence location.


Describe or show any material discrepancy between the location of the restored corner and that of the corner previously restored or reestablished.

RECORD OF DURABLE WITNESS MONUMENTS

NO	DESCRIPTION	BEARING	DISTANCE
1	SET A NEW NAIL IN S.E.-SIDE OF A 12-1/2" W. OAK	N 23° E	11.80 FT.
2	SET A NEW NAIL IN N.W.-SIDE OF A 7-1/2" W. OAK	N 50° E	28.65 FT.
3	SET A NEW NAIL IN S.W.-SIDE OF AN 11" W. OAK	S 37° E	23.40 FT.
4	EX. 1" IRON PIPE N.-EAST OF A BLAZED BIRCH	S 05° E	98.82 FT.

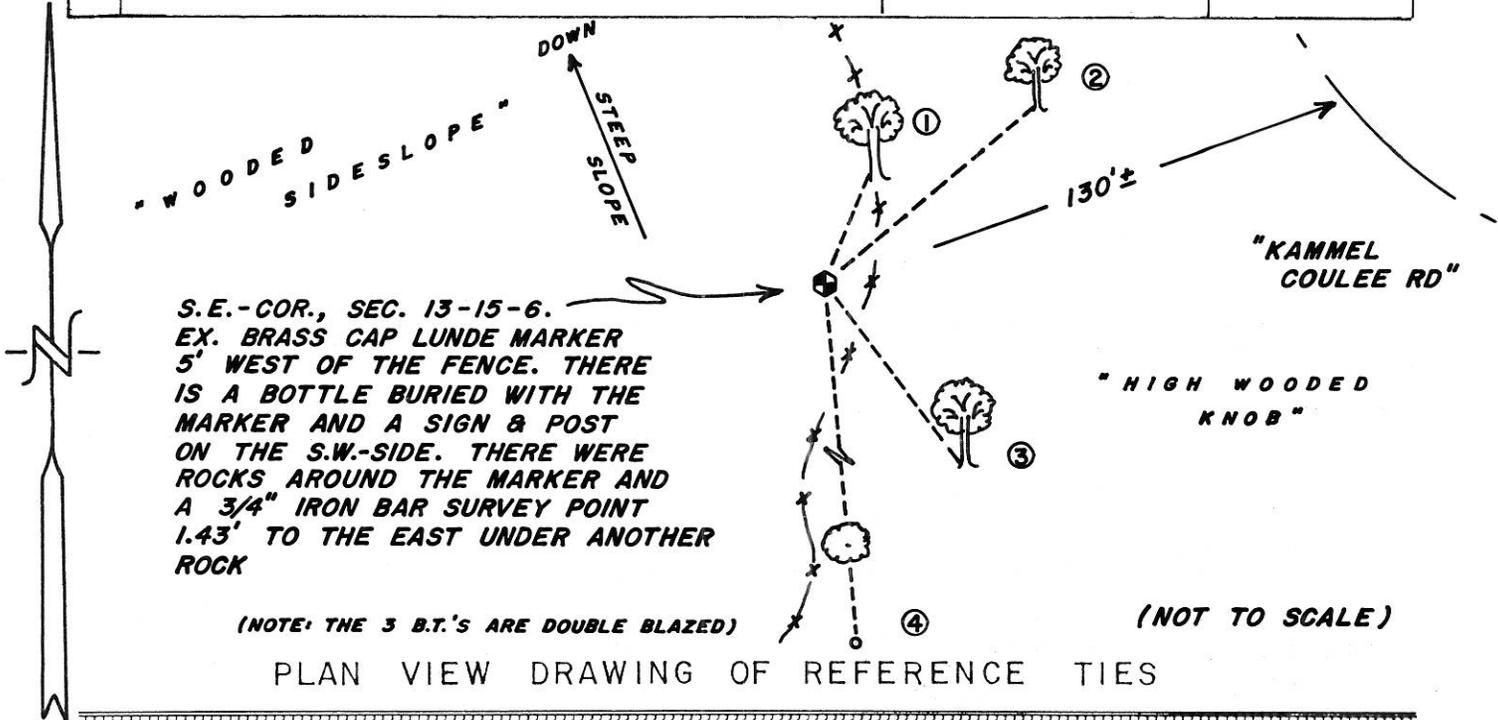

MAP SHOWING DISTANCE AND DIRECTION TO OTHER PUBLIC LAND SURVEY CORNERS USED FOR REESTABLISHING THE CORNER

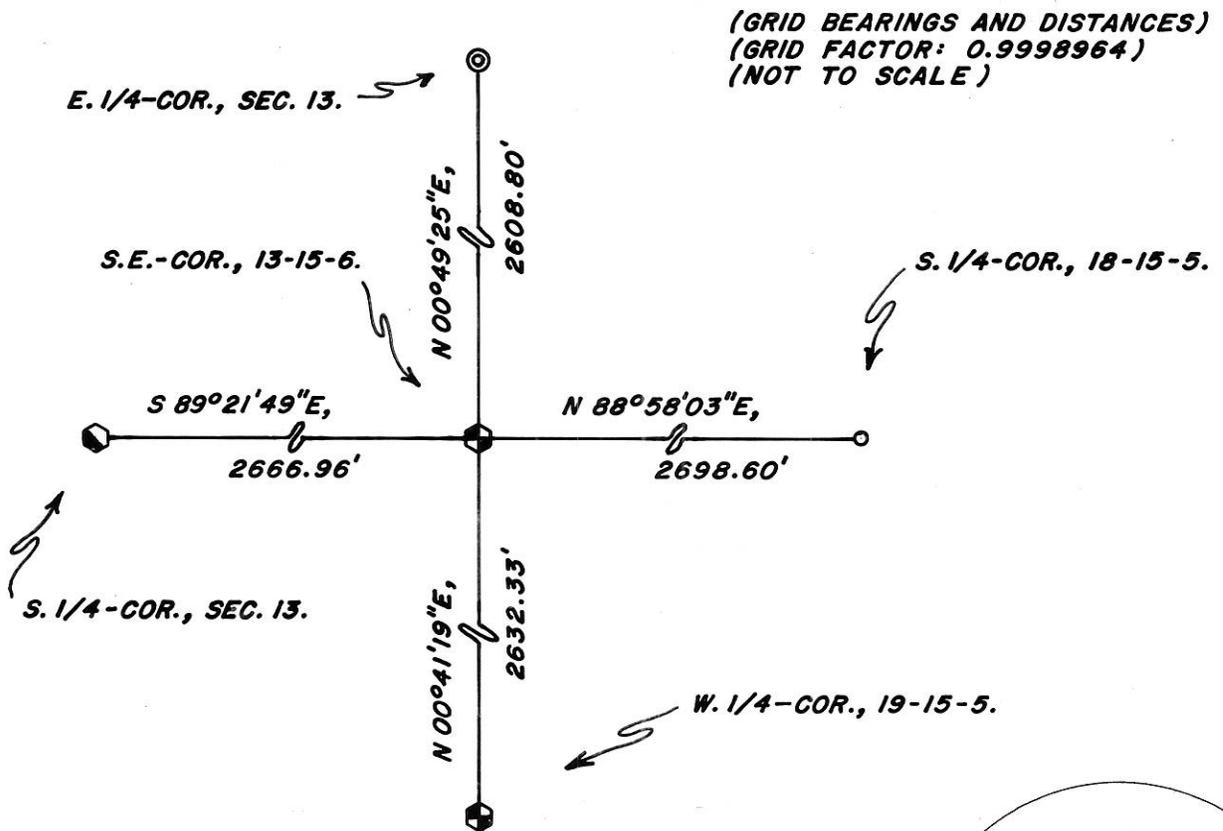

I, BRYAN H. MEYER, COUNTY SURVEYOR
HEREBY CERTIFY THAT THE CORNER LOCATION SHOWN ON THIS RECORD
WAS DETERMINED BY ME OR UNDER MY DIRECTION AND CONTROL AND
THAT THIS U. S. PUBLIC LAND SURVEY MONUMENT RECORD IS CORRECT
AND COMPLETE TO THE BEST OF MY KNOWLEDGE AND BELIEF.

Signature [Signature] Date 9/18/2009




Seal

U. S. PUBLIC LAND SURVEY MONUMENT RECORD

SECTION 13 T 15 N, R 6 W, TOWN OF Greenfield

LA CROSSE COUNTY

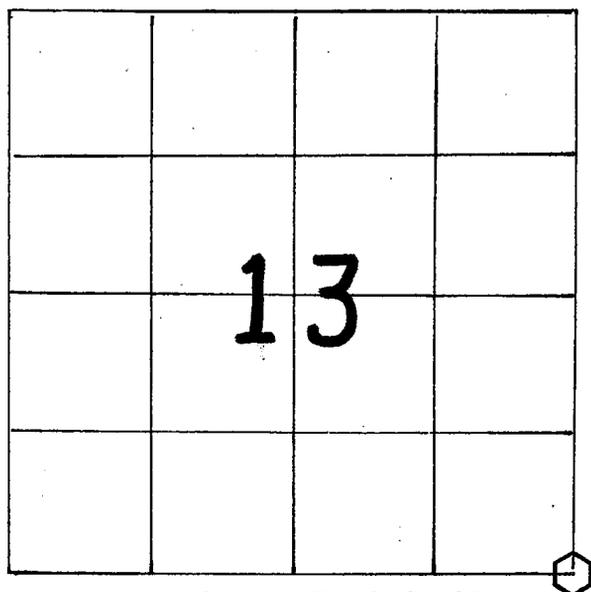

LOCATION OF LANDMARK

WISCONSIN COORDINATE SYSTEM

North

East

Theta Angle

Horiz. Order

Vert. Order

TYPE OF LANDMARK

Brass capped Lunde marker

BEARINGS ARE REFERENCED TO

True

Crew: William C. Jung
Peter F. Follansbee

Date: June 19, 1994

Describe any record evidence, monument evidence, testimonial evidence or any other material evidence you considered and whether the monument was found or restored through acceptance of an obliterated evidence location.


Dick Berg set an iron pipe at this corner in June of 1980. I searched at great length but could not find the pipe. It may have been vandalized. I set a brass capped Lunde marker where I feel that Berg's corner should have been. After going over the evidence, Berg's section data, and my section data, I agree with Berg's computed location. Also, in my opinion, the original surveyors "dropped" two "2 pole chains" along the East line of Section 13. Describe or show any material discrepancy between the location of the restored corner and that of the corner previously restored or reestablished.

If the existing 1" iron pipe $S4^{\circ}35'29''E, 98.82'$ from the Lunde, is intended to be the corner, I disagree with it.

RECORD OF DURABLE WITNESS MONUMENTS

NO	DESCRIPTION	BEARING (True)	DISTANCE
1	Ex. 1" iron pipe Northeast of blazed birch	S4°35'29"E	98.82
2	P.K. nail in double blazed 9½" white oak	Mag.=S37°E	23.29
3	" " 6" "	Mag.=N50°E	29.07
4	" " 10" "	Mag.=N23°E	11.78

Set a brass capped Lunde marker, 5' West of the fence. Buried a bottle with the Lunde and set a sign and post on the SW side. Built a rockpile around the marker. Dug up old N-S tie fence wire under the newer fence to the East. 1.43' to the East is my 3/4" iron bar survey point under a rock.

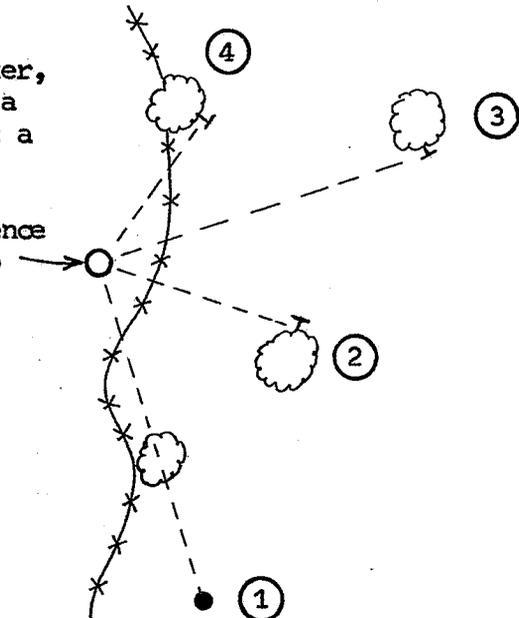


(not to scale)

PLAN VIEW DRAWING OF REFERENCE TIES

MAP SHOWING DISTANCE AND DIRECTION TO OTHER PUBLIC LAND SURVEY CORNERS USED FOR REESTABLISHING THE CORNER

(not to scale)

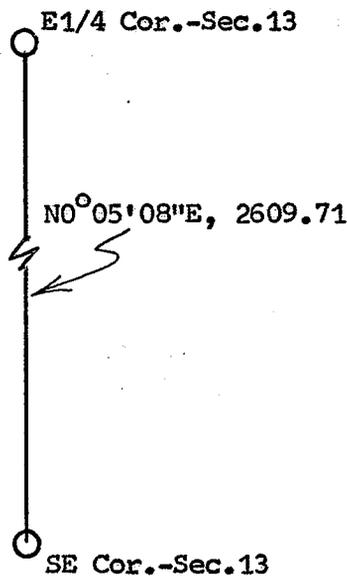


I, William C. Jung, County Surveyor,

HEREBY CERTIFY THAT THE CORNER LOCATION SHOWN ON THIS RECORD WAS DETERMINED BY ME OR UNDER MY DIRECTION AND CONTROL AND THAT THIS U. S. PUBLIC LAND SURVEY MONUMENT RECORD IS CORRECT AND COMPLETE TO THE BEST OF MY KNOWLEDGE AND BELIEF.

William C. Jung
Signature

March 8, 1995
Date

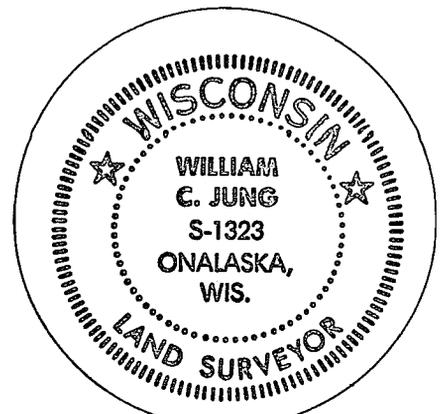

Seal