


U. S. PUBLIC LAND SURVEY MONUMENT RECORD

SECTION 13 T 15 N, R 6 W, TOWN OF GREENFIELD/WASHINGTON

LA CROSSE COUNTY

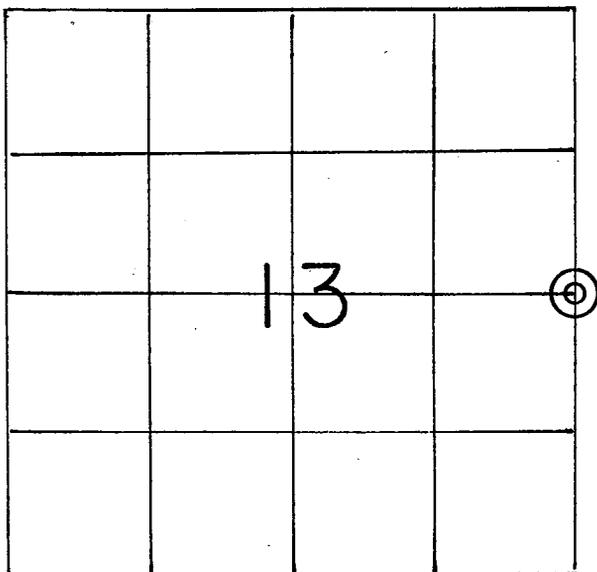

LOCATION OF LANDMARK

WISCONSIN COORDINATE SYSTEM
North
East
Theta Angle
Horiz. Order
Vert. Order
TYPE OF LANDMARK
2-3/8" Iron Pipe over 1" Iron Pipe.
BEARINGS ARE REFERENCED TO
True

Crew: WILLIAM C. JUNG
 PETER F. FOLLANSBEE

Date: 8/17/1994

Describe any record evidence, monument evidence, testimonial evidence or any other material evidence you considered and whether the monument was found or restored through acceptance of an obliterated evidence location.

I reconstructed the location of the old occupied corner, accepted it as the best available evidence of the original government corner, and monumented it with an iron pipe. Mr. Hilby said that there used to be a fence corner here. It was probably destroyed when the erosion dam was constructed.

Describe or show any material discrepancy between the location of the restored corner and that of the corner previously restored or reestablished.

This does not agree with Berg's computed corner location.

