


U. S. PUBLIC LAND SURVEY MONUMENT RECORD

SECTION 13 T 15 N, R 6 W, TOWN OF GREENFIELD

LA CROSSE COUNTY

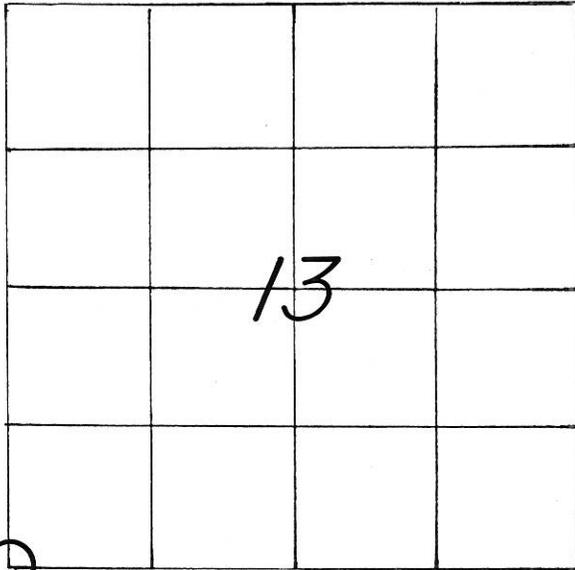

LOCATION OF LANDMARK

CREW: **BRYAN H. MEYER**  
**PETER F. FOLLANSBEE**  
 DATE: **8/19/2009**


WISCONSIN COORDINATE SYSTEM	
North	<b>646,355.799</b>
East	<b>1,690,836.590</b>
Theta Angle	
Horiz. Order	
Vert. Order	
DATUM:	<b>NAD 1983('91)</b>
TYPE OF LANDMARK	
<b>1-3/4" IRON PIPE.</b>	
BEARINGS ARE REFERENCED TO	
<b>GRID NORTH AS PER SECTION DATA.</b>	

Describe any record evidence, monument evidence, testimonial evidence or any other material evidence you considered and whether the monument was found or restored through acceptance of an obliterated evidence location.


Describe or show any material discrepancy between the location of the restored corner and that of the corner previously restored or reestablished.

RECORD OF DURABLE WITNESS MONUMENTS

NO	DESCRIPTION	BEARING	DISTANCE
1	SET A 3/4"x30" IRON BAR 6' NORTH OF PAVEMENT	N.'WESTERLY ±	49.05 FT.
2	SET A 3/4"x30" IRON BAR 6' NORTH OF PAVEMENT	NORTHERLY ±	37.93 FT.
3	SET A 3/4"x30" IRON BAR 6' NORTH OF PAVEMENT	N.'EASTERLY ±	47.64 FT.
4	EX. P.K. NAIL IN THE CENTERLINE OF THE ROAD	NORTH ±	20.44 FT.

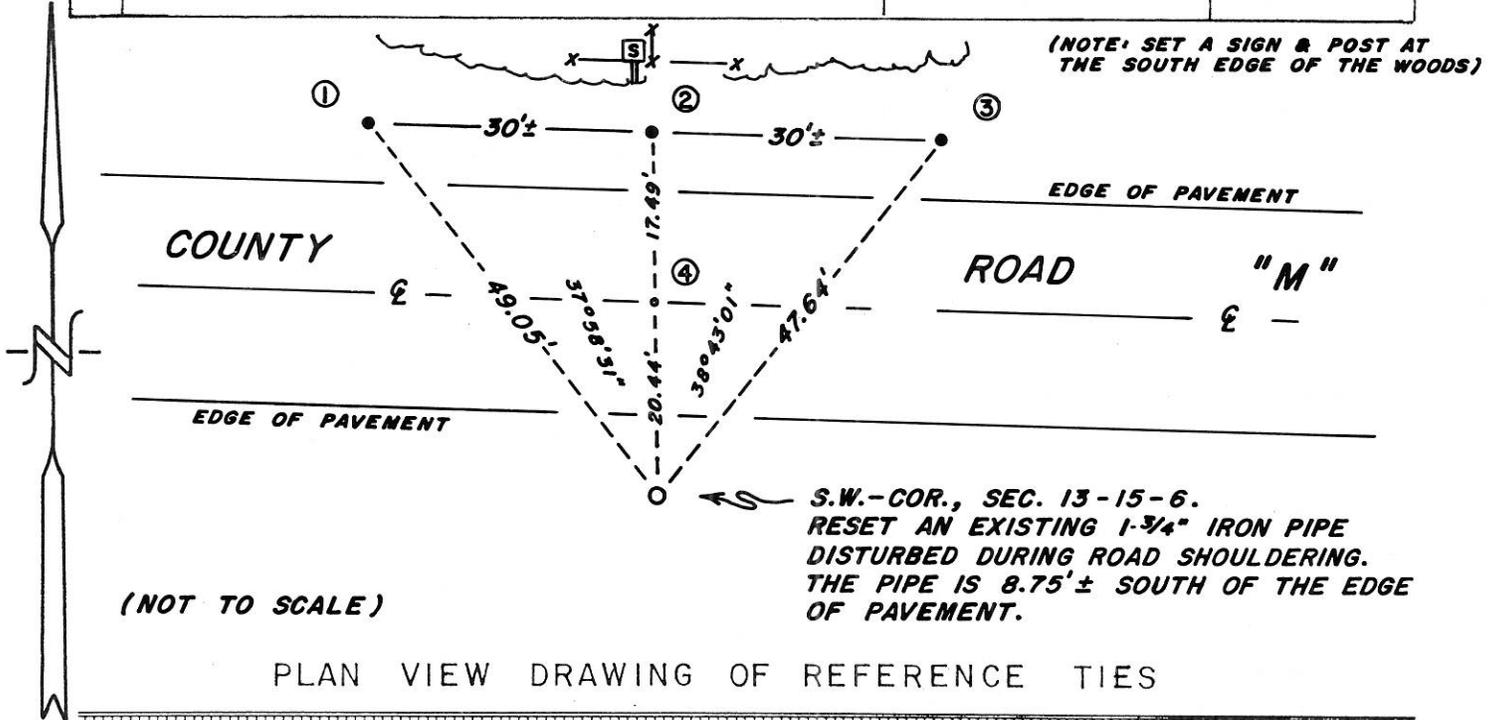

MAP SHOWING DISTANCE AND DIRECTION TO OTHER PUBLIC LAND SURVEY CORNERS USED FOR REESTABLISHING THE CORNER

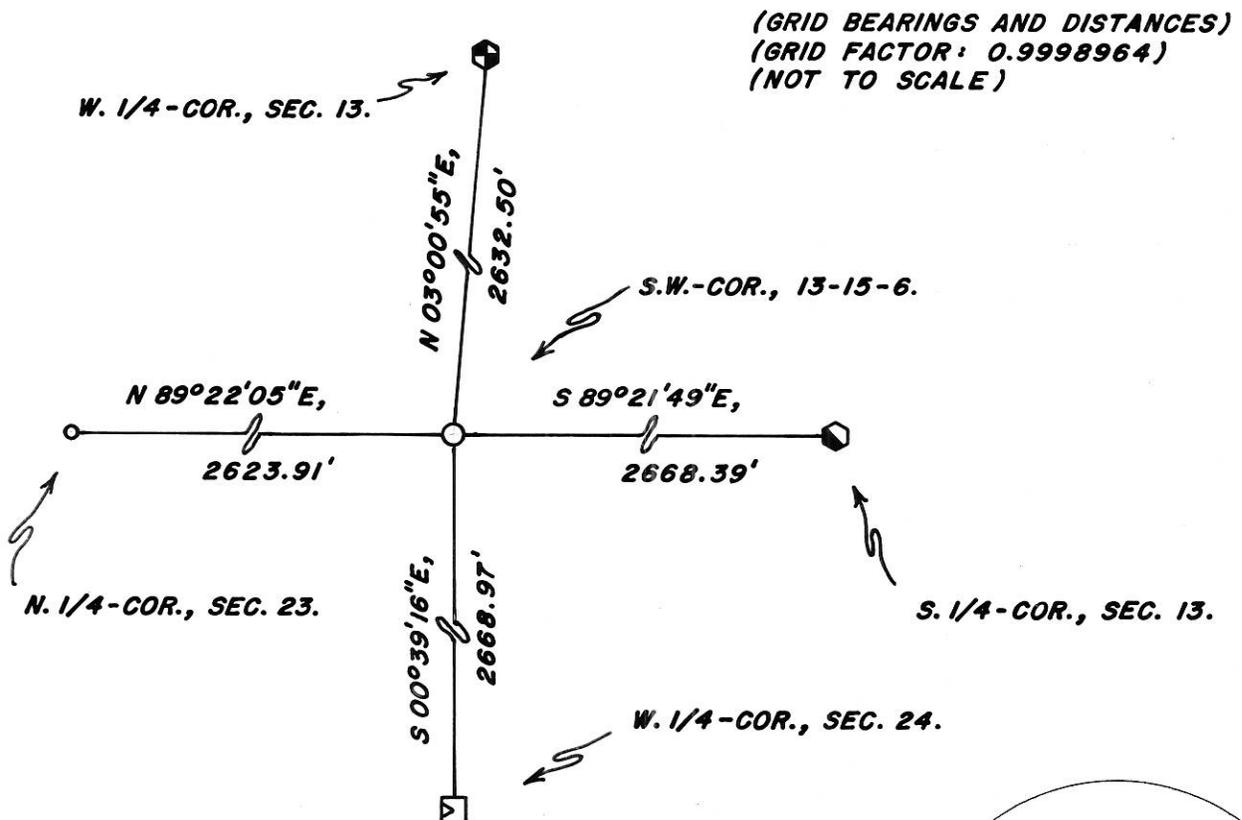

I, BRYAN H. MEYER, COUNTY SURVEYOR  
HEREBY CERTIFY THAT THE CORNER LOCATION SHOWN ON THIS RECORD WAS DETERMINED BY ME OR UNDER MY DIRECTION AND CONTROL AND THAT THIS U. S. PUBLIC LAND SURVEY MONUMENT RECORD IS CORRECT AND COMPLETE TO THE BEST OF MY KNOWLEDGE AND BELIEF.

Bryan H. Meyer Signature 8/28/2009 Date




Seal

21506140000

U. S. PUBLIC LAND SURVEY MONUMENT RECORD

SECTION 13 T 15 N, R 6 W, TOWN OF GREENFIELD  
 LA CROSSE COUNTY

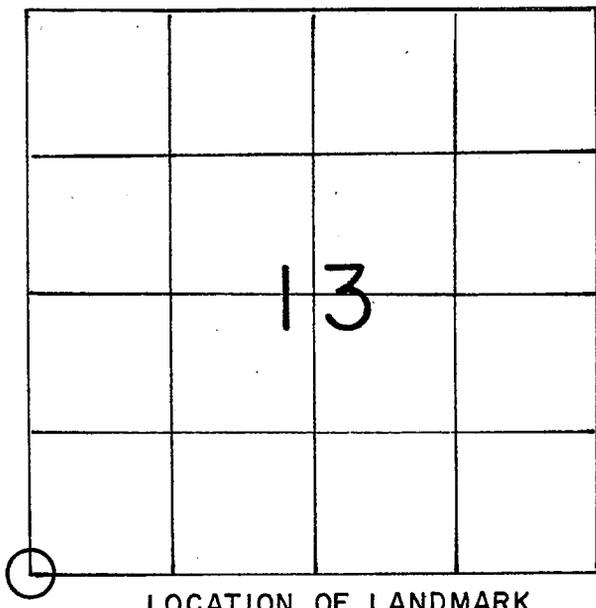

LOCATION OF LANDMARK

WISCONSIN COORDINATE SYSTEM
North
East
Theta Angle
Horiz. Order
Vert. Order
TYPE OF LANDMARK
Existing 1-3/4" Iron Pipe.
BEARINGS ARE REFERENCED TO

Crew: WILLIAM C. JUNG  
 PETER F. FOLLANSBEE

Date: 6/13/1994

Describe any record evidence, monument evidence, testimonial evidence or any other material evidence you considered and whether the monument was found or restored through acceptance of an obliterated evidence location.

In June of 1980 Dick Berg set an iron pipe at this corner. I accepted Berg's pipe as the best available evidence of the original government corner position. After going over Berg's section data, I agree with his computed location. North of the road up in the woods is an old North-South line fence also.

Describe or show any material discrepancy between the location of the restored corner and that of the corner previously restored or reestablished.

None Known.

