


21506140020

U. S. PUBLIC LAND SURVEY MONUMENT RECORD

SECTION 14 T 15 N, R 6 W, TOWN OF Greenfield

LA CROSSE COUNTY

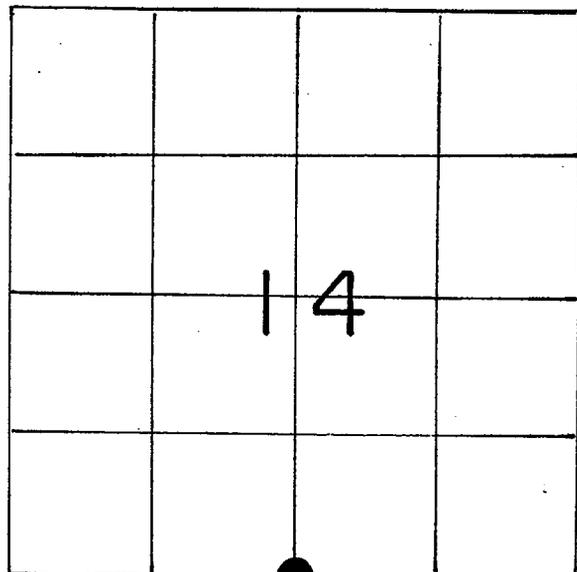

LOCATION OF LANDMARK

WISCONSIN COORDINATE SYSTEM

North

East

Theta Angle

Horiz. Order

Vert. Order

TYPE OF LANDMARK

1" iron pipe

BEARINGS ARE REFERENCED TO

True

Crew: William C. Jung
Peter F. Follansbee

Date: July 12, 1990

Describe any record evidence, monument evidence, testimonial evidence or any other material evidence you considered and whether the monument was found or restored through acceptance of an obliterated evidence location.


I accepted the occupied corner as the best available evidence of the original government corner position and monumented the corner with an iron pipe. The corner falls on a slope. I found the rotted remains of a hub at or close to this location. It was probably Berg's survey point.

Describe or show any material discrepancy between the location of the restored corner and that of the corner previously restored or reestablished.


The actual fence corner is at the top of the slope but does not fall at the intersection of the projected fences.

RECORD OF DURABLE WITNESS MONUMENTS

NO	DESCRIPTION	BEARING	DISTANCE
1	P.K. nail in single blazed 7" hackberry	-----	56.53
2	Set a 1" iron pipe	-----	21.63
3	Set a liquor bottle with a blank cartridge casing in it buried under a rock	-----	19.25
4	Set a 1" iron pipe under a pasture fence	-----	slope= 59.37

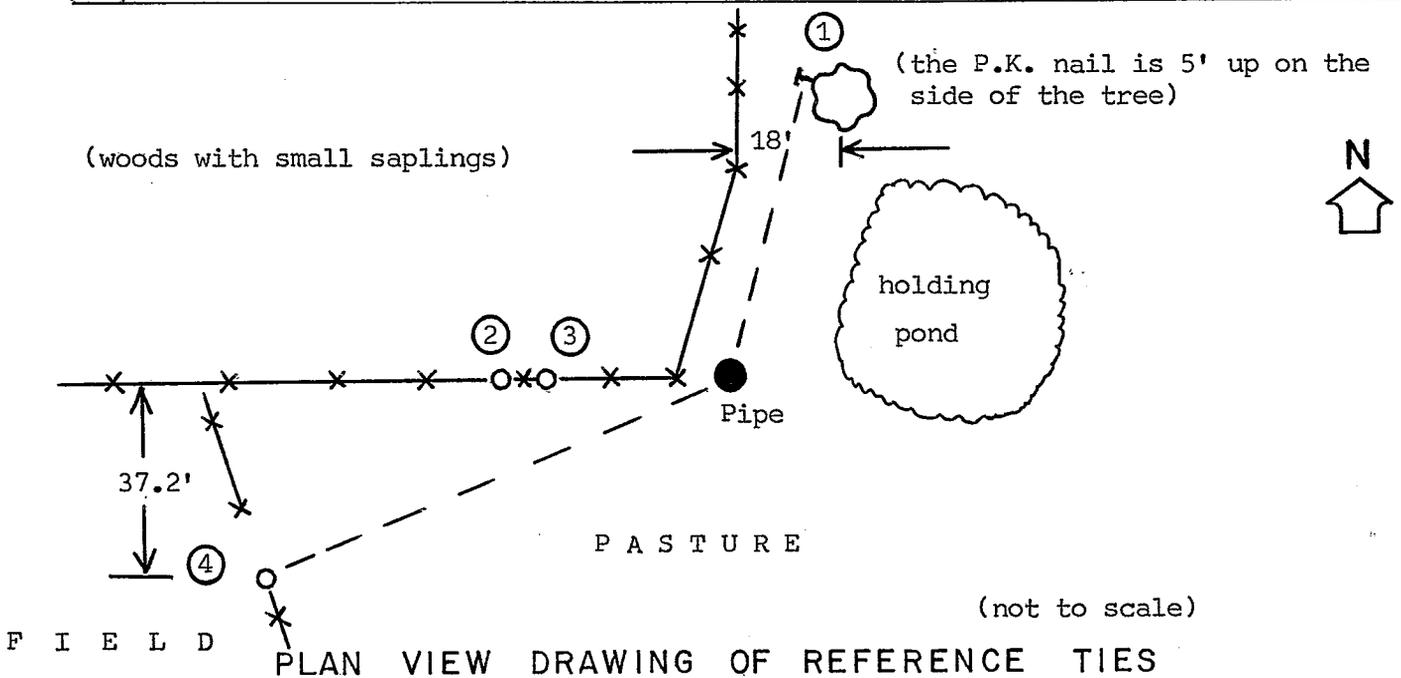


MAP SHOWING DISTANCE AND DIRECTION TO OTHER PUBLIC LAND SURVEY CORNERS USED FOR REESTABLISHING THE CORNER

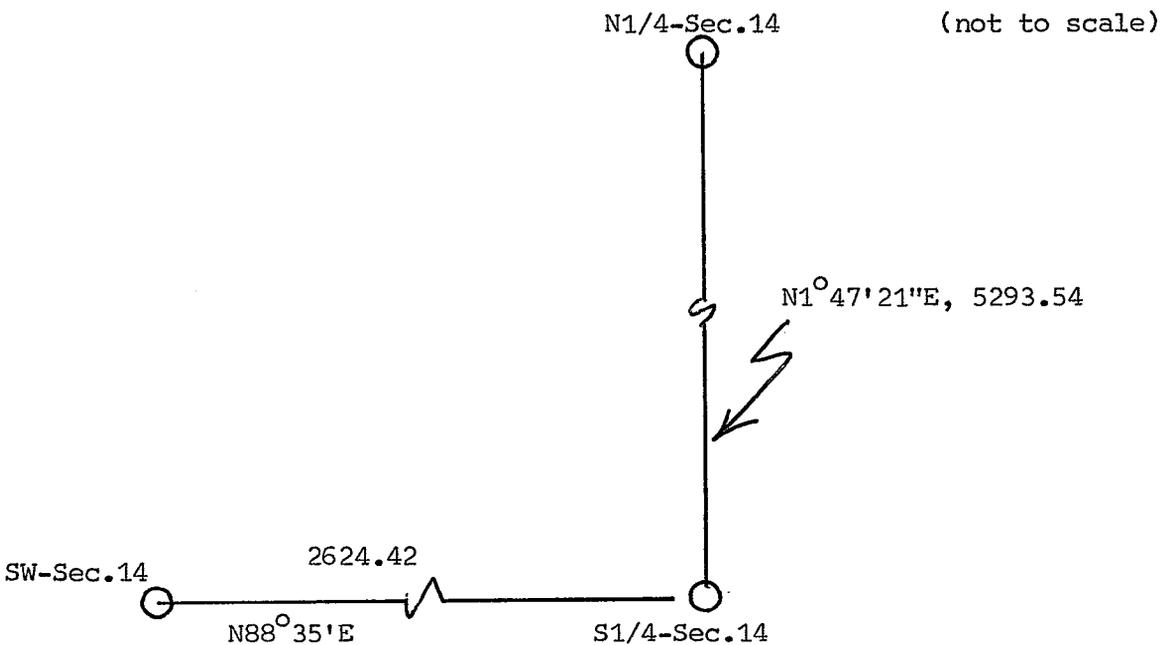

I, William C. Jung, Deputy County Surveyor,
 HEREBY CERTIFY THAT THE CORNER LOCATION SHOWN ON THIS RECORD
 WAS DETERMINED BY ME OR UNDER MY DIRECTION AND CONTROL AND
 THAT THIS U. S. PUBLIC LAND SURVEY MONUMENT RECORD IS CORRECT
 AND COMPLETE TO THE BEST OF MY KNOWLEDGE AND BELIEF.

William C. Jung January 7, 1991
 Signature Date

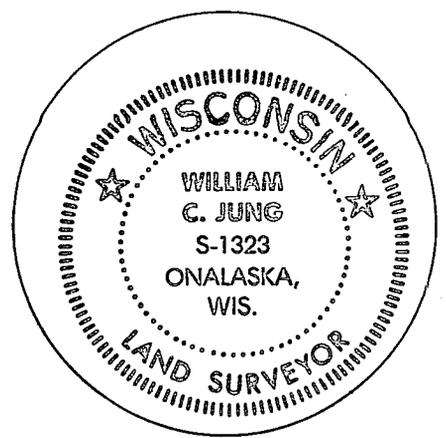

Seal