


## U. S. PUBLIC LAND SURVEY MONUMENT RECORD

SECTION 14 T 15 N, R 6 W, TOWN OF Greenfield

LA CROSSE COUNTY

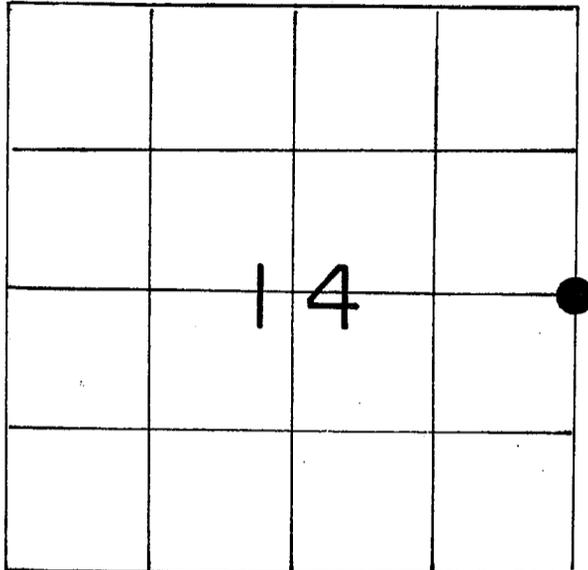

LOCATION OF LANDMARK

## WISCONSIN COORDINATE SYSTEM

North

East

Theta Angle

Horiz. Order

Vert. Order

## TYPE OF LANDMARK

Brass capped Lunde marker

## BEARINGS ARE REFERENCED TO

True

Crew: William C. Jung  
Peter F. Follansbee

Date: September 17, 1990

Describe any record evidence, monument evidence, testimonial evidence or any other material evidence you considered and whether the monument was found or restored through acceptance of an obliterated evidence location.


I intersected the section line (as established by Berg in Section 13) with the existing East-West 1/4 line fence and monumented the corner with a Lunde marker.

Describe or show any material discrepancy between the location of the restored corner and that of the corner previously restored or reestablished.

This does not quite fit Berg's computed location nor does it probably fit Chalsma's corner. I have no idea what Chalsma used for a corner.


RECORD OF DURABLE WITNESS MONUMENTS

NO	DESCRIPTION	BEARING	DISTANCE
1	Set a 1 1/4" iron pipe on the E. side of a stone	-----	23.63
2	Buried a 1" iron pipe in the field	-----	32.35
3	P.K. nail, up 3' at waist level, in a double blazed 6" birch	Magnetic --N12°W	slope=109.6
4	Buried a "peeled over" 1 1/4" iron pipe	-----	32.98

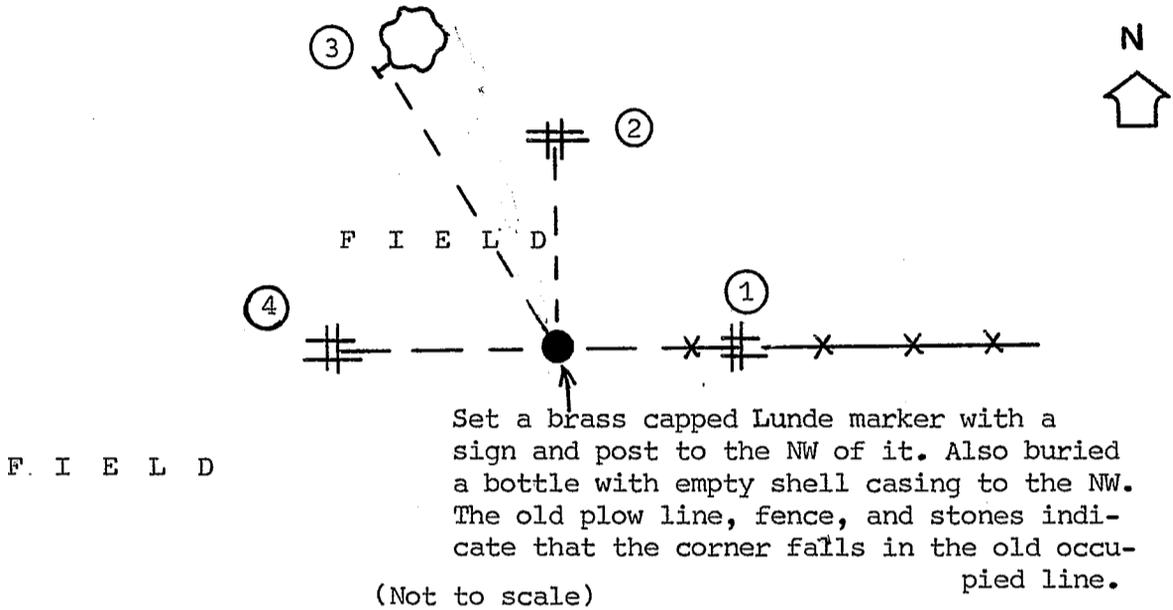

PLAN VIEW DRAWING OF REFERENCE TIES

MAP SHOWING DISTANCE AND DIRECTION TO OTHER PUBLIC LAND SURVEY CORNERS USED FOR REESTABLISHING THE CORNER

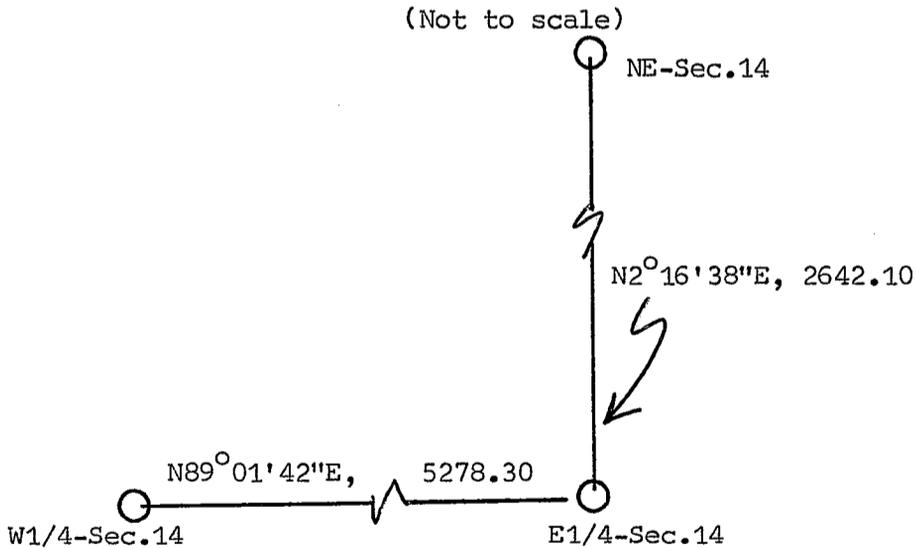

I, William C. Jung, Deputy County Surveyor,  
 HEREBY CERTIFY THAT THE CORNER LOCATION SHOWN ON THIS RECORD  
 WAS DETERMINED BY ME OR UNDER MY DIRECTION AND CONTROL AND  
 THAT THIS U. S. PUBLIC LAND SURVEY MONUMENT RECORD IS CORRECT  
 AND COMPLETE TO THE BEST OF MY KNOWLEDGE AND BELIEF.

William C. Jung  
 Signature

January 7, 1991  
 Date



Seal