


U. S. PUBLIC LAND SURVEY MONUMENT RECORD

SECTION 14 T 15 N, R 6 W, TOWN OF Greenfield  
 LA CROSSE COUNTY

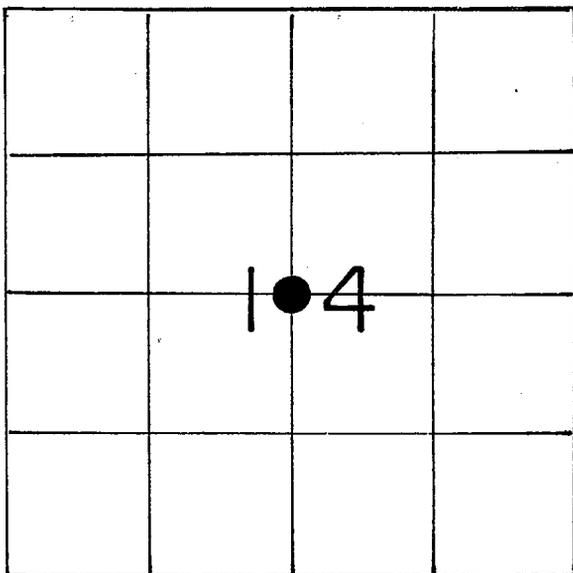

LOCATION OF LANDMARK

WISCONSIN COORDINATE SYSTEM
North
East
Theta Angle
Horiz. Order
Vert. Order
TYPE OF LANDMARK
Set 1 1/4" x 30" Iron Bar
BEARINGS ARE REFERENCED TO True

Crew: WILLIAM C. JUNG  
 PETER F. FOLLANSBEE

Date: 6/25/1991

Describe any record evidence, monument evidence, testimonial evidence or any other material evidence you considered and whether the monument was found or restored through acceptance of an obliterated evidence location.


I set the corner "by law" at the intersection of the 1/4 lines.

Describe or show any material discrepancy between the location of the restored corner and that of the corner previously restored or reestablished.

I do not agree with Chalsma's iron pipe to the Southwest.

RECORD OF DURABLE WITNESS MONUMENTS  
MAGNETIC


NO	DESCRIPTION	BEARING	DISTANCE
1	Set P.K. Nail in 12" trunk of dbl. Hickory	10.5' W. of fnc.	20.90'
2	Set P.K. Nail in SW-side 7" Basswood	11.7' W. of fnc.	17.31'
3	Set P.K. Nail in N-side 18" Hickory	S 52° W	4.59'
4	Existing Iron Pipe	S 17.5° W	7.20'

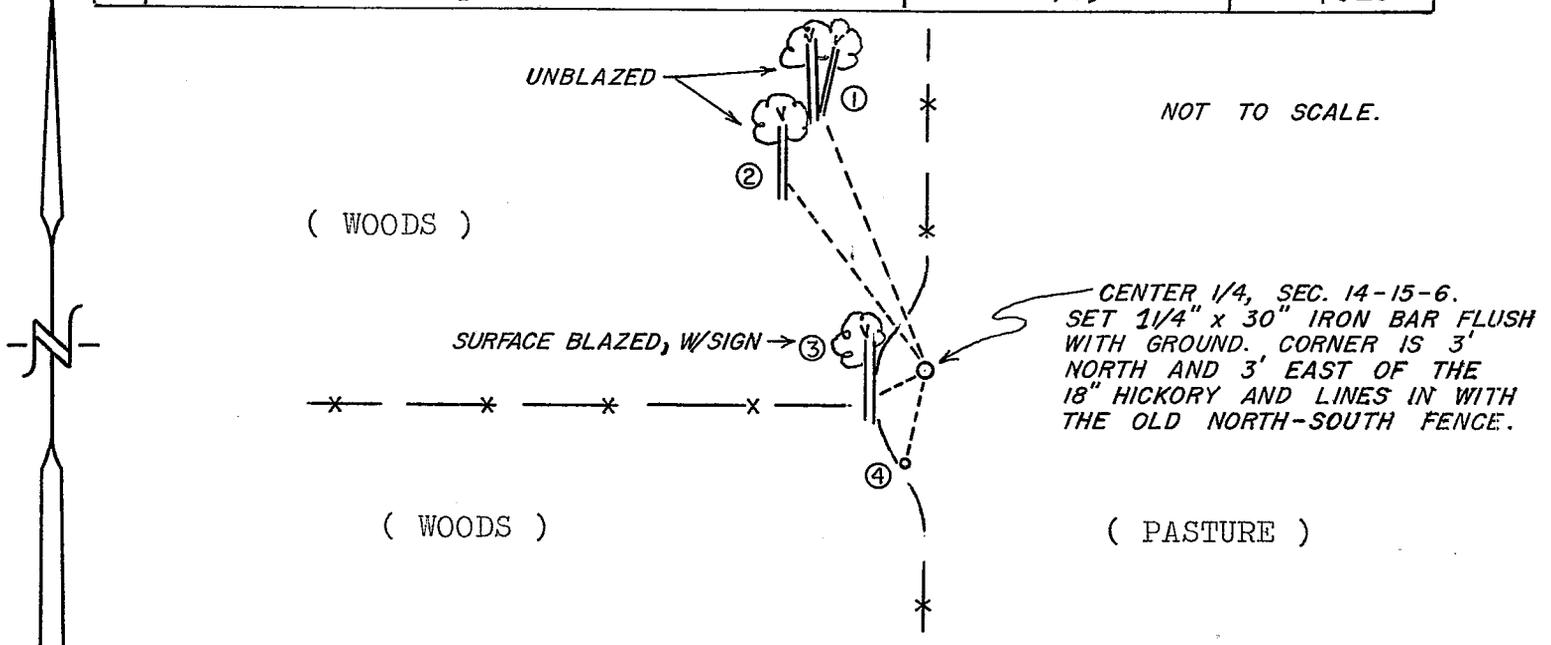

PLAN VIEW DRAWING OF REFERENCE TIES

MAP SHOWING DISTANCE AND DIRECTION TO OTHER PUBLIC LAND SURVEY CORNERS USED FOR REESTABLISHING THE CORNER

(not to scale)

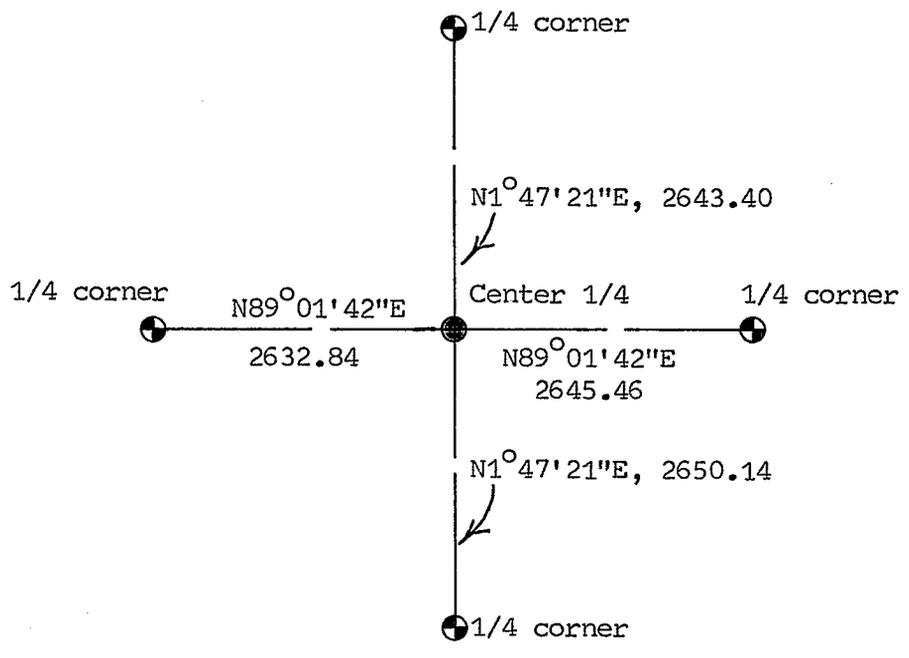

I, William C. Jung, Deputy County Surveyor  
HEREBY CERTIFY THAT THE CORNER LOCATION SHOWN ON THIS RECORD  
WAS DETERMINED BY ME OR UNDER MY DIRECTION AND CONTROL AND  
THAT THIS U. S. PUBLIC LAND SURVEY MONUMENT RECORD IS CORRECT  
AND COMPLETE TO THE BEST OF MY KNOWLEDGE AND BELIEF.

William C. Jung  
Signature

November 5, 1991  
Date



Seal