


21506150000

## U. S. PUBLIC LAND SURVEY MONUMENT RECORD

SECTION 14 T 15 N, R 6 W, TOWN OF Greenfield

LA CROSSE COUNTY

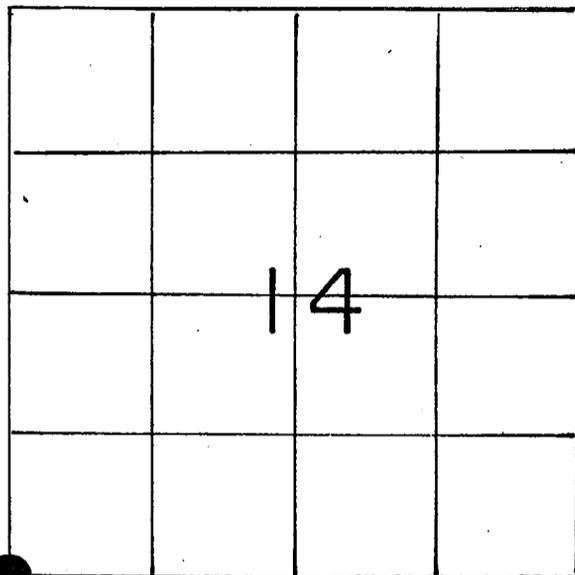

LOCATION OF LANDMARK

Crew: William C. Jung  
Peter F. Follansbee

Date: July 11, 1990

Describe any record evidence, monument evidence, testimonial evidence or any other material evidence you considered and whether the monument was found or restored through acceptance of an obliterated evidence location.

I accepted the occupied fence corner as the best available evidence of the original government corner position and monumented it with a brass capped Lunde marker. I believe that this position was used in other surveys but I could not find evidence of a hub, etc. I buried a bottle with a brass blank to the South of the Lunde.

Describe or show any material discrepancy between the location of the restored corner and that of the corner previously restored or reestablished.

None known.

## WISCONSIN COORDINATE SYSTEM

North

East

Theta Angle

Horiz. Order

Vert. Order

## TYPE OF LANDMARK


Brass capped Lunde marker

## BEARINGS ARE REFERENCED TO


True

RECORD OF DURABLE WITNESS MONUMENTS

NO	DESCRIPTION	BEARING	DISTANCE
1	Set a 1" iron pipe	-----	32.66
2	P.K. nail in power pole	-----	44.51
3	P.K. nail in double blazed 3" hickory	-----	21.94
4	Set a 2½" iron pipe in a rock mound	-----	25.29

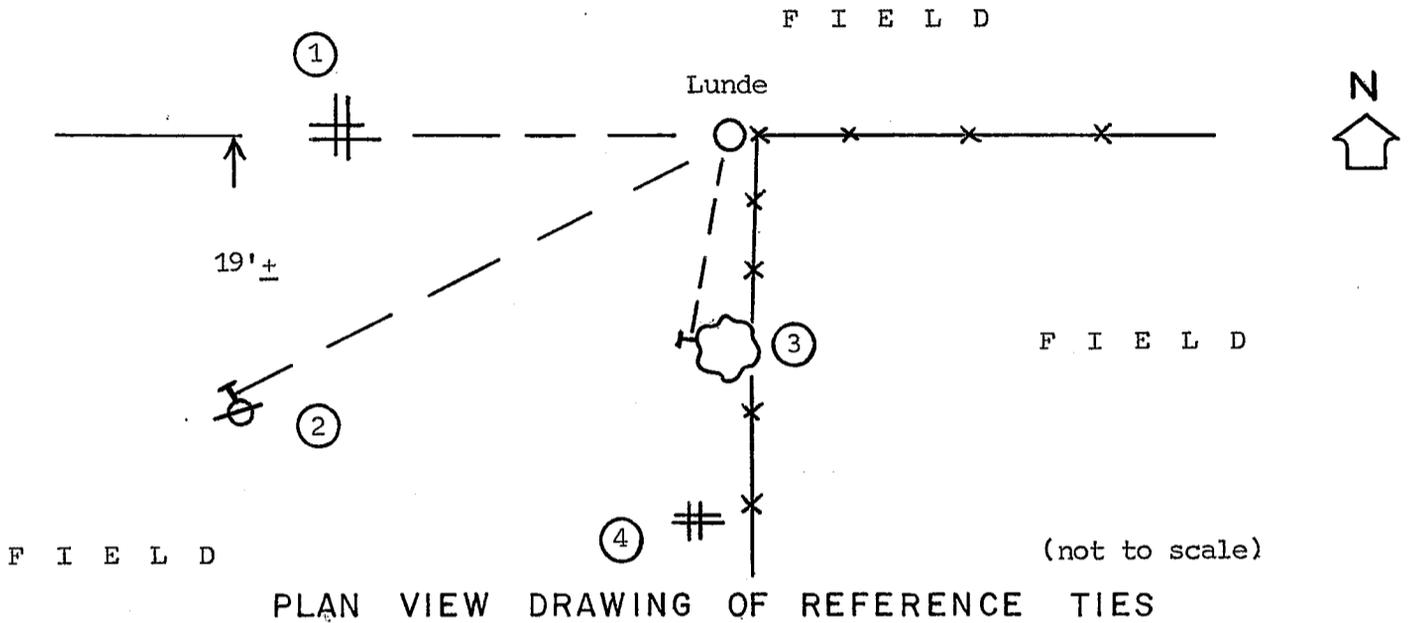

MAP SHOWING DISTANCE AND DIRECTION TO OTHER PUBLIC LAND SURVEY CORNERS USED FOR REESTABLISHING THE CORNER

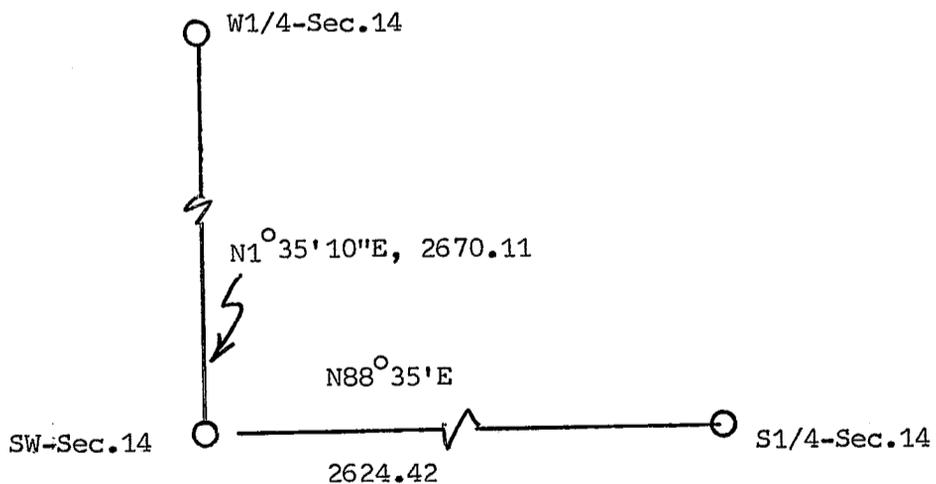

(not to scale)

I, William C. Jung, Deputy County Surveyor,  
 HEREBY CERTIFY THAT THE CORNER LOCATION SHOWN ON THIS RECORD  
 WAS DETERMINED BY ME OR UNDER MY DIRECTION AND CONTROL AND  
 THAT THIS U. S. PUBLIC LAND SURVEY MONUMENT RECORD IS CORRECT  
 AND COMPLETE TO THE BEST OF MY KNOWLEDGE AND BELIEF.

William C. Jung January 4, 1991  
 Signature Date



Seal