


U. S. PUBLIC LAND SURVEY MONUMENT RECORD

SECTION 22 T 15 N, R 6 W, TOWN OF Greenfield

LA CROSSE COUNTY

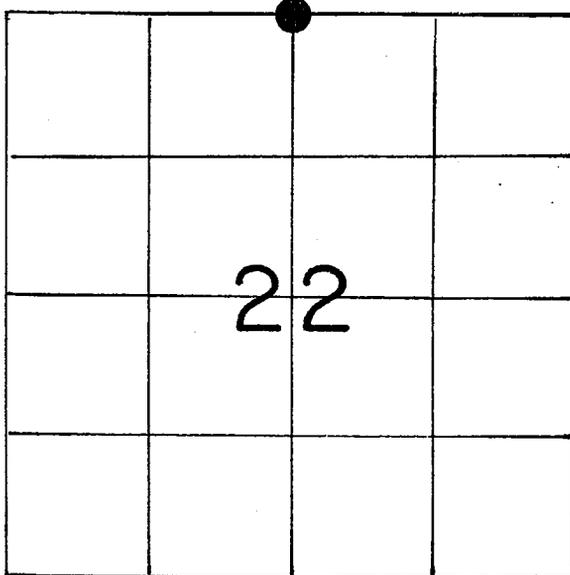

LOCATION OF LANDMARK

Crew: William C. Jung
Peter F. Follansbee

Date: March 21, 1994

Describe any record evidence, monument evidence, testimonial evidence or any other material evidence you considered and whether the monument was found or restored through acceptance of an obliterated evidence location.

I calculated the occupied position of this corner which falls in a very deep gully. It lines up with a straight line fence to the North and the extension West of the line fence along the North line of the NE1/4. The actual corner could not be monumented so I set iron pipes as witness corners to the North and South of the actual 1/4 corner. Ralph Schultz, a landowner to the South, said that his father told him that the corner was in the gully. I agree. Describe or show any material discrepancy between the location of the restored corner and that of the corner previously restored or reestablished.

None known.

WISCONSIN COORDINATE SYSTEM

North

East

Theta Angle

Horiz. Order

Vert. Order

TYPE OF LANDMARK

witness corners North and South


BEARINGS ARE REFERENCED TO

True

RECORD OF DURABLE WITNESS MONUMENTS


MAGNETIC

NO	DESCRIPTION	BEARING	DISTANCE
1	Set 1 1/4" x 28" witness pipe between brace posts.	N 03° E ±	41.12 Ft.
2	Set 1" witness pipe on south bank of ravine.	S 03° W ±	48.67 Ft.
3			
4			

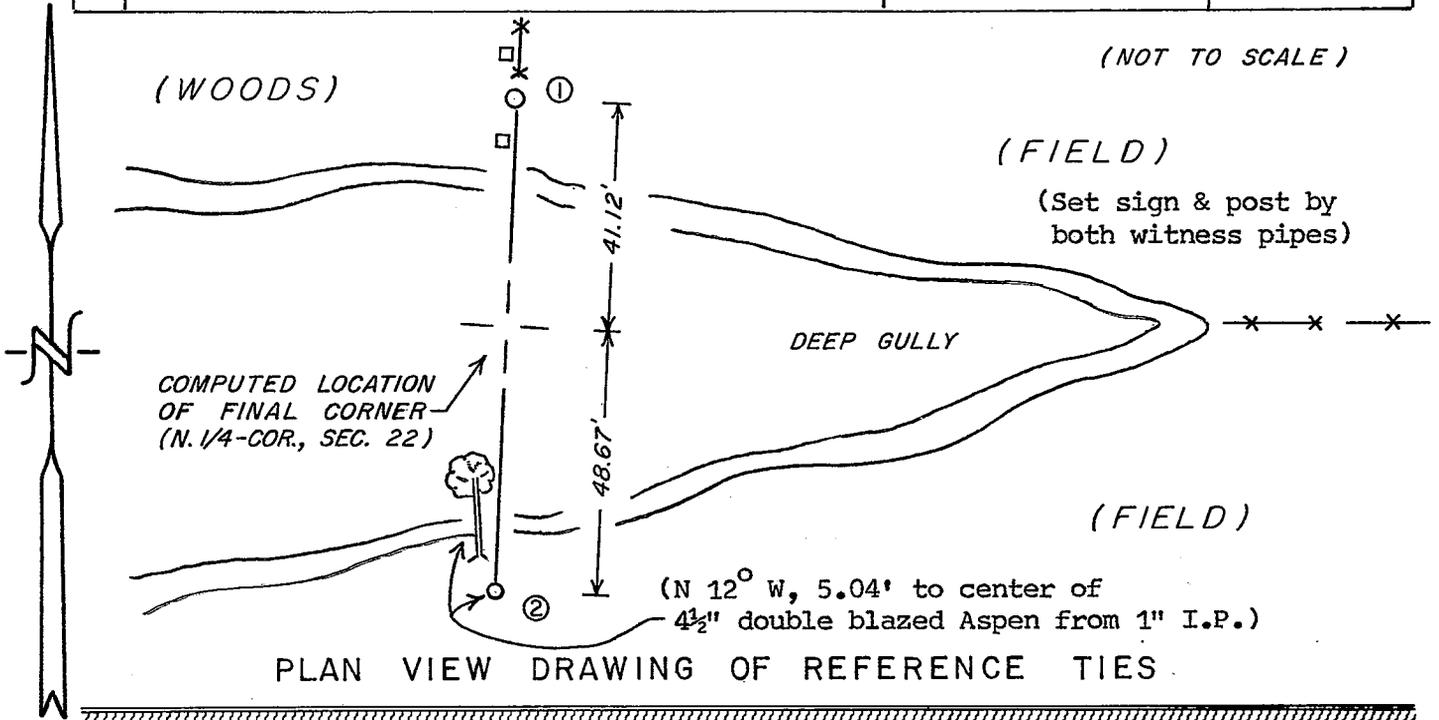

MAP SHOWING DISTANCE AND DIRECTION TO OTHER PUBLIC LAND SURVEY CORNERS USED FOR REESTABLISHING THE CORNER


(not to scale)

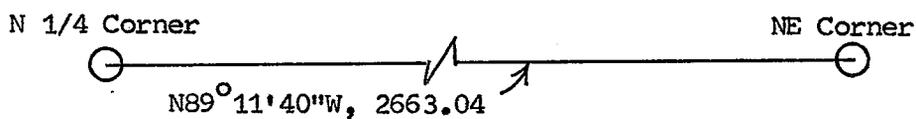

I, William C. Jung, County Surveyor,
 HEREBY CERTIFY THAT THE CORNER LOCATION SHOWN ON THIS RECORD
 WAS DETERMINED BY ME OR UNDER MY DIRECTION AND CONTROL AND
 THAT THIS U. S. PUBLIC LAND SURVEY MONUMENT RECORD IS CORRECT
 AND COMPLETE TO THE BEST OF MY KNOWLEDGE AND BELIEF.

William C. Jung
 Signature

April 25, 1994
 Date

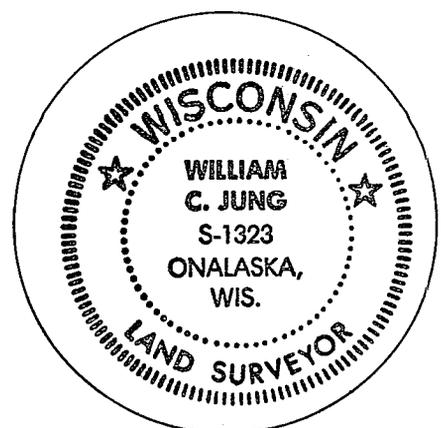

Seal