


21506162000

U. S. PUBLIC LAND SURVEY MONUMENT RECORD

SECTION 16 T 15 N, R 6 W, TOWN OF GREENFIELD  
LA CROSSE COUNTY

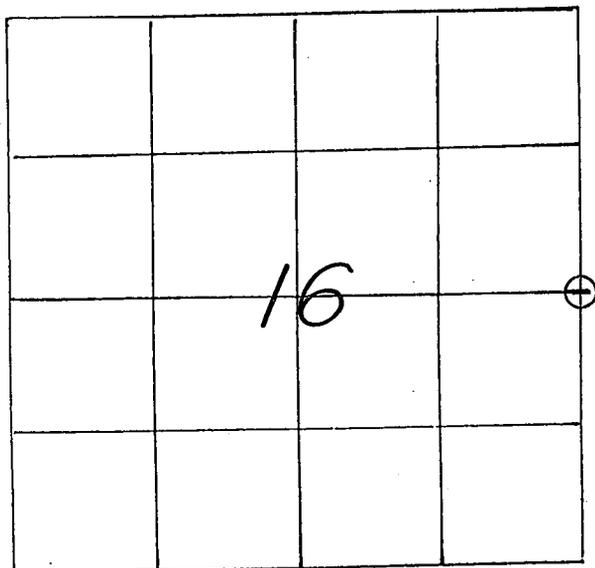

WISCONSIN COORDINATE SYSTEM
North
East
Theta Angle
Horiz. Order
Vert. Order

TYPE OF LANDMARK  
I.B. witness point set 41' West of Cor.

BEARINGS ARE REFERENCED TO  
*ASSUMED NORTH.*

LOCATION OF LANDMARK

CREW: WILLIAM C. JUNG  
PETER F. FOLLANSBEE  
DATE: 3/30/1999.

Describe any record evidence, monument evidence, testimonial evidence or any other material evidence you considered and whether the monument was found or restored through acceptance of an obliterated evidence location.


I computed a location for this corner at a point where the East line of the section intersects an East-West 1/4 line that Dick Walter and I had agreed on previously. The corner falls in a garden. I did not monument it at this time, but I did set an iron bar on the 1/4 line 41 feet West of the corner.

Describe or show any material discrepancy between the location of the restored corner and that of the corner previously restored or reestablished.


There appears to be an unrecorded survey East of the corner. How I would fit the section line of that survey is uncertain.

RECORD OF DURABLE WITNESS MONUMENTS

NO	DESCRIPTION	BEARING	DISTANCE
1	"SEE SKETCH BELOW" (NOT TO SCALE)		
2			
3			
4			

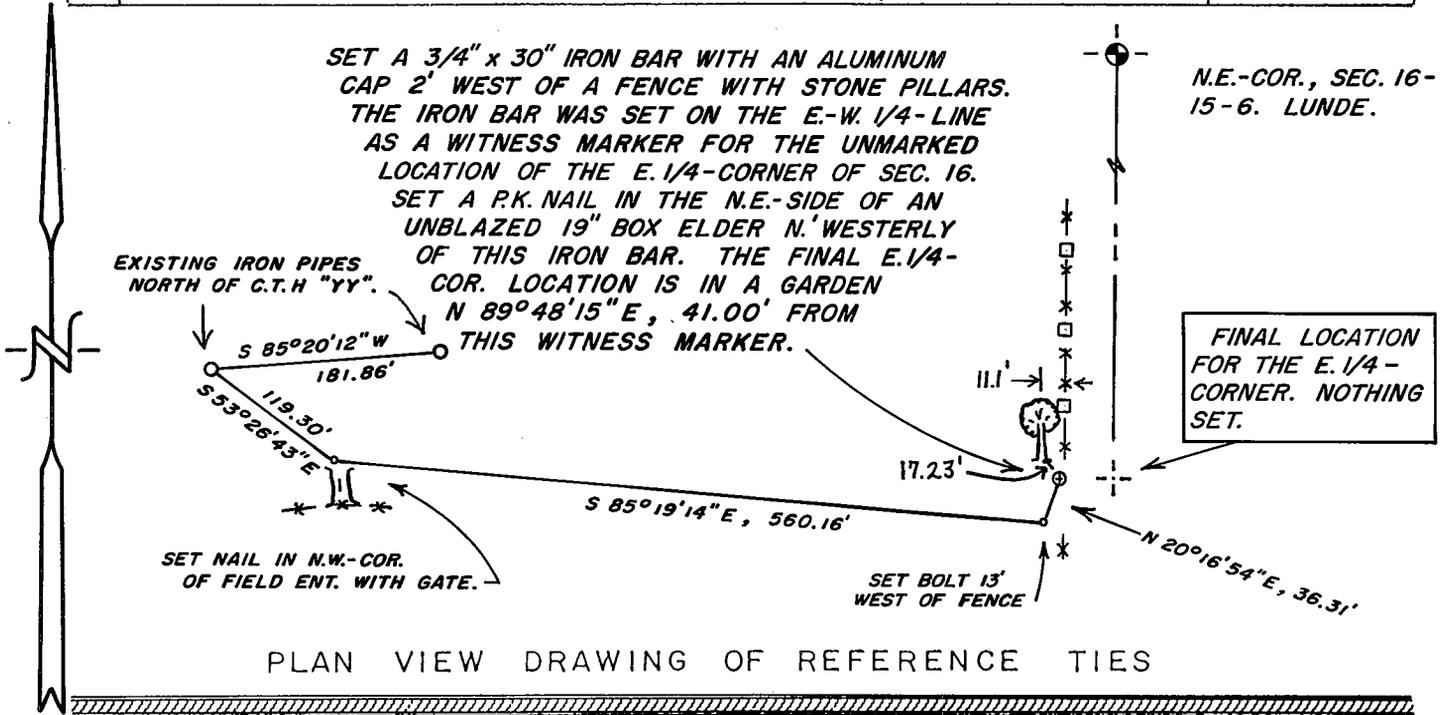

MAP SHOWING DISTANCE AND DIRECTION TO OTHER PUBLIC LAND SURVEY CORNERS USED FOR REESTABLISHING THE CORNER

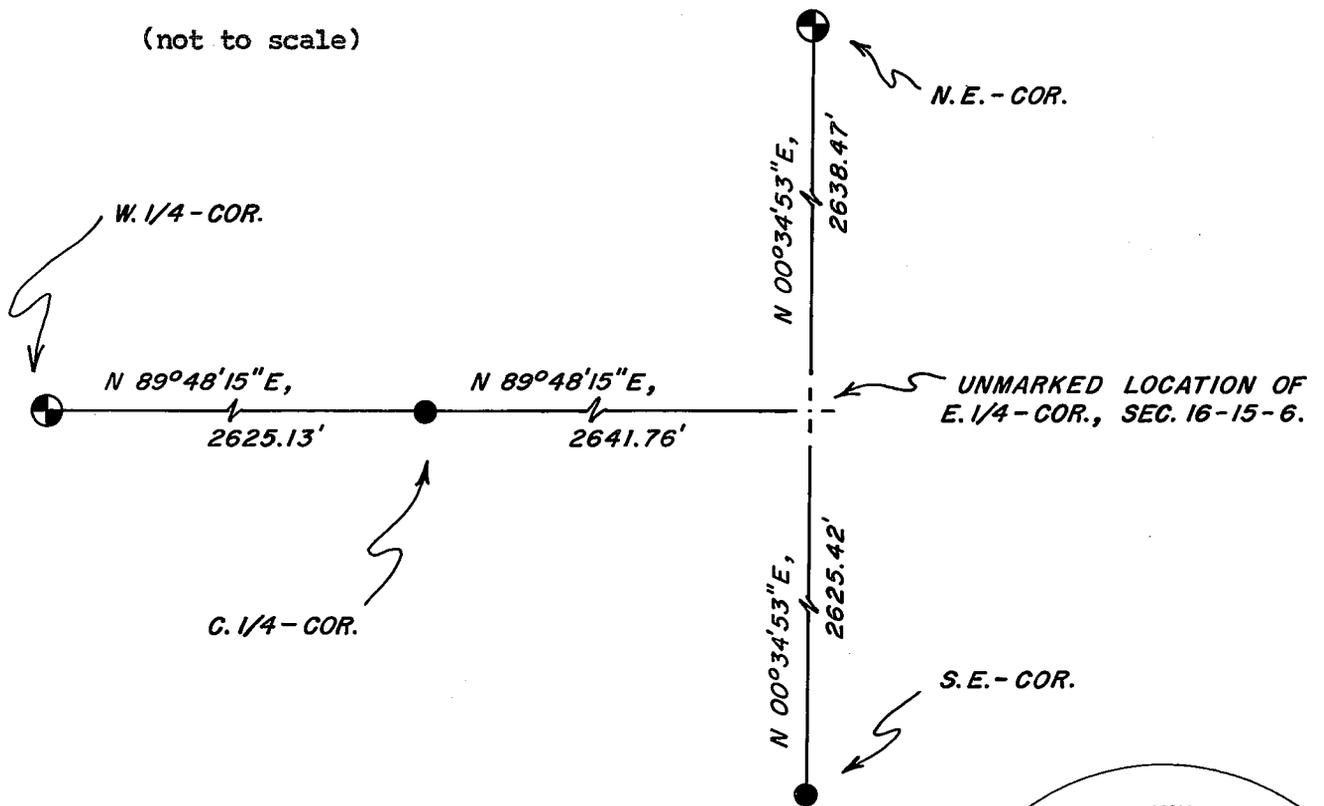

I, WILLIAM C. JUNG, COUNTY SURVEYOR  
 HEREBY CERTIFY THAT THE CORNER LOCATION SHOWN ON THIS RECORD WAS DETERMINED BY ME OR UNDER MY DIRECTION AND CONTROL AND THAT THIS U. S. PUBLIC LAND SURVEY MONUMENT RECORD IS CORRECT AND COMPLETE TO THE BEST OF MY KNOWLEDGE AND BELIEF.

William C. Jung 5/21/99  
 Signature Date

