


## U. S. PUBLIC LAND SURVEY MONUMENT RECORD

SECTION 16 T 15 N, R 6 W, TOWN OF GREENFIELD

LA CROSSE COUNTY

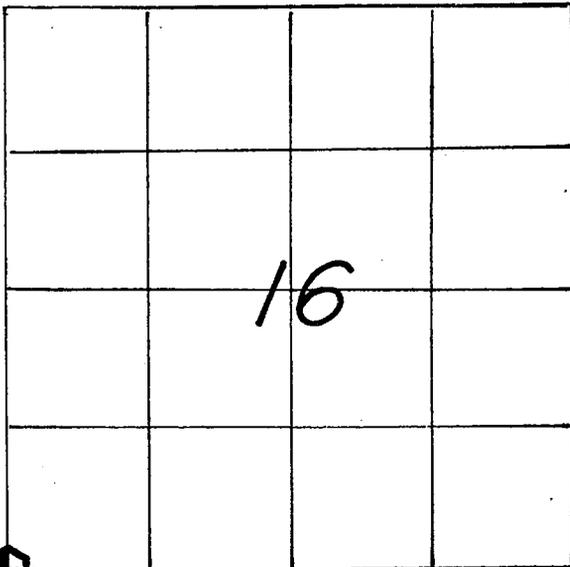

LOCATION OF LANDMARK

Crew: WILLIAM C. JUNG  
 PETER F. FOLLANSBEE  
 Date: 6/27/1996

Describe any record evidence, monument evidence, testimonial evidence or any other material evidence you considered and whether the monument was found or restored through acceptance of an obliterated evidence location.

I found an iron pipe at the corner which had been used as the corner in several previous surveys. I accepted the location of the pipe as the best available evidence of the original government corner position and replaced the pipe with a brass capped Lunde marker.

Describe or show any material discrepancy between the location of the restored corner and that of the corner previously restored or reestablished.

NONE KNOWN.

WISCONSIN COORDINATE SYSTEM

North

East

Theta Angle

Horiz. Order

Vert. Order

TYPE OF LANDMARK

Set brass cap Lunde marker.


BEARINGS ARE REFERENCED TO

RECORD OF DURABLE WITNESS MONUMENTS  
MAGNETIC

NO	DESCRIPTION	BEARING	DISTANCE
1	Ex. Nail in NE-side 13" double Oak	S 56°W	30.36 Ft.
2	Ex. Nail in SW-side 12" Oak	N 34°E	Sl.=16.74'
3	Ex. Nail in NW-side 15" Ash?	S 56°E	19.06 Ft.
4	Ex. Nail in N.-side 5½" Elm	S 17°E	8.46 Ft.

S.W.-Cor., Sec. 16-15-6.  
Set a brass cap Lunde marker in the woods to replace an existing 1½" x 24" iron pipe. Buried a liquor bottle on the SW-side of the marker & set a sign & post to the north. Downed fence wire going north & south approx. 4' west of the marker.

(Note: the 4 Bearing Trees have exist. double blazes.)

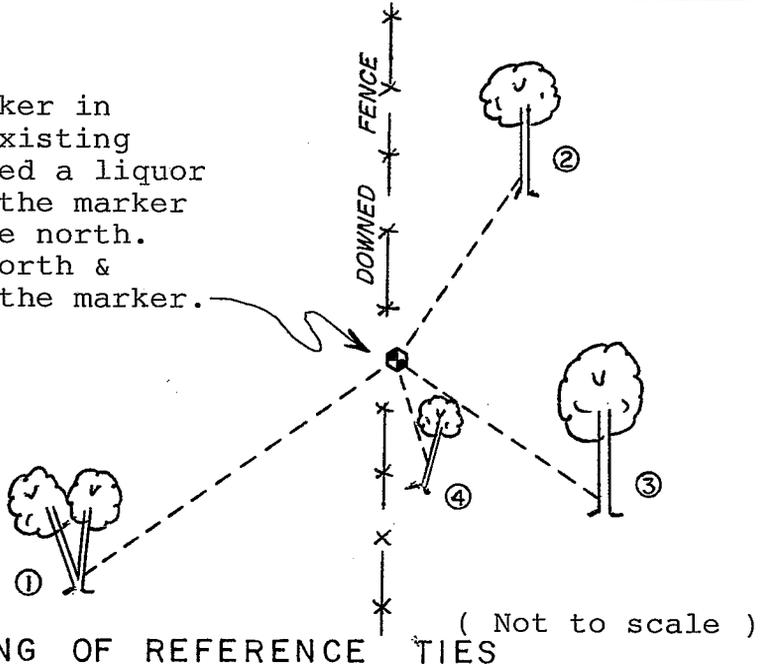

PLAN VIEW DRAWING OF REFERENCE TIES

MAP SHOWING DISTANCE AND DIRECTION TO OTHER PUBLIC LAND SURVEY CORNERS USED FOR REESTABLISHING THE CORNER

No section measurements were made by me at this time. The location of this corner was confirmed through previous survey work.

I, William C. Jung, County Surveyor  
HEREBY CERTIFY THAT THE CORNER LOCATION SHOWN ON THIS RECORD WAS DETERMINED BY ME OR UNDER MY DIRECTION AND CONTROL AND THAT THIS U. S. PUBLIC LAND SURVEY MONUMENT RECORD IS CORRECT AND COMPLETE TO THE BEST OF MY KNOWLEDGE AND BELIEF.

William C. Jung      1/2/97  
Signature      Date



Seal