


---

**U. S. PUBLIC LAND SURVEY MOUMENT RECORD**


---

**SECTION 20, T15N, R6W, TOWN OF GREENFIELD  
LA CROSSE COUNTY, WISCONSIN**

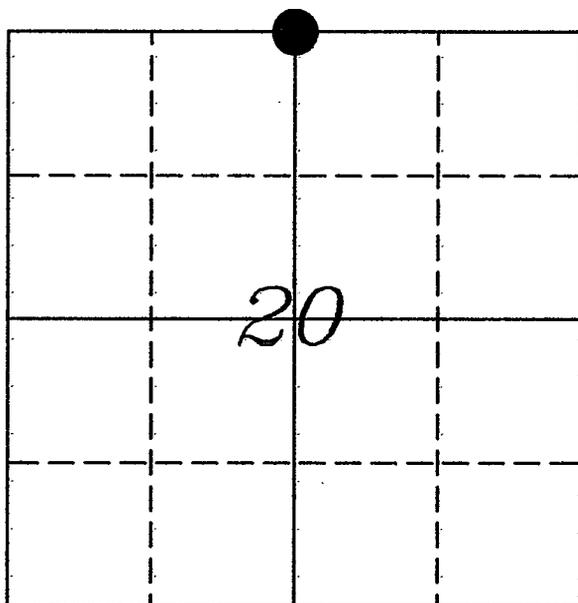

<b>WISCONSIN COORDINATE SYSTEM</b>
<i>Northing</i>
<i>Easting</i>
<i>Elevation</i>
<b>TYPE OF LANDMARK:</b>
Set 1 1/4" Iron Rod
<b>BEARINGS ARE REFERENCED TO:</b>
Assumed

**LOCATION OF LANDMARK**

**Crew:** Stephen J Solberg  
Laurence E Johns III  
Larry Handschy

**Date:** 30 January 2006

---


*Describe any record evidence, monument evidence, testimonial evidence or any other material evidence you considered and whether the monument was found or restored through acceptance of an obliterated evidence location.*

Corner was set by single proportionate method. The location of this monument is consistent with the way Section 17 to the North has been subdivided for years. A 2" iron pipe was found 15 feet to the West at the approximate intersection of two fences. However nothing is known about the origin of this pipe. It was apparently not found when Section 17 was subdivided in 1994, therefore we set the corner at the calculated midpoint of the North section line.

---


*Describe or show any material discrepancy between the location of the restored corner and that of the corner previously restored or re-established.*

No record of corner being restored since original government survey.

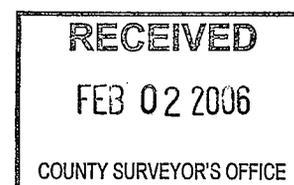


## RECORD OF DURABLE WITNESS MONUMENTS

NO	DESCRIPTION	BEARING	DISTANCE
1	6" White Oak	N 44°05'39" W	27.43'
2	8" Hickory	N 84°36'21" E	38.52'
3	Triple Oak / Largest Trunk - 20"	S 00°55'36" W	39.56'
4	16" White Oak	S 81°32'36" W	28.36'

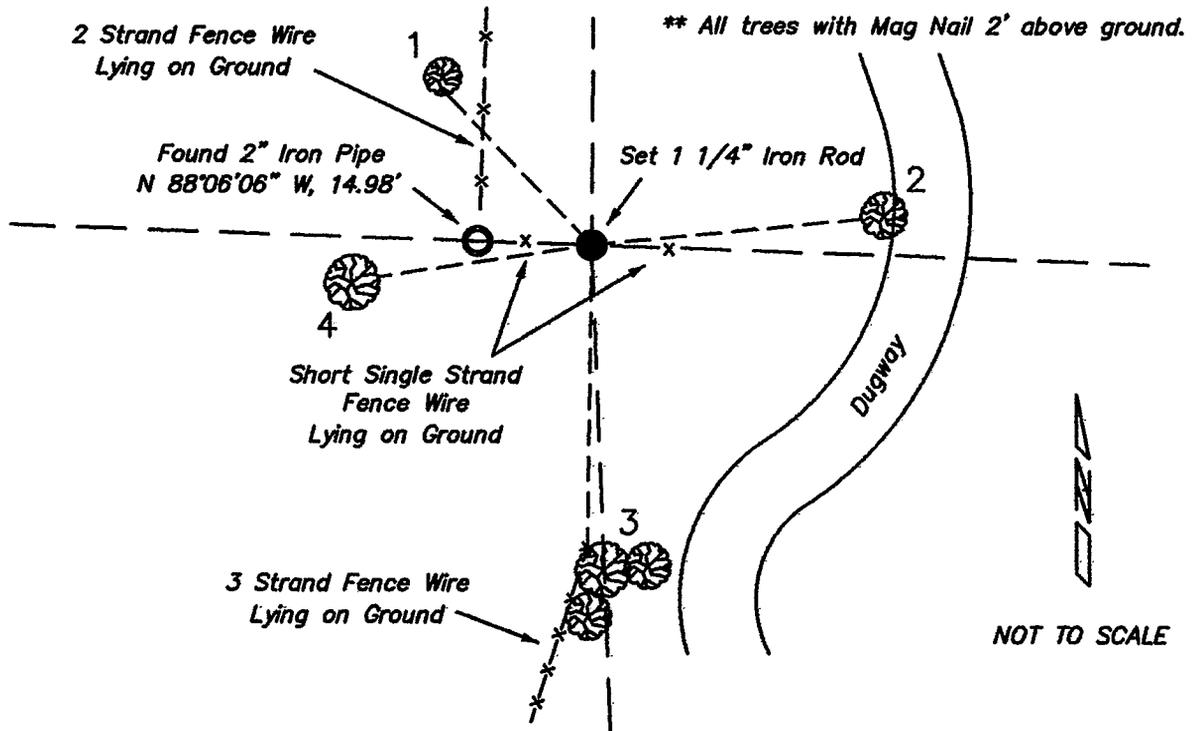


### PLAN VIEW DRAWING OF REFERENCE TIES

*Map Showing Distance And Direction To Other Public Land Survey Corners Used For Re-Establishing The Corner*

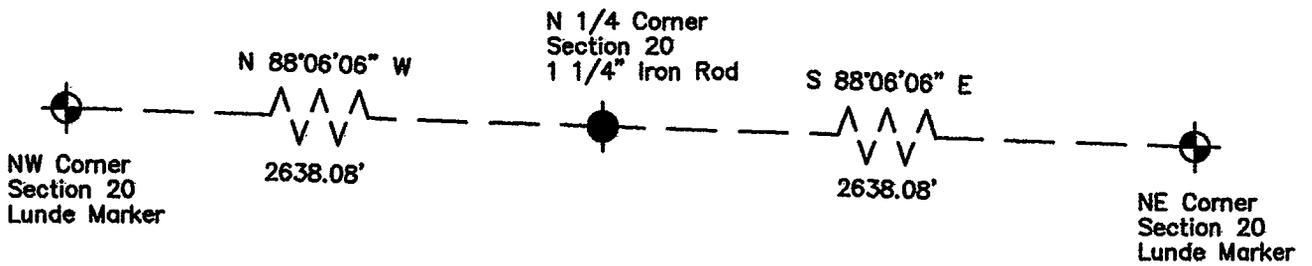

I, Stephen J Solberg, Registered Land Surveyor, hereby certify that the corner location shown on this record was determined by me or under my direction and control, and that this U.S. Public Land Survey Monument Record is correct and complete to the best of my knowledge and belief.

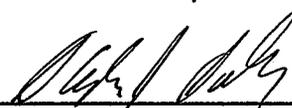  
 Stephen J Solberg RLS 1846  
 Eagle Ridge Surveying  
 PO Box 213  
 Wilton, Wisconsin  
 30 January 2006

