


## U. S. PUBLIC LAND SURVEY MONUMENT RECORD

SECTION 16 T 15 N, R 6 W, TOWN OF GREENFIELD

LA CROSSE COUNTY

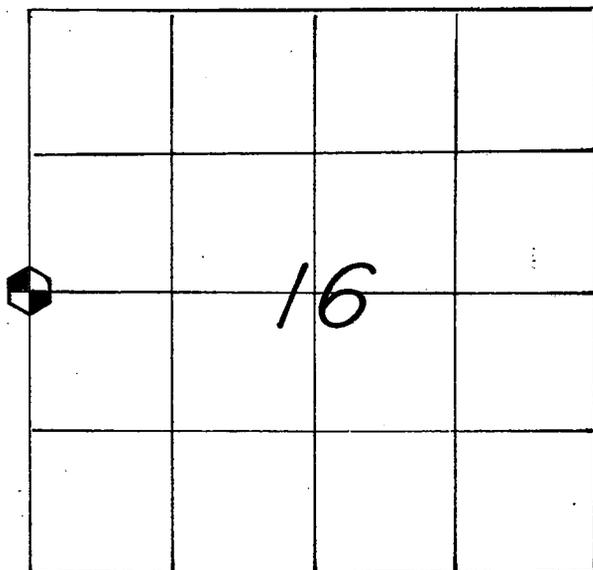

LOCATION OF LANDMARK

Crew: WILLIAM C. JUNG  
 PETER F. FOLLANSBEE  
 Date: 6/27/1996.

## WISCONSIN COORDINATE SYSTEM

North

East

Theta Angle

Horiz. Order

Vert. Order

## TYPE OF LANDMARK

Set brass cap Lunde marker.

BEARINGS ARE REFERENCED TO

Describe any record evidence, monument evidence, testimonial evidence or any other material evidence you considered and whether the monument was found or restored through acceptance of an obliterated evidence location.


I found an iron pipe at the corner which had been used as the corner in several previous surveys. I accepted the location of the pipe as the best available evidence of the original government corner position and replaced the pipe with a brass capped Lunde marker.

Describe or show any material discrepancy between the location of the restored corner and that of the corner previously restored or reestablished.

NONE KNOWN.

RECORD OF DURABLE WITNESS MONUMENTS  
ASSUMED

NO	DESCRIPTION	BEARING	DISTANCE
1	Set 1" x 30" I.P. (6'± W. of pavement)	N 89°41'56"W	14.17 Ft.
2	Set 1" x 30" I.P. (2'± W. of pavement)	N 09°06'23"W	68.85 Ft.
3	Set 1½" x 25" I.P. (8'± E. of pavement)	S 89°13'42"E	10.36 Ft.
4	Ex. 1½" I.P. (5'± W. of pavement)	S 01°09'57"W	399.66 Ft.

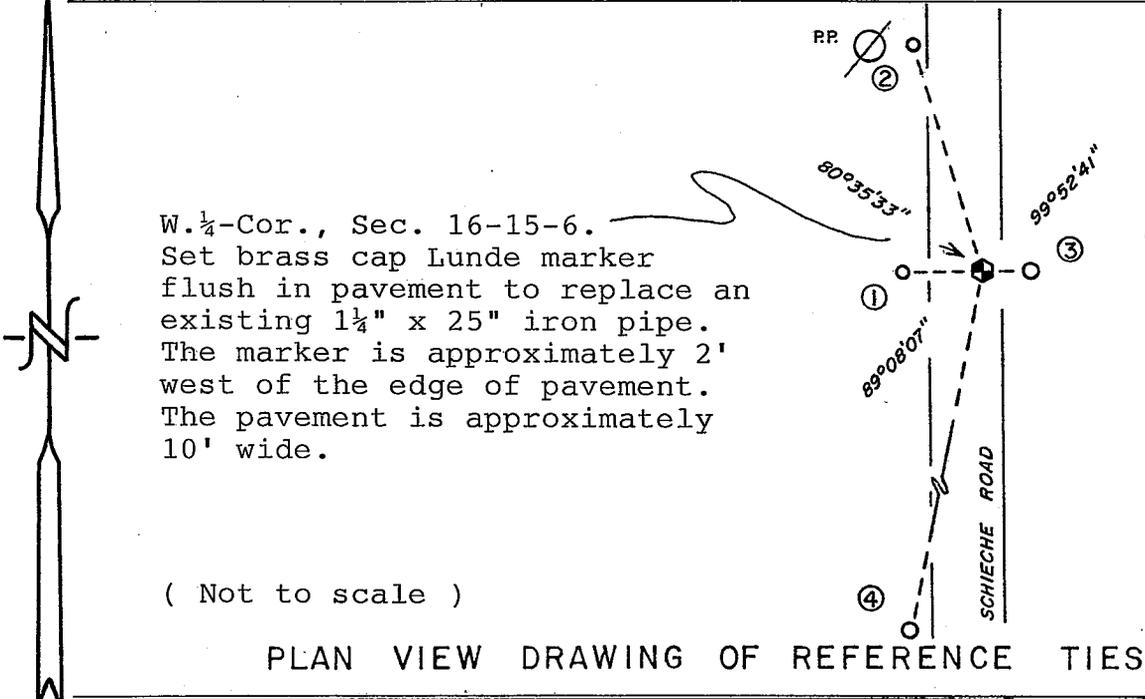


MAP SHOWING DISTANCE AND DIRECTION TO OTHER PUBLIC LAND SURVEY CORNERS USED FOR REESTABLISHING THE CORNER

No section measurements were made by me at this time. The location of this corner was confirmed through previous section work.

I, William C. Jung, County Surveyor  
HEREBY CERTIFY THAT THE CORNER LOCATION SHOWN ON THIS RECORD WAS DETERMINED BY ME OR UNDER MY DIRECTION AND CONTROL AND THAT THIS U. S. PUBLIC LAND SURVEY MONUMENT RECORD IS CORRECT AND COMPLETE TO THE BEST OF MY KNOWLEDGE AND BELIEF.

William C. Jung      1/2/97  
Signature      Date

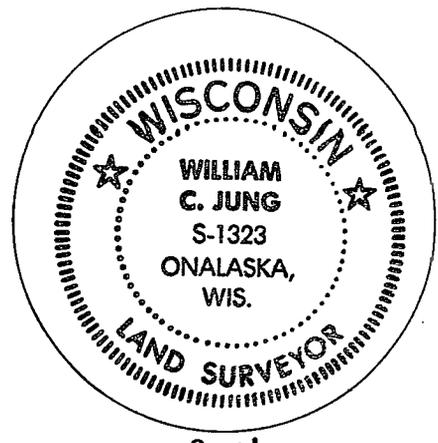

Seal