


21506172020

U. S. PUBLIC LAND SURVEY MONUMENT RECORD

SECTION 17 T 15 N, R 6 W, TOWN OF GREENFIELD
 LA CROSSE COUNTY

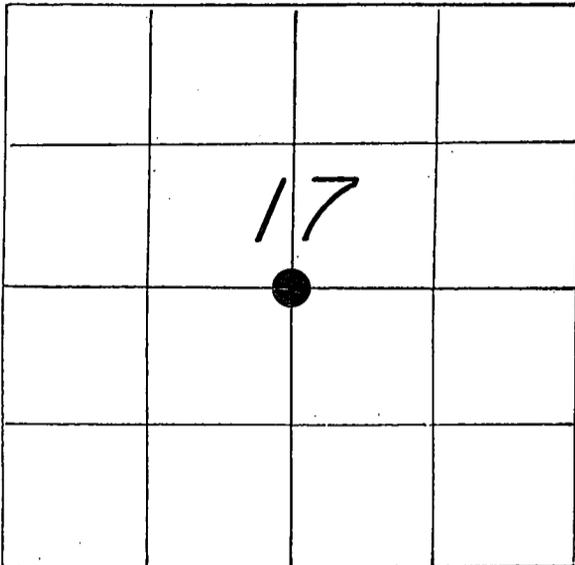

LOCATION OF LANDMARK

CREW: **WILLIAM C. JUNG**
PETER F. FOLLANSBEE
 DATE: **4/11/2000.**

WISCONSIN COORDINATE SYSTEM

North

East

Theta Angle

Horiz. Order

Vert. Order

TYPE OF LANDMARK
3/4" ROUND IRON BAR.

BEARINGS ARE REFERENCED TO

Describe any record evidence, monument evidence, testimonial evidence or any other material evidence you considered and whether the monument was found or restored through acceptance of an obliterated evidence location.


We found and tied off the corner of record. The corner had been set "by law" at the intersection of the 1/4 lines.

Describe or show any material discrepancy between the location of the restored corner and that of the corner previously restored or reestablished.

NONE KNOWN.

RECORD OF DURABLE WITNESS MONUMENTS

NO	DESCRIPTION	BEARING	DISTANCE
1	EX. SPIKE IN 23" WHITE OAK (EX. DOUBLE BLAZES)	N. 'WESTERLY ±	51.94 FT.
2	EX. 1-1/4" IRON PIPE SOUTHEASTERLY OF ROAD	N. 'WESTERLY ±	41.58 FT.
3	EX. SPIKE IN DEAD 13" TREE (EX. DOUBLE BLAZES)	S. 'EASTERLY ±	22.13 FT.
4	EX. SPIKE IN 23" STUMP	S. 'WESTERLY ±	24.76 FT.

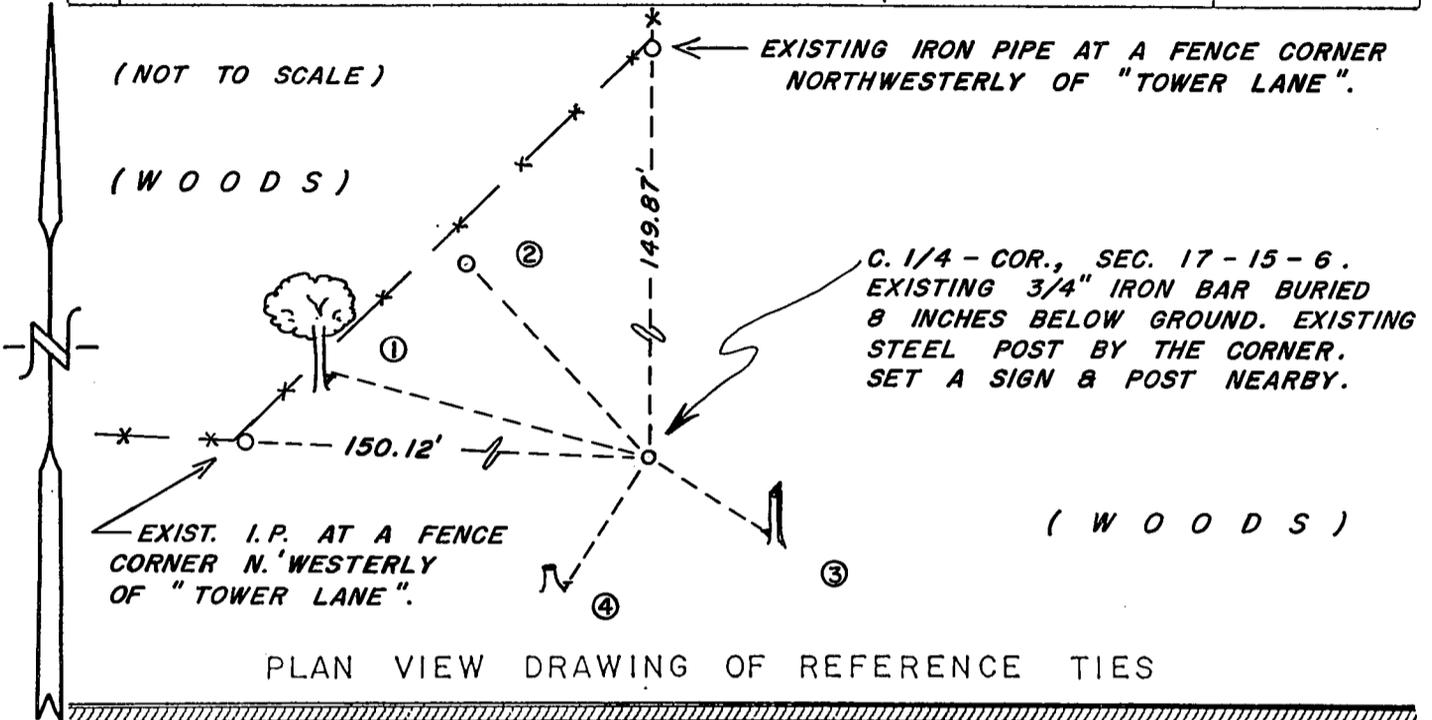

PLAN VIEW DRAWING OF REFERENCE TIES

MAP SHOWING DISTANCE AND DIRECTION TO OTHER PUBLIC LAND SURVEY CORNERS USED FOR REESTABLISHING THE CORNER

I made no section measurements at this time. The location of this corner had been confirmed earlier by others.

I, WILLIAM C. JUNG, COUNTY SURVEYOR
 HEREBY CERTIFY THAT THE CORNER LOCATION SHOWN ON THIS RECORD
 WAS DETERMINED BY ME OR UNDER MY DIRECTION AND CONTROL AND
 THAT THIS U. S. PUBLIC LAND SURVEY MONUMENT RECORD IS CORRECT
 AND COMPLETE TO THE BEST OF MY KNOWLEDGE AND BELIEF.

William C. Jung 5/18/00
 Signature Date



Seal