


U. S. PUBLIC LAND SURVEY MONUMENT RECORD

SECTION 19 T 15 N, R 6 W, TOWN OF Shelby

LA CROSSE COUNTY

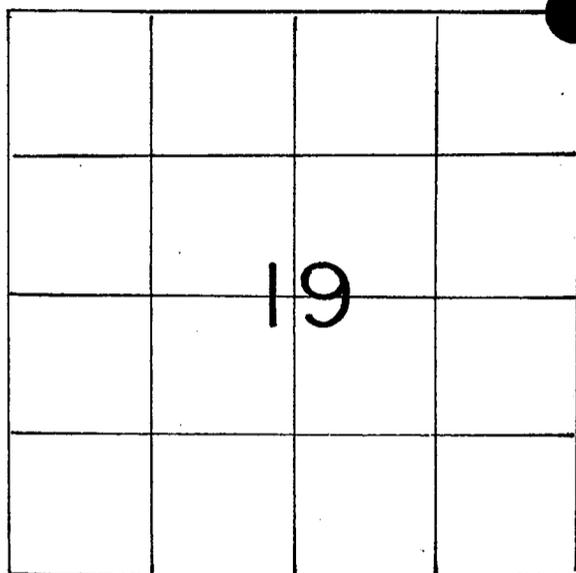

LOCATION OF LANDMARK

WISCONSIN COORDINATE SYSTEM

North

East

Theta Angle

Horiz. Order

Vert. Order

TYPE OF LANDMARK

BRASS CAP LUNDE MARKER

BEARINGS ARE REFERENCED TO

Crew: WILLIAM C. JUNG
PETER F. FOLLANSBEE

Date: 7/27/1989

Describe any record evidence, monument evidence, testimonial evidence or any other material evidence you considered and whether the monument was found or restored through acceptance of an obliterated evidence location.

Gary Sime set a 3/4" iron bar at this corner. He set this corner off of what he believed to be an original bearing tree. We found an old rotted 24" burr oak about N85°W, 146' from Sime's bar. I agree that this was more than likely the original bearing tree. I removed Sime's bar and replaced it with a brass capped Lunde marker.


Describe or show any material discrepancy between the location of the restored corner and that of the corner previously restored or reestablished.

NONE KNOWN

RECORD OF DURABLE WITNESS MONUMENTS
MAGNETIC

| NO | DESCRIPTION | BEARING | DISTANCE |
|----|-------------------------------------|---------|------------|
| 1 | Set P.K. Nail on E-side 3" Hickory | N 05° E | 9.57 Ft. |
| 2 | Set P.K. Nail on SW-side 6" Cedar | N 35° W | 14.20 Ft. |
| 3 | Set P.K. Nail on SE-side 6" Hickory | S 77° W | Sl.=30.47' |
| 4 | Set P.K. Nail on NW-side 5" Hickory | S 50° W | Sl.=34.53' |

(NOTE: ALL TREES ARE DOUBLE
BLAZED WITH P.K. NAIL IN HACK)

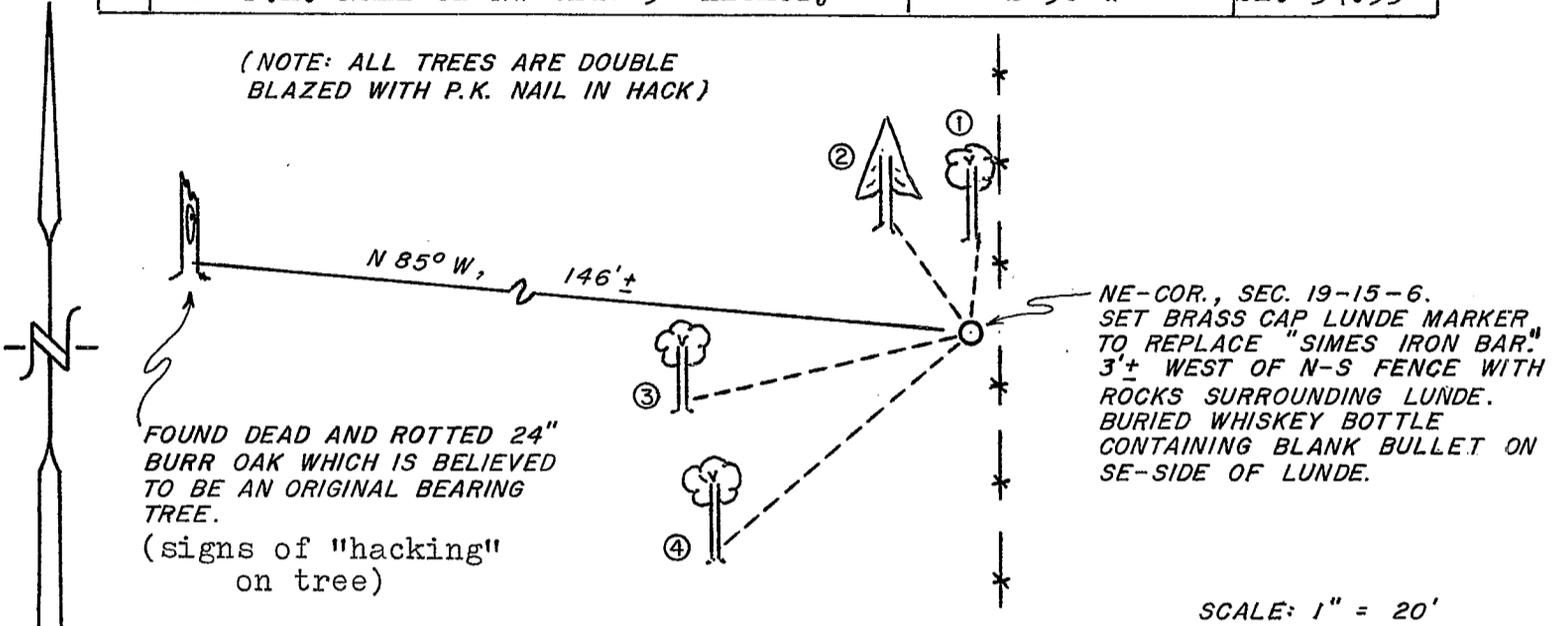

PLAN VIEW DRAWING OF REFERENCE TIES

MAP SHOWING DISTANCE AND DIRECTION TO OTHER PUBLIC LAND SURVEY CORNERS USED FOR REESTABLISHING THE CORNER

(no measurements made by me at this time)

I, William C. Jung, Deputy County Surveyor
HEREBY CERTIFY THAT THE CORNER LOCATION SHOWN ON THIS RECORD WAS DETERMINED BY ME OR UNDER MY DIRECTION AND CONTROL AND THAT THIS U. S. PUBLIC LAND SURVEY MONUMENT RECORD IS CORRECT AND COMPLETE TO THE BEST OF MY KNOWLEDGE AND BELIEF.

William C. Jung
Signature

11/28/89
Date

