


U. S. PUBLIC LAND SURVEY MONUMENT RECORD

SECTION 18 T 15 N, R 6 W, TOWN OF Shelby

LA CROSSE COUNTY

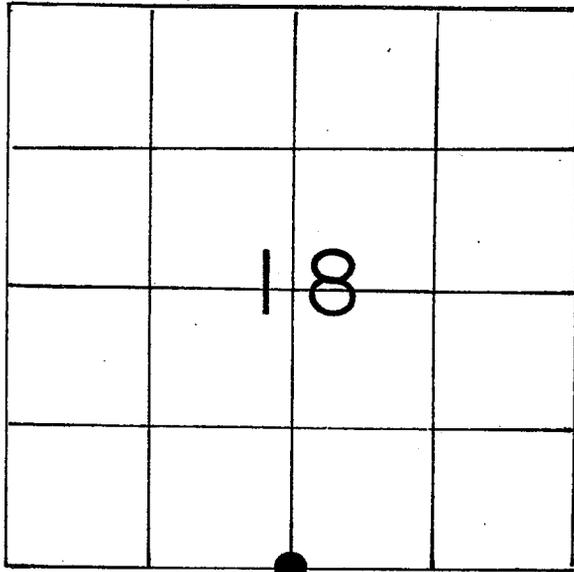

LOCATION OF LANDMARK

Crew: William C. Jung
Peter F. Follansbee

Date: October 2, 1990

Describe any record evidence, monument evidence, testimonial evidence or any other material evidence you considered and whether the monument was found or restored through acceptance of an obliterated evidence location.

The original corner was a post in a mound. All evidence of the original corner is gone due to bridge construction, etc. Chalsma set an iron pipe at this corner in June of 1982. It was also used as the corner in D.O.T. Project 5356-03-21 in 1985. The old North-South 1/4 line best fits this location. In 1987 Scholze found a 1/2" rebar buried 6" below the road surface. He set a 1" iron pipe over the rebar. This pipe is 18.17' to the Southeast of Chalsma's. After surveying in Sections 18 and 19 Gary Sime felt that Chalsma's pipe best fit the overall evidence and used it. I agree with Sime and replaced Chalsma's pipe with a brass capped Lunde marker, set flush, with a whiskey bottle and shell casing buried to the Southeast.

Describe or show any material discrepancy between the location of the restored corner and that of the corner previously restored or reestablished.

(see above narrative)

WISCONSIN COORDINATE SYSTEM

North

East

Theta Angle

Horiz. Order

Vert. Order


TYPE OF LANDMARK

Brass capped Lunde marker

BEARINGS ARE REFERENCED TO

RECORD OF DURABLE WITNESS MONUMENTS

NO	DESCRIPTION	BEARING	DISTANCE
1	Top of bolt-S. end of wooden parapet- W. side	-----	3.17
2	" " " E. "	-----	23.57
3	Ex. 1 1/2" iron pipe in road centerline	-----	18.17
4	Ex. P.K. nail in East side of power pole	-----	41.66

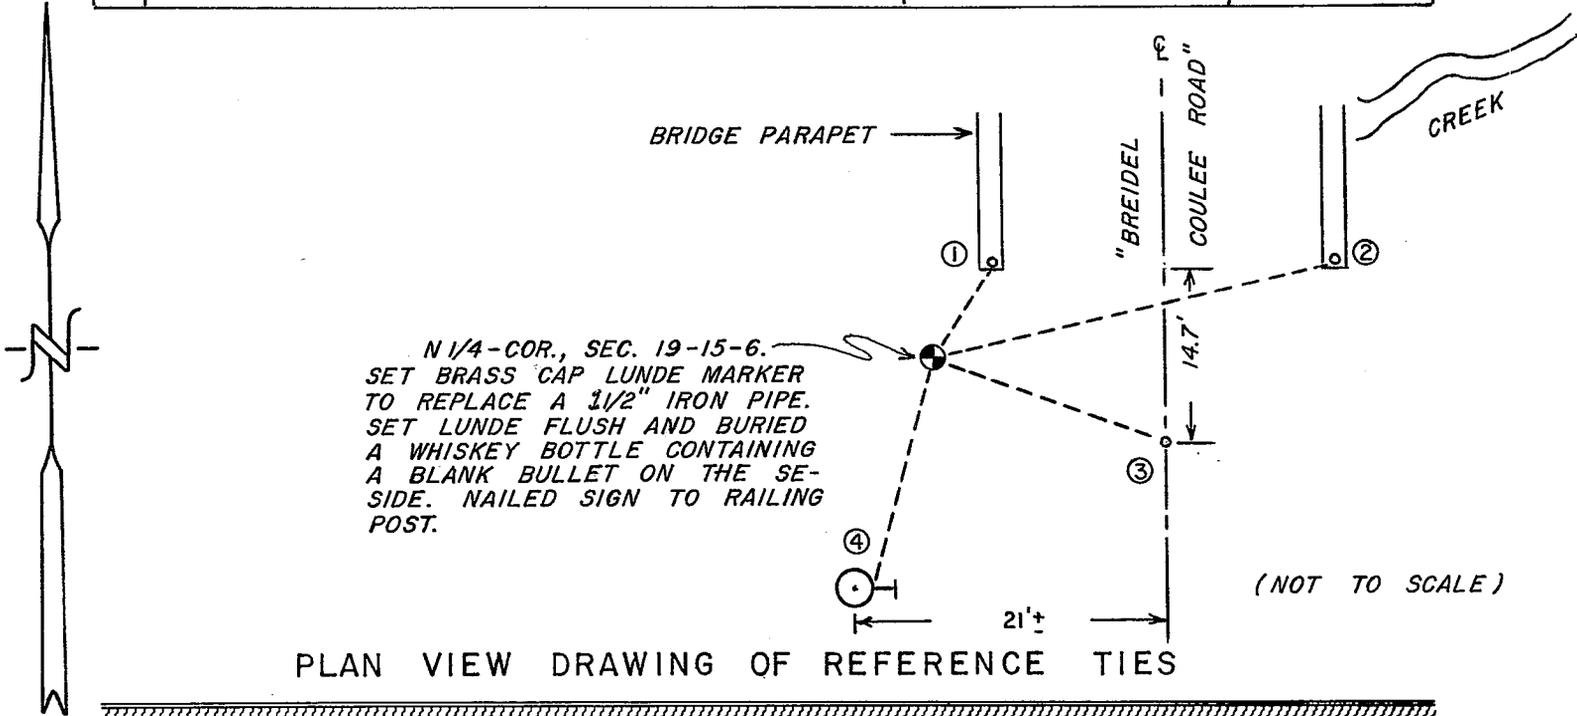


MAP SHOWING DISTANCE AND DIRECTION TO OTHER PUBLIC LAND SURVEY CORNERS USED FOR REESTABLISHING THE CORNER

No section measurements made by me at this time.

I, William C. Jung, Deputy County Surveyor,
 HEREBY CERTIFY THAT THE CORNER LOCATION SHOWN ON THIS RECORD
 WAS DETERMINED BY ME OR UNDER MY DIRECTION AND CONTROL AND
 THAT THIS U. S. PUBLIC LAND SURVEY MONUMENT RECORD IS CORRECT
 AND COMPLETE TO THE BEST OF MY KNOWLEDGE AND BELIEF.

William C. Jung
 Signature

February 11, 1991
 Date

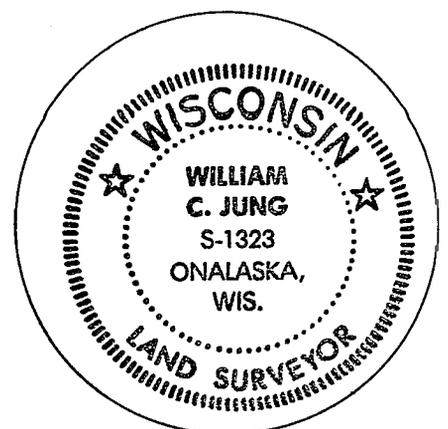

Seal