


21506190000

## U. S. PUBLIC LAND SURVEY MONUMENT RECORD

SECTION 19 T 15 N, R 6 W, TOWN OF SHELBY

LA CROSSE COUNTY

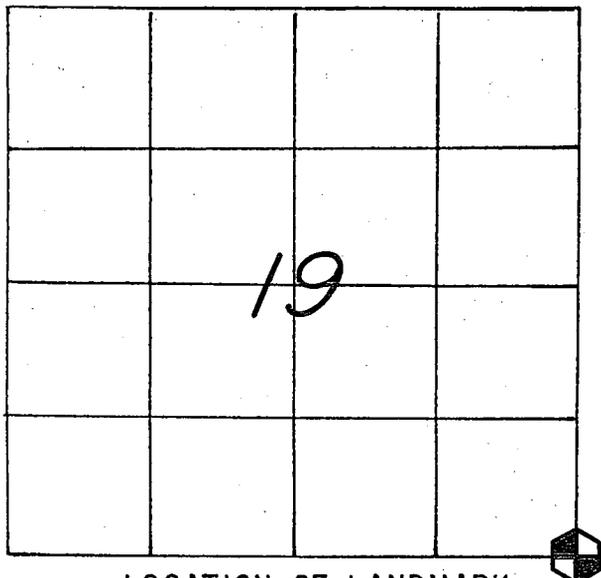

LOCATION OF LANDMARK

CREW: WILLIAM C. JUNG  
 PETER F. FOLLANSBEE  
 DATE: 10/12/2004

## WISCONSIN COORDINATE SYSTEM

North

East

Theta Angle

Horiz. Order

Vert. Order

## TYPE OF LANDMARK

BRASS CAP LUNDE MARKER.

BEARINGS ARE REFERENCED TO

ASSUMED NORTH AS PER SECTION DATA.

Describe any record evidence, monument evidence, testimonial evidence or any other material evidence you considered and whether the monument was found or restored through acceptance of an obliterated evidence location.

After analyzing his section data, K. Don Pederson and I agreed on a computed location for this corner. This location fits the field evidence very well. He set an iron bar at this corner. I found his iron bar, removed it, and replaced it with a brass capped Lunde marker, set flush.

Describe or show any material discrepancy between the location of the restored corner and that of the corner previously restored or reestablished.

**NONE KNOWN.**

RECORD OF DURABLE WITNESS MONUMENTS

MAGNETIC

NO	DESCRIPTION	BEARING	DISTANCE
1	SET A 3/4" x 30" IRON BAR 2' S.E. OF A 22 1/2" BOX ELDER	N 20° W	41.67 FT.
2	SET A NAIL IN S.E.-SIDE OF A 5" HICKORY	N 71° E	22.52 FT.
3	SET A NAIL IN S.-SIDE OF A 3 1/2" HICKORY	EAST ±	8.79 FT.
4	SET A NAIL IN E.-SIDE OF A 4" HICKORY	S 22° W	9.73 FT.


(NOTE: THE THREE BEARING TREES ARE UNBLAZED.)

(FIELD)

S.E.-COR., SEC. 19-15-6.  
 SET A BRASS CAP LUNDE MARKER  
 FLUSH TO REPLACE AN EXISTING  
 IRON BAR. BURIED A WINE BOTTLE  
 CONTAINING A BRASS SHELL CASING  
 WITH THE MARKER.

PLAN VIEW DRAWING OF REFERENCE TIES

MAP SHOWING DISTANCE AND DIRECTION TO OTHER PUBLIC LAND SURVEY CORNERS USED FOR REESTABLISHING THE CORNER

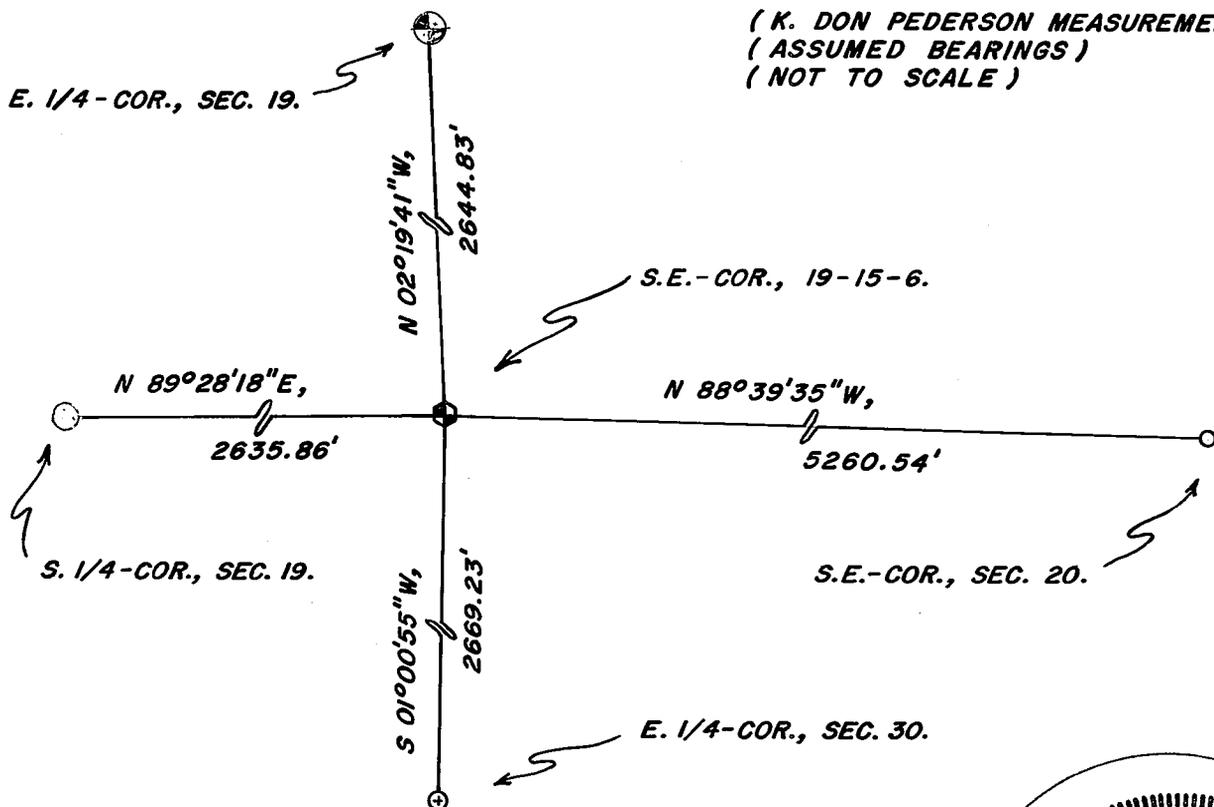

(K. DON PEDERSON MEASUREMENTS)  
 (ASSUMED BEARINGS)  
 (NOT TO SCALE)

I, WILLIAM C. JUNG, COUNTY SURVEYOR  
 HEREBY CERTIFY THAT THE CORNER LOCATION SHOWN ON THIS RECORD  
 WAS DETERMINED BY ME OR UNDER MY DIRECTION AND CONTROL AND  
 THAT THIS U. S. PUBLIC LAND SURVEY MONUMENT RECORD IS CORRECT  
 AND COMPLETE TO THE BEST OF MY KNOWLEDGE AND BELIEF.

William C. Jung                      12/23/04  
 Signature                                      Date



Seal