


U. S. PUBLIC LAND SURVEY MONUMENT RECORD

SECTION 30 T 15 N, R 6 W, TOWN OF SHELBY

LA CROSSE COUNTY

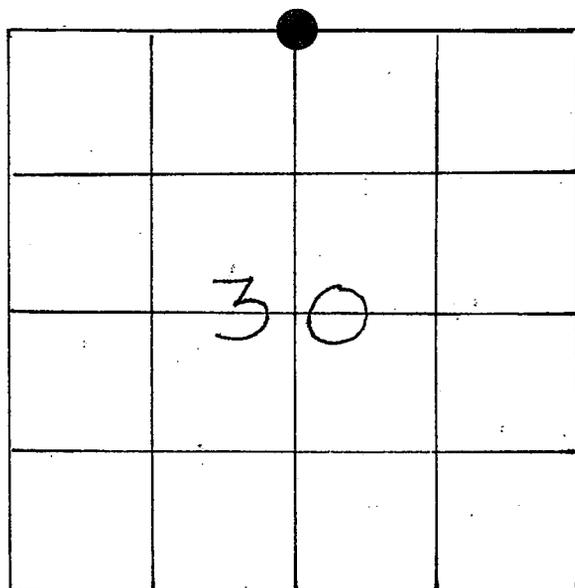

LOCATION OF LANDMARK

CREW: P. FAIRCHILD
R. JASPERSON

WISCONSIN COORDINATE SYSTEM

North

East

Theta Angle

Horiz. Order

Vert. Order

TYPE OF LANDMARK

1 1/4" I.P.

BEARINGS ARE REFERENCED TO

Describe any record evidence, monument evidence, testimonial evidence or any other material evidence you considered and whether the monument was found or restored through acceptance of an obliterated evidence location.


FOUND 1 1/4" I.P. AND ACCEPTED IT AS
NORTH 1/4 CORNER. PIPE FITS OCCUPATIONAL EVIDENCE

Describe or show any material discrepancy between the location of the restored corner and that of the corner previously restored or reestablished.

NO DISCREPANCY

RECORD OF DURABLE WITNESS MONUMENTS

NO	DESCRIPTION	BEARING	DISTANCE
1	10" HICKORY SINGLE BLAZE W/PK	N 8° W	19.70'
2	6" CHERRY SINGLE BLAZE W/PK	N 52° E	27.17'
3	18" WHITE OAK SINGLE BLAZE W/PK	S 80° W	14.73'
4	20" WHITE OAK SINGLE BLAZE W/PK	S 37° W	15.64'

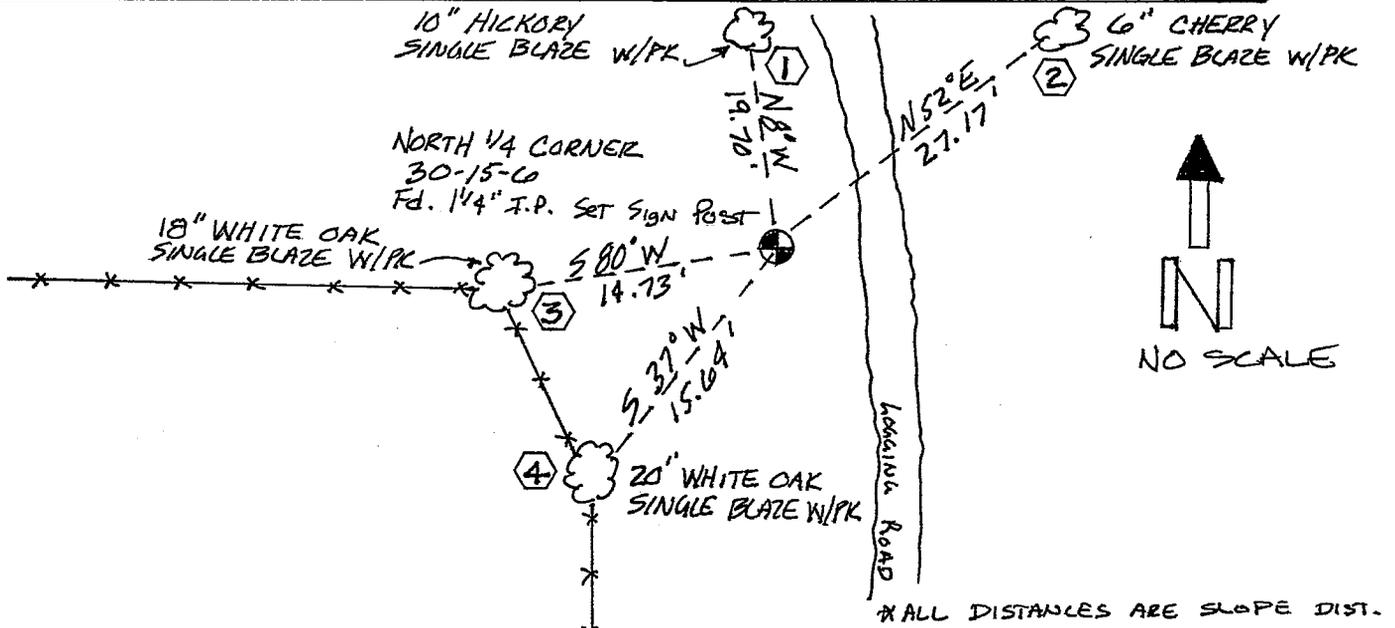

PLAN VIEW DRAWING OF REFERENCE TIES

MAP SHOWING DISTANCE AND DIRECTION TO OTHER PUBLIC LAND SURVEY CORNERS USED FOR REESTABLISHING THE CORNER

I, Paul E. Fairchild
 HEREBY CERTIFY THAT THE CORNER LOCATION SHOWN ON THIS RECORD
 WAS DETERMINED BY ME OR UNDER MY DIRECTION AND CONTROL AND
 THAT THIS U. S. PUBLIC LAND SURVEY MONUMENT RECORD IS CORRECT
 AND COMPLETE TO THE BEST OF MY KNOWLEDGE AND BELIEF.

Paul E. Fairchild 5/17/94
 Signature Date



Seal