


U. S. PUBLIC LAND SURVEY MONUMENT RECORD

SECTION 19 T 15 N, R 6 W, TOWN OF Shelby
 LA CROSSE COUNTY

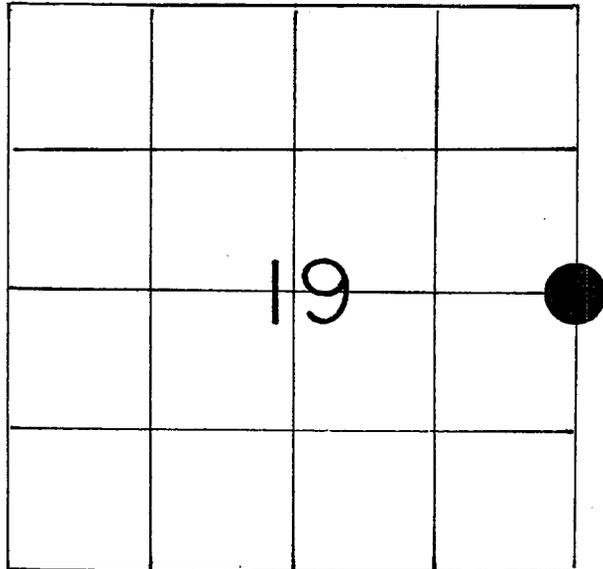

LOCATION OF LANDMARK

WISCONSIN COORDINATE SYSTEM

North

East

Theta Angle

Horiz. Order

Vert. Order

TYPE OF LANDMARK

BRASS CAP LUNDE MARKER ^{P.K. over*****}

BEARINGS ARE REFERENCED TO

True

Crew: WILLIAM C. JUNG
 PETER F. FOLLANSBEE

Crew: William C. Jung
 Peter F. Follansbee

Date: 7/27/1989

Date: 7/9/92 and 5/31/95

Describe any record evidence, monument evidence, testimonial evidence or any other material evidence you considered and whether the monument was found or restored through acceptance of an obliterated evidence location.

I found a railroad spike at the occupied corner. This point had been used as the corner in previous surveys. I accepted this point as the best available evidence of the original government corner position. The railroad spike was removed and replaced with a brass capped Lunde marker.

***** 1992 notes:

We found the Lunde buried under a new layer of asphalt. Describe or show any material discrepancy between the location of the restored corner and that of the corner previously restored or reestablished.


None known.

None known.


5/31/95 - Follansbee and I set a P.K. nail over the Lunde marker.

RECORD OF DURABLE WITNESS MONUMENTS

NO	DESCRIPTION	BEARING	DISTANCE
1	Ex. 3/4" I.B.,	S89° 34' 29" W	1294.70 Ft.
2	Set P.K. Nail S-side 6" Dbl. Black Oak	West ±	74.70 Ft.
3	Ex. 3/4" I.B. set by "Sime & Assoc."	West ±	33.00 Ft.
4	Set P.K. Nail in W-side power pole	Southeast ±	57.68 Ft.

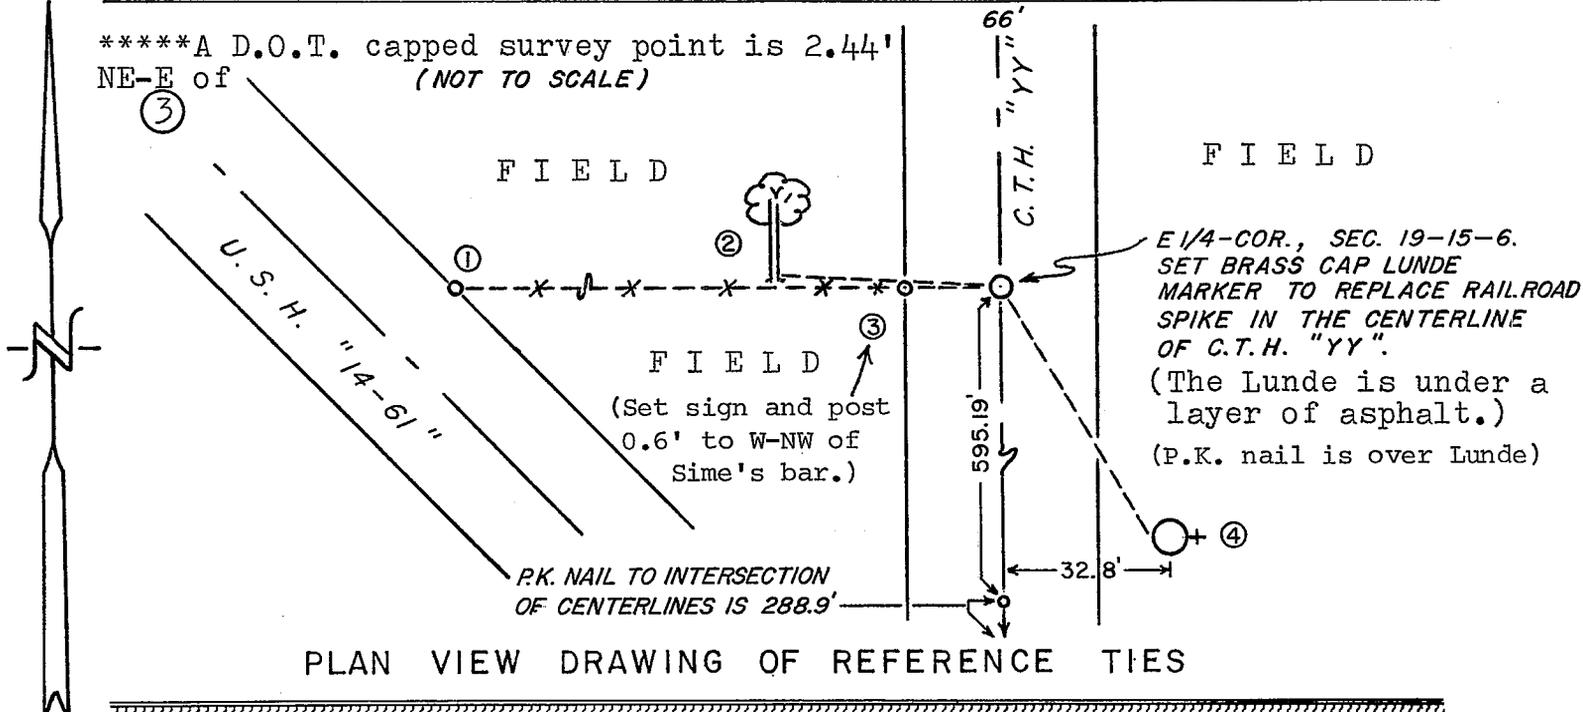

MAP SHOWING DISTANCE AND DIRECTION TO OTHER PUBLIC LAND SURVEY CORNERS USED FOR REESTABLISHING THE CORNER (not to scale)

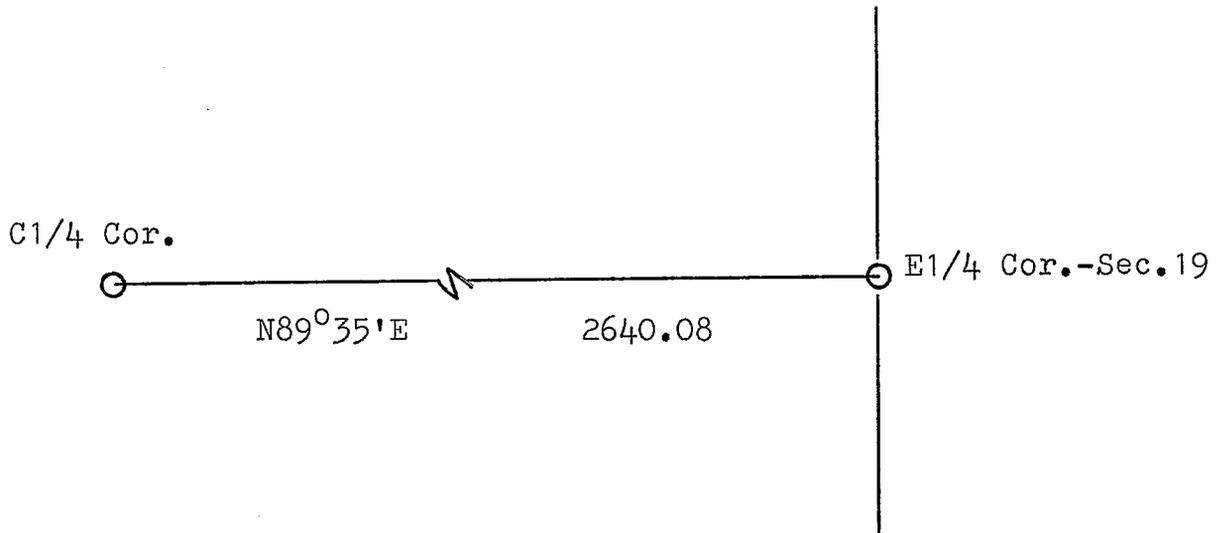

I, William C. Jung, Deputy County Surveyor
 HEREBY CERTIFY THAT THE CORNER LOCATION SHOWN ON THIS RECORD WAS DETERMINED BY ME OR UNDER MY DIRECTION AND CONTROL AND THAT THIS U. S. PUBLIC LAND SURVEY MONUMENT RECORD IS CORRECT AND COMPLETE TO THE BEST OF MY KNOWLEDGE AND BELIEF.

William C. Jung
 Signature

11/28/89
 Date

Revised: 12/30/92 *wcj*

Revised: 2/6/96 *wcj*



Seal