


U. S. PUBLIC LAND SURVEY MONUMENT RECORD

SECTION 19 T 15 N, R 6 W, TOWN OF Shelby

LA CROSSE COUNTY

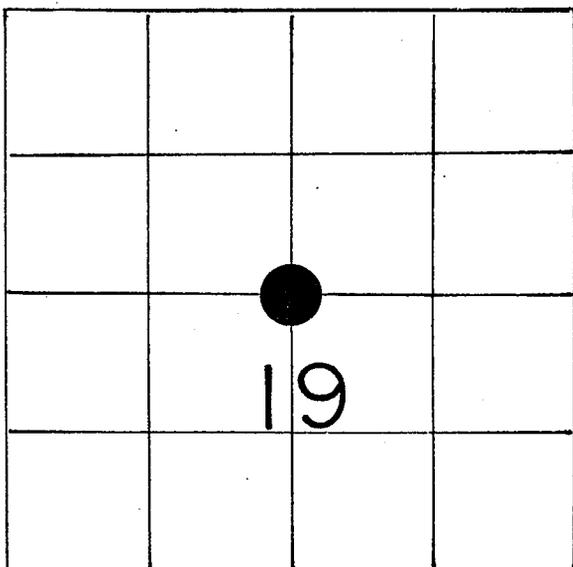

LOCATION OF LANDMARK

WISCONSIN COORDINATE SYSTEM

North

East

Theta Angle

Horiz. Order

Vert. Order

TYPE OF LANDMARK

SET BERNTSEN TOP IN EX. IRON PIPE

BEARINGS ARE REFERENCED TO

True

Crew: WILLIAM C. JUNG
PETER F. FOLLANSBEE

Date: 8/10/1989

Describe any record evidence, monument evidence, testimonial evidence or any other material evidence you considered and whether the monument was found or restored through acceptance of an obliterated evidence location.


I found an iron pipe at the occupied Center 1/4 Corner. This point had been used as the corner in previous surveys. It also appears to be an irregular Center 1/4 Corner. Judging by the field evidence going back to the East, including a cemetery dating back to the Civil War, I believe that this Center 1/4 Corner was set in an irregular fashion years ago. I believe that it should be accepted as the Center 1/4 Corner. Sime, Solberg, Pederson, and I all agree on this. I set a Berntsen top in the existing iron pipe.

Describe or show any material discrepancy between the location of the restored corner and that of the corner previously restored or reestablished.


(see notes above)

RECORD OF DURABLE WITNESS MONUMENTS

NO	DESCRIPTION	BEARING	DISTANCE
1	Existing 1 3/8" iron pipe	West ±	142.10 Ft.
2	Northeast corner of power box	West ±	7.15 Ft.
3	Ex. 2" I.P., NE-Cor. Brookwood Add.	N 03° 03' 45" W	722.57 Ft.
4	Ex. 3/4" I.B.	N 89° 35' 29" E	1345.38 Ft.

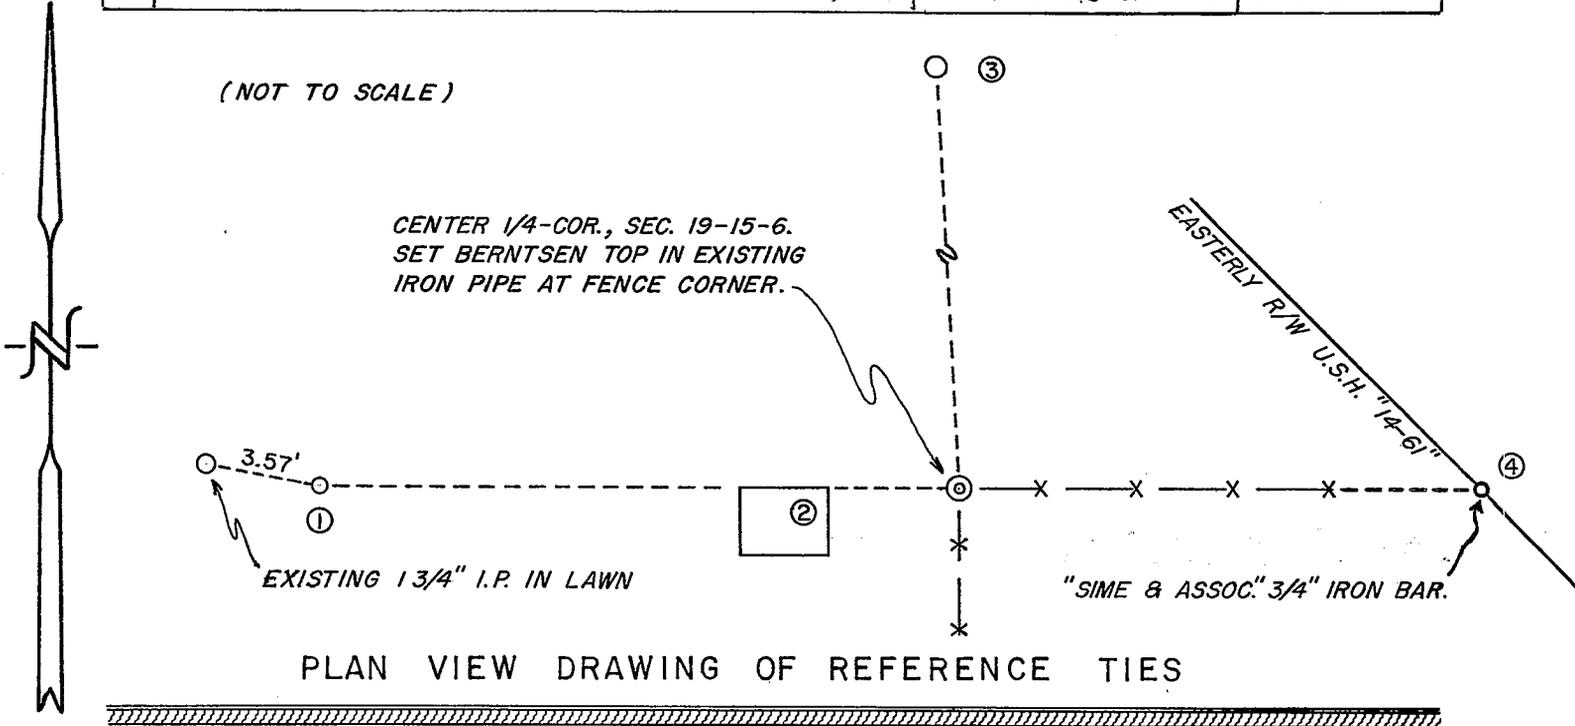

MAP SHOWING DISTANCE AND DIRECTION TO OTHER PUBLIC LAND SURVEY CORNERS USED FOR REESTABLISHING THE CORNER (not to scale)

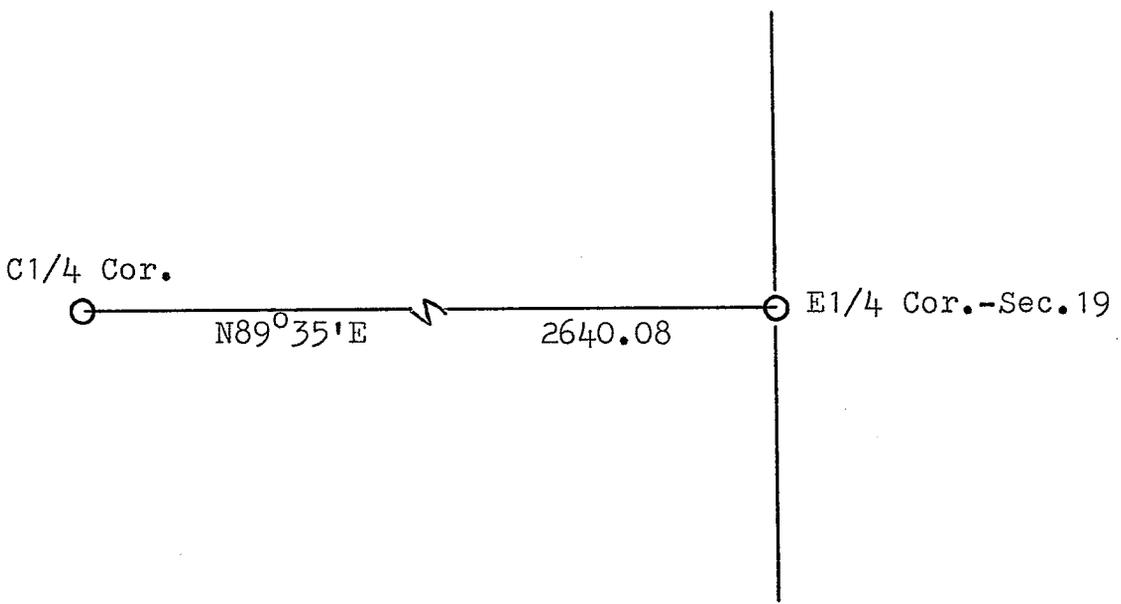

I, William C. Jung, Deputy County Surveyor
 HEREBY CERTIFY THAT THE CORNER LOCATION SHOWN ON THIS RECORD
 WAS DETERMINED BY ME OR UNDER MY DIRECTION AND CONTROL AND
 THAT THIS U. S. PUBLIC LAND SURVEY MONUMENT RECORD IS CORRECT
 AND COMPLETE TO THE BEST OF MY KNOWLEDGE AND BELIEF.

William C. Jung
 Signature

11/28/89
 Date



Seal