


U. S. PUBLIC LAND SURVEY MONUMENT RECORD

SECTION 29 T 15 N, R 6 W, TOWN OF GREENFIELD
LA CROSSE COUNTY

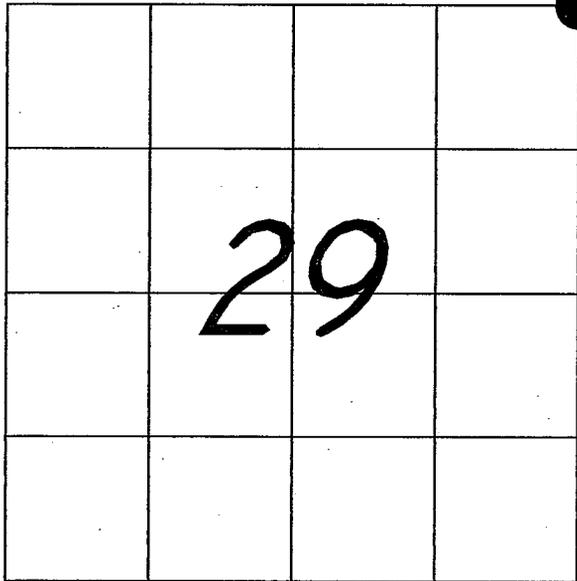

LOCATION OF LANDMARK

CREW: SD

AR

DATE: 9/22/02

Describe any record evidence, monument evidence, testimonial evidence, or any other material evidence you considered and whether the monument was found or restored through acceptance of an obliterated evidence location.

I did not find the monument marking the corner as shown on previous surveys by Stephen Solberg or Clayton Connell. I did find several pipes from a Clayton Connell survey that indicate the corner should be in a marsh area between the creek and the top of bank. This is where I set the corner.

Describe or show any material discrepancy between the location of the restored corner and that of the corner previously restored or reestablished.

I shot in several pipes from a couple of surveys from both Stephen Solberg and Clayton Connell and found the best fit for remonumenting the corner to be with Clayton Connell's Surveys. I believe that in at least one of Stephen Solbergs surveys he may have used a pipe for the section that was in fact 61.00 feet north of the corner he was looking for.

WISCONSIN COORDINATE SYSTEM

North

East

Theta Angle

Horiz. Order

Vert. Order

TYPE OF LANDMARK


SET 2" IP

BEARINGS ARE REFERENCED TO

THE SOUTH LINE OF THE SE 1/4,
SECTION 29 (ASSUMED EAST)

RECORD OF DURABLE WITNESS MONUMENTS


NO	DESCRIPTION	BEARING	DISTANCE
1	40" COTTONWOOD (P.K. IN BASE & UNBLAZED)	S 85°50'17" E	154.32'
2	FOUND 1" IRON PIPE	S 00°33'59" E	165.10'
3	FOUND 1" IRON PIPE	N 69°46'59" W	166.89'
4	FOUND 1" IRON PIPE	N 43°47'29" W	179.88'
5	FOUND 1" IRON PIPE INSIDE A 2" IRON PIPE	N 03°15'21" W	61.00'

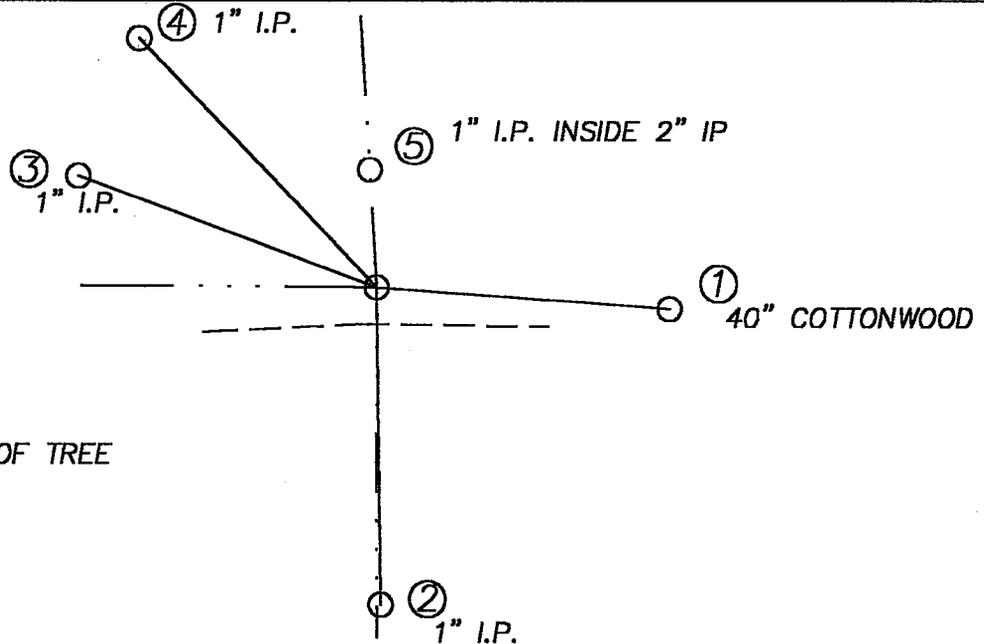

NOTES:
NO SCALE
P.K. NAIL IN BASE OF TREE


PLAN VIEW DRAWING OF REFERENCE TIES

MAP SHOWING DISTANCE AND DIRECTION TO OTHER PUBLIC LAND SURVEY CORNERS USED FOR REESTABLISHING THE CORNER

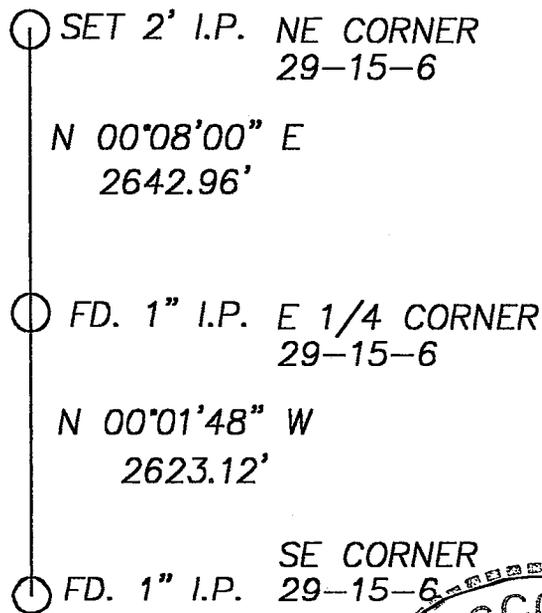

I, Scott M. Dunnum

HEREBY CERTIFY THAT THE CORNER LOCATION SHOWN ON THIS RECORD WAS DETERMINED BY ME OR UNDER MY DIRECTION AND CONTROL AND THAT THIS U. S. PUBLIC LAND SURVEY MONUMENT RECORD IS CORRECT AND COMPLETE TO THE BEST OF MY KNOWLEDGE AND BELIEF.

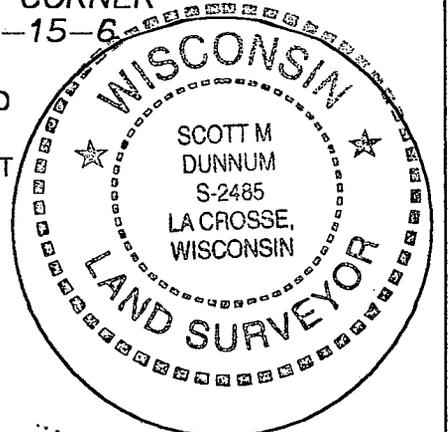

Scott M. Dunnum

Signature

6/28/03

Date

Seal