


## U. S. PUBLIC LAND SURVEY MONUMENT RECORD

SECTION 20 T 15 N, R 6 W, TOWN OF GREENFIELD

LA CROSSE COUNTY

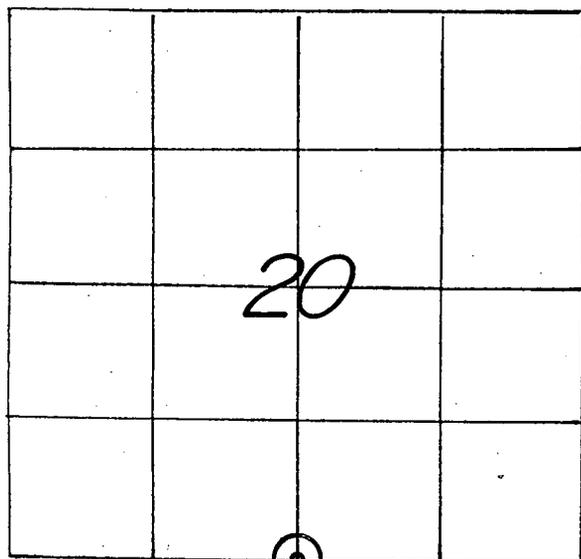

LOCATION OF LANDMARK

CREW: WILLIAM C. JUNG  
 PETER F. FOLLANSBEE  
 DATE: 8/06/2007.

## WISCONSIN COORDINATE SYSTEM

North 641,304.904

East 1,672,540.473

Theta Angle

Horiz. Order

Vert. Order

DATUM: 1983 ('91)

TYPE OF LANDMARK

P.K. NAIL IN CONCRETE.

BEARINGS ARE REFERENCED TO  
 GRID NORTH AS PER SECTION DATA.

Describe any record evidence, monument evidence, testimonial evidence or any other material evidence you considered and whether the monument was found or restored through acceptance of an obliterated evidence location.


There had been a nail at this corner in the past. There were a number of surveys tied to this nail. I accepted the location of the nail as the corner by "common report". Because of new highway construction, the old nail is gone. We set a P.K. nail in a drill hole in the new concrete where the nail used to be.

Describe or show any material discrepancy between the location of the restored corner and that of the corner previously restored or reestablished.


**NONE KNOWN.**

RECORD OF DURABLE WITNESS MONUMENTS

NO	DESCRIPTION	GRID BEARINGS	GROUND DISTANCES
		BEARING	DISTANCE
1	SET A 3/4"x30" IRON BAR 17' N.-EAST OF CONCRETE	N 39°51'30"W	277.96 FT.
2	SET A DRILL HOLE IN TOP CONC. CULVERT, 6"s BACK	N 26°55'25"W	213.08 FT.
3	SET A DRILL HOLE IN TOP CONC. CULVERT, 6"s BACK	N 03°06'45"W	147.22 FT.
4	SET A 3/4"x30" IRON BAR 17' N.-EAST OF CONCRETE	N 13°39'50"E	70.18 FT.

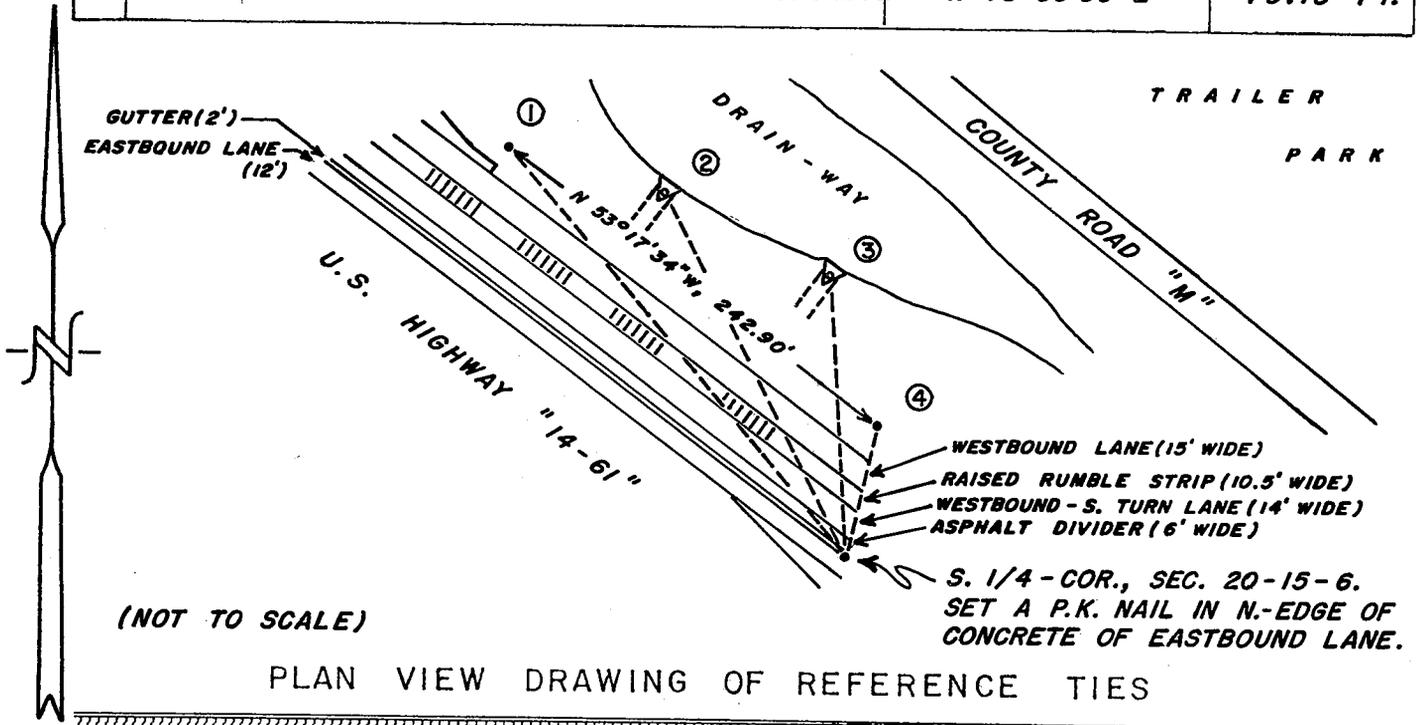


MAP SHOWING DISTANCE AND DIRECTION TO OTHER PUBLIC LAND SURVEY CORNERS USED FOR REESTABLISHING THE CORNER  
 (GRID BEARINGS AND DISTANCES)  
 (GRID FACTOR: 0.999914)  
 (NOT TO SCALE)

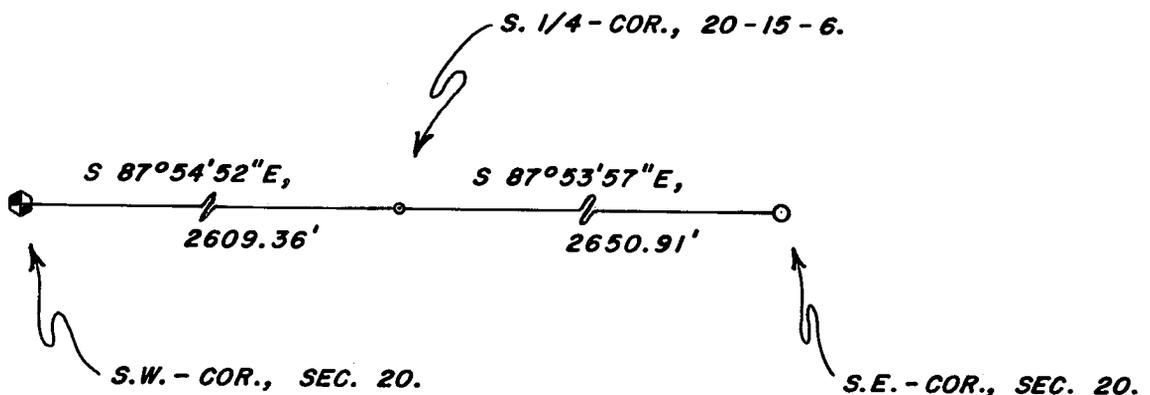

I, WILLIAM C. JUNG, COUNTY SURVEYOR  
 HEREBY CERTIFY THAT THE CORNER LOCATION SHOWN ON THIS RECORD WAS DETERMINED BY ME OR UNDER MY DIRECTION AND CONTROL AND THAT THIS U. S. PUBLIC LAND SURVEY MONUMENT RECORD IS CORRECT AND COMPLETE TO THE BEST OF MY KNOWLEDGE AND BELIEF.

William C. Jung      8/29/07  
 Signature      Date

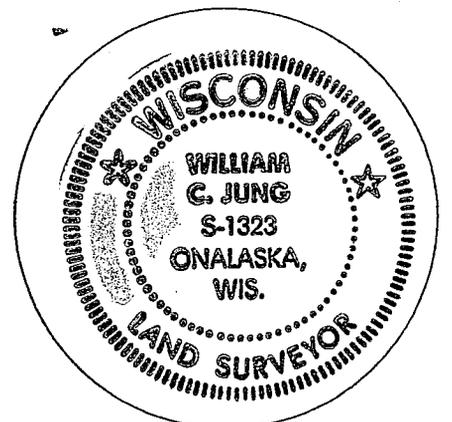

Seal