


U. S. PUBLIC LAND SURVEY MOUMENT RECORD

SECTION 20, T15N, R6W, TOWN OF GREENFIELD
LA CROSSE COUNTY, WISCONSIN

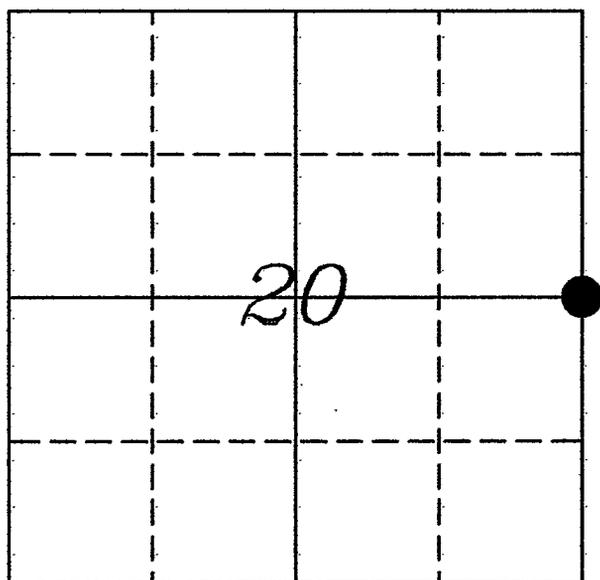

WISCONSIN COORDINATE SYSTEM	
Northing	
Easting	
Elevation	
TYPE OF LANDMARK:	
Set 1 1/4" x 18" Iron Rod	
BEARINGS ARE REFERENCED TO:	
Assumed	

LOCATION OF LANDMARK

Crew: Stephen J Solberg
Laurence E Johns III
Larry Handschy


Date: 30 January 2006

Describe any record evidence, monument evidence, testimonial evidence or any other material evidence you considered and whether the monument was found or restored through acceptance of an obliterated evidence location.

There are several surveys that reference 40 Corners being set to the North and South of this corner. None of these surveys mention a monument at this corner. Doubling the distances from the 40 Corners to their respective section corners do not meet in the same location. This Corner was determined by doubling the distance between the SE Corner of Section 20 and the NE Corner of the SE1/4 of the SE1/4. This location seems to fit the occupation the best.

Describe or show any material discrepancy between the location of the restored corner and that of the corner previously restored or re-established.


No record of corner being restored since original government survey.

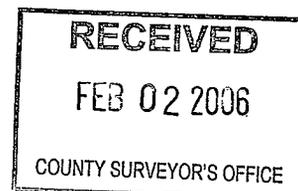

RECORD OF DURABLE WITNESS MONUMENTS


NO	DESCRIPTION	BEARING	DISTANCE
1	3/4" Iron Rod in fence line	N 50°44'19" E	50.03'
2	3/4" Iron Rod in fence line	S 83°06'49" E	41.57'
3	16" Hickory	S 52°37'03" W	14.50'
4	10" White Oak	N 24°16'04" W	44.21'

** All trees have a Mag Nail 2' above the ground.

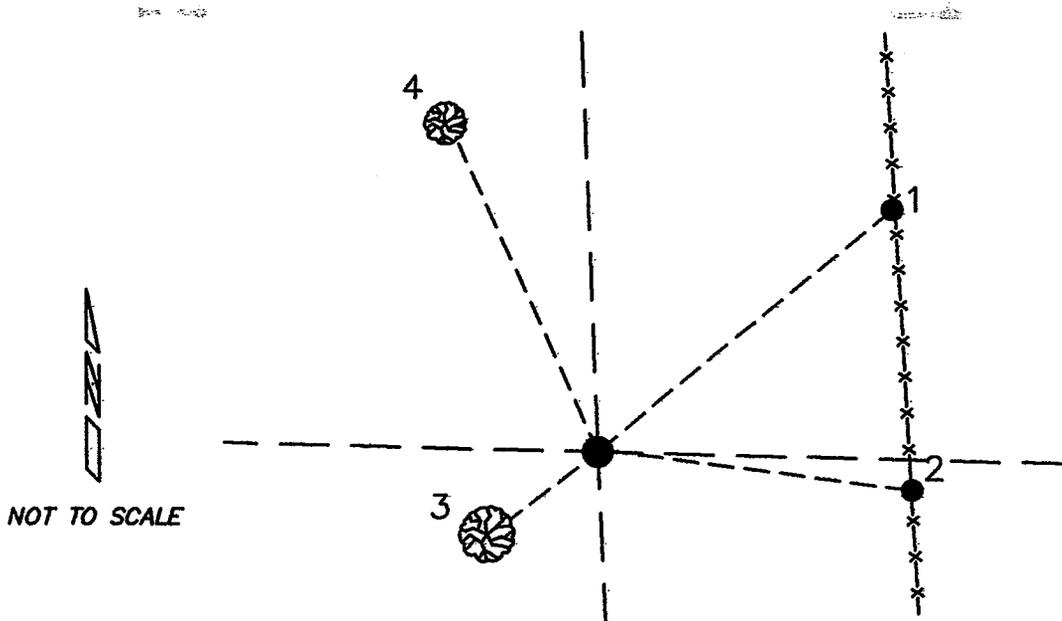


PLAN VIEW DRAWING OF REFERENCE TIES

Map Showing Distance And Direction To Other Public Land Survey Corners Used For Re-Establishing The Corner

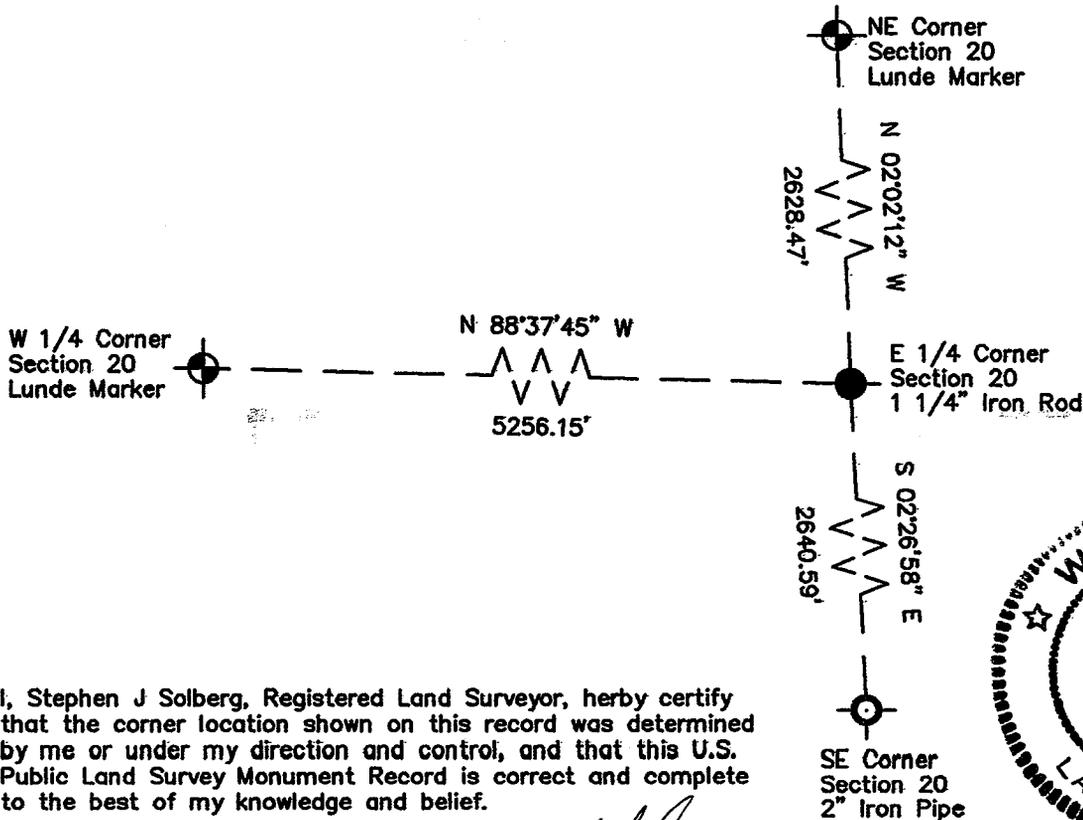

I, Stephen J Solberg, Registered Land Surveyor, hereby certify that the corner location shown on this record was determined by me or under my direction and control, and that this U.S. Public Land Survey Monument Record is correct and complete to the best of my knowledge and belief.

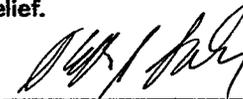
 Stephen J Solberg RLS 1846
 Eagle Ridge Surveying
 PO Box 213
 Wilton, Wisconsin
 30 January 2008

