

JAN 10 2006

21506210000

COUNTY SURVEYOR'S OFFICE



U.S. PUBLIC LAND SURVEY MONUMENT RECORD

SECTION 27, T15N, R6W, TOWN OF GREENFIELD
LA CROSSE COUNTY

CERTIFICATE

I, K. DON PEDERSON, DO HEREBY CERTIFY THAT IN JULY OF 2005, WE WERE INFORMED THAT THE MONUMENT WAS REMOVED AT THE NORTHWEST CORNER OF SECTION 27, T 15 N, R 6 W, AND I REESTABLISHED SAID CORNER ACCORDING TO THE WISCONSIN STATUTES AS SHOWN AND DESCRIBED HEREON.

DATED THIS 9th DAY OF JANUARY 2006.

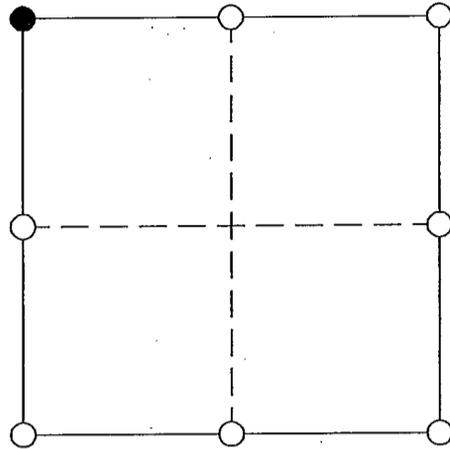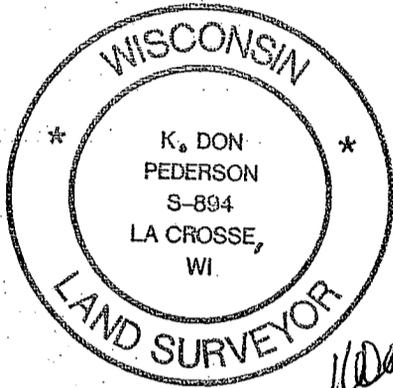

● = CORNER LOCATION
SECTION 27, T15N, R6W
TOWN OF GREENFIELD

HISTORY OF ORIGINAL CORNER ESTABLISHMENT:

ORIGINAL CORNER ESTABLISHED BY ALFRED L. BROWN IN OCTOBER 1846.
WILLIAM C. JUNG, COUNTY SURVEYOR, RESET THE CORNER WITH A BRASS CAP LUNDE MARKER ON APRIL 14, 1889.

DESCRIPTION OF CORNER EVIDENCE FOUND:

THE MONUMENT WAS REMOVED BY LOGGING ACTIVITIES.
I REPLACED THE MONUMENT AT THE PREVIOUS FOUND LOCATION FROM A RECENT SURVEY.
I REPLACED BILL JUNG'S WINE BOTTLE IN ITS PREVIOUS LOCATION.



DESCRIPTION OF CORNER AND WITNESS MONUMENTS, REFERENCES AND ACCESSORIES USED TO PERPETUATE THE ORIGINAL OR REESTABLISHED LOCATION OF THIS CORNER:

WITNESSES TO CORNER LOCATION:

LUCAS V. SONSALLA

JOSEPH KRAMER


SKETCH: NOT TO SCALE
NOTE: ALL PK NAILS SET IN
SINGLE BLAZED HICKORY TREES
MEASUREMENTS ARE SLOPE DISTANCE

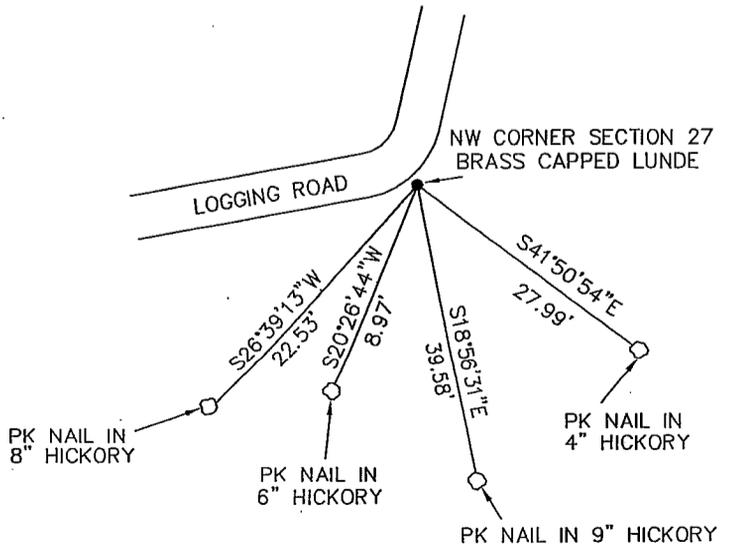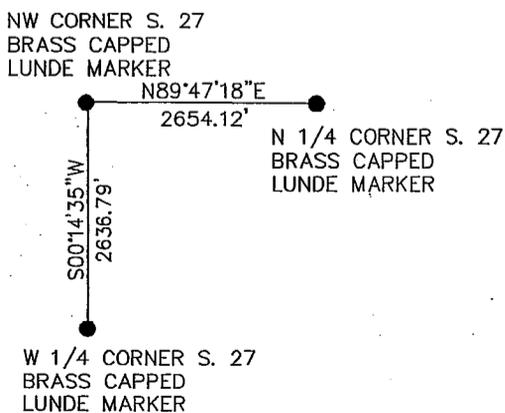

U. S. PUBLIC LAND SURVEY MONUMENT RECORD

SECTION 27 T 15 N, R 6 W, TOWN OF GREENFIELD

LA CROSSE COUNTY

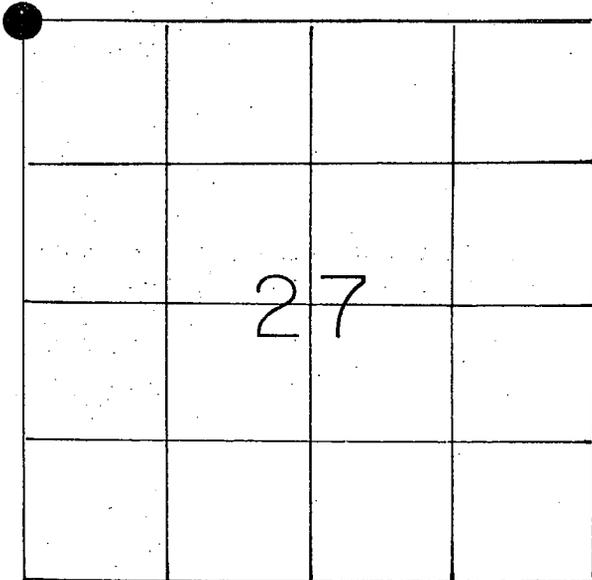

LOCATION OF LANDMARK

Crew: WILLIAM C. JUNG
 PETER F. FOLLANSBEE

Date: 4/14/1989

Describe any record evidence, monument evidence, testimonial evidence or any other material evidence you considered and whether the monument was found or restored through acceptance of an obliterated evidence location.

I found what I believe to be the remains of an original bearing tree to the West. I set a brass capped Lunde marker at the corner using this tree.


Describe or show any material discrepancy between the location of the restored corner and that of the corner previously restored or reestablished.

NONE KNOWN


WISCONSIN COORDINATE SYSTEM
North
East
Theta Angle
Horiz. Order
Vert. Order
TYPE OF LANDMARK
SET BRASS CAP LUNDE MARKER
BEARINGS ARE REFERENCED TO
ASSUMED NORTH

RECORD OF DURABLE WITNESS MONUMENTS
MAGNETIC

NO	DESCRIPTION	BEARING	DISTANCE
1	Set P.K. Nail in 7" Hickory	S 24° W	22.63 Ft.
2	Set P.K. Nail in 5" Hickory	S 20° W	8.43 Ft.
3	Set P.K. Nail in 7" Hickory	S 24° E	38.68 Ft.
4	Set P.K. Nail in 3" Hickory	S 45° E	26.48 Ft.

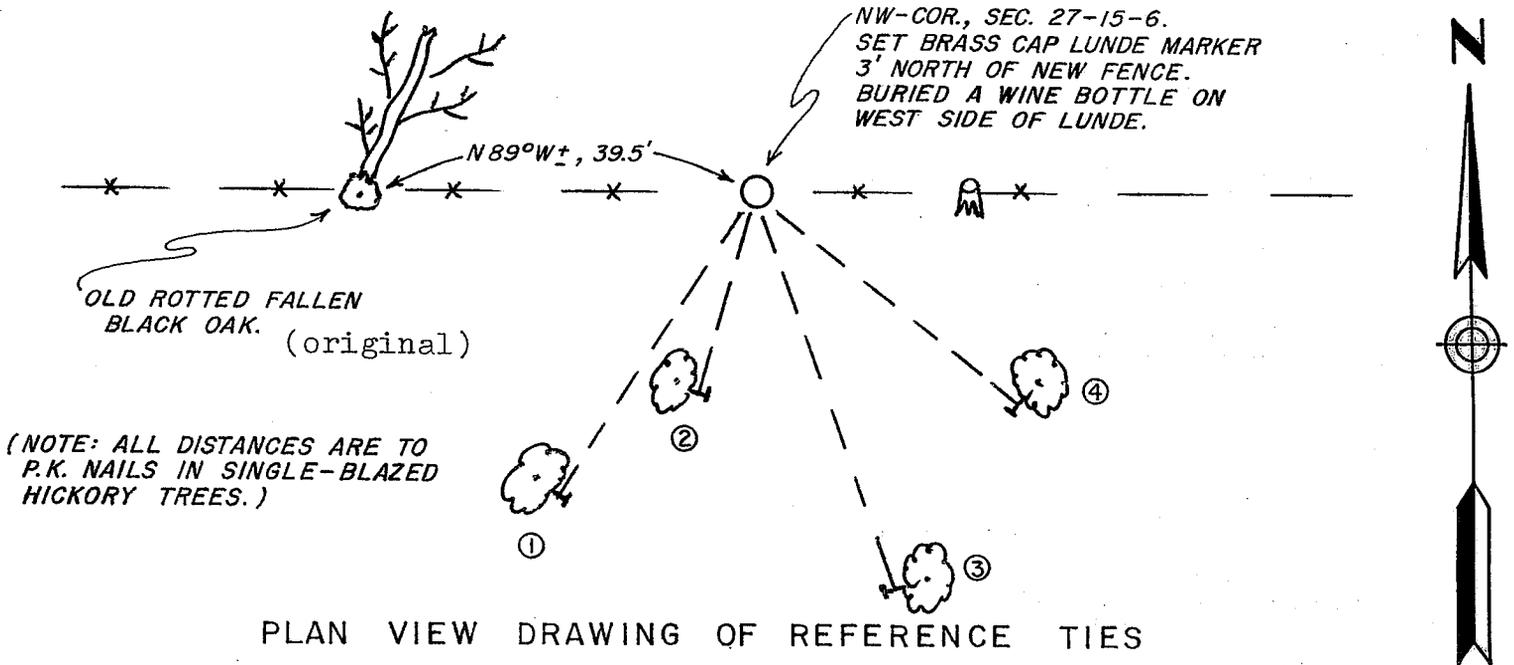

MAP SHOWING DISTANCE AND DIRECTION TO OTHER PUBLIC LAND SURVEY CORNERS USED FOR REESTABLISHING THE CORNER

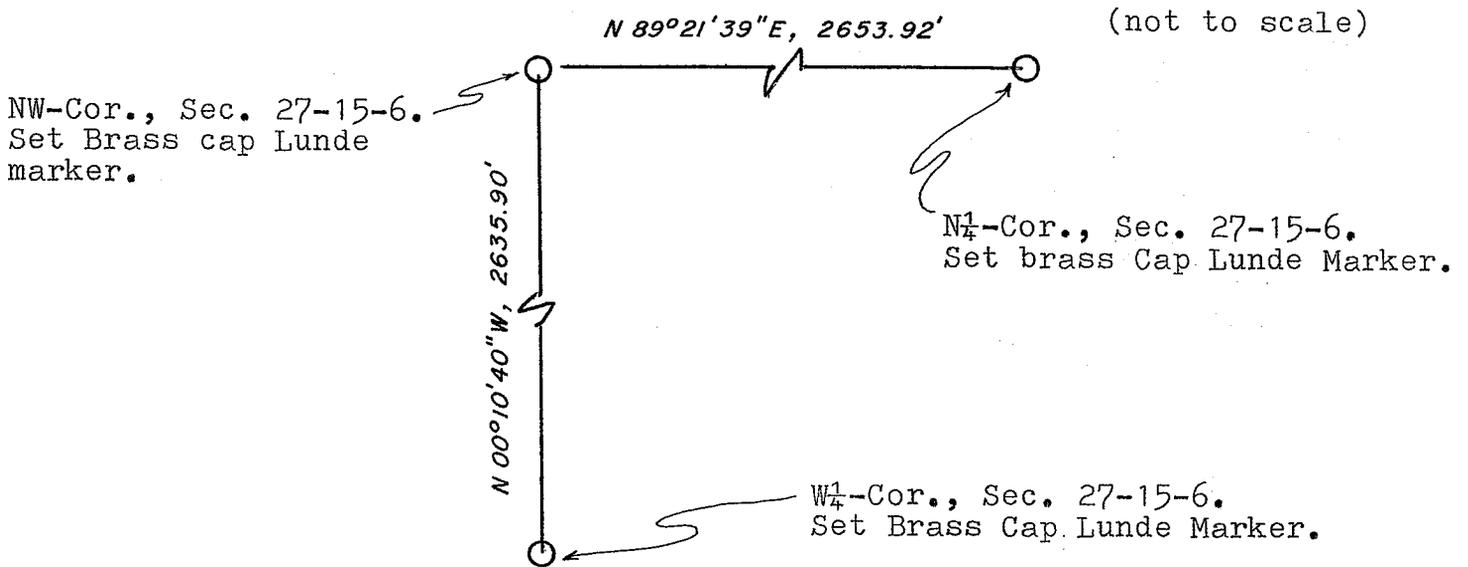

I, William C. Jung, Deputy County Surveyor
HEREBY CERTIFY THAT THE CORNER LOCATION SHOWN ON THIS RECORD
WAS DETERMINED BY ME OR UNDER MY DIRECTION AND CONTROL AND
THAT THIS U. S. PUBLIC LAND SURVEY MONUMENT RECORD IS CORRECT
AND COMPLETE TO THE BEST OF MY KNOWLEDGE AND BELIEF.

William C. Jung
Signature

December 26, 1989
Date



Seal