

21506220000


U. S. PUBLIC LAND SURVEY MONUMENT RECORD

INSTRUCTIONS: This record shall show the location of the corner and shall include all of the following nine elements (a through i).

- (a) Identify the corner by reference to the U.S. public land survey system.

○ = Corner monument restored.

Northwest Corner of Section 26,
Town 15 North, Range 6 West, Town of
Greenfield, LaCrosse County, Wisconsin.

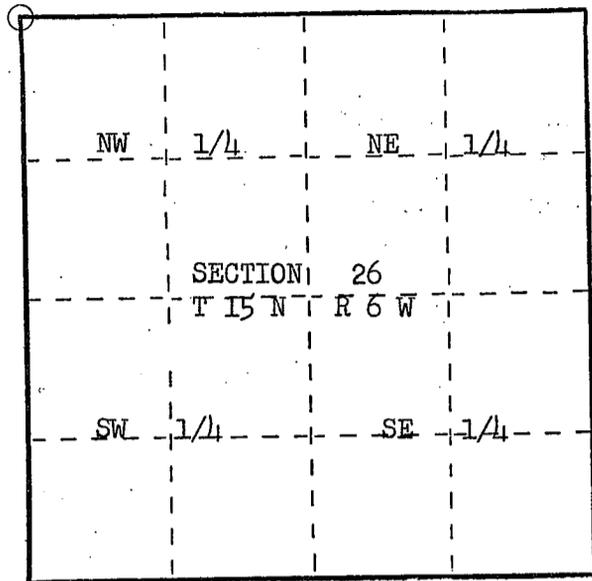

- (b) Describe any record evidence, monument evidence, occupational evidence, testimonial evidence or any other material evidence you considered, and whether the monument was found or placed.

The subdivision of Town 15 North, Range 6 West was completed by Alfred L. Brown, Deputy Surveyor, in November 1846. Resurvey work performed in 1877 by county surveyor, Mr. Middlebrook.

This corner was relocated by section corner ties as shown on Plan No. 506, County Trunk Highway "NN" Bridge Project.


Note: Fits occupational evidence. Placed Berntsen Monument.

- (c) In the plan view drawing below, provide reference ties to at least 4 witness monuments, or, if the location is within a municipality, to at least 2 witness monuments. (Witness monuments shall be made of concrete, natural stone, iron or other equally durable material.) Describe witness monuments.

- (d) Show a plan view drawing depicting the relevant monuments and reference ties which is sufficient in detail to enable accurate relocation of the corner monument if the corner monument is disturbed. Indicate north.

TIES:

1. NW CORNER OF TOWN HALL
N53°E 51.34 feet
2. SW CORNER OF TOWN HALL
N79°E 43.40 feet
3. POWER POLE #5B26W11, P.K. NORTH
SIDE 5' MORE OR LESS ABOVE GROUND.
S25°E 27.92 feet
4. POWER POLE #5B27E14, P.K. NORTH
SIDE 1' MORE OR LESS ABOVE GROUND.
S64°W 124.80 feet

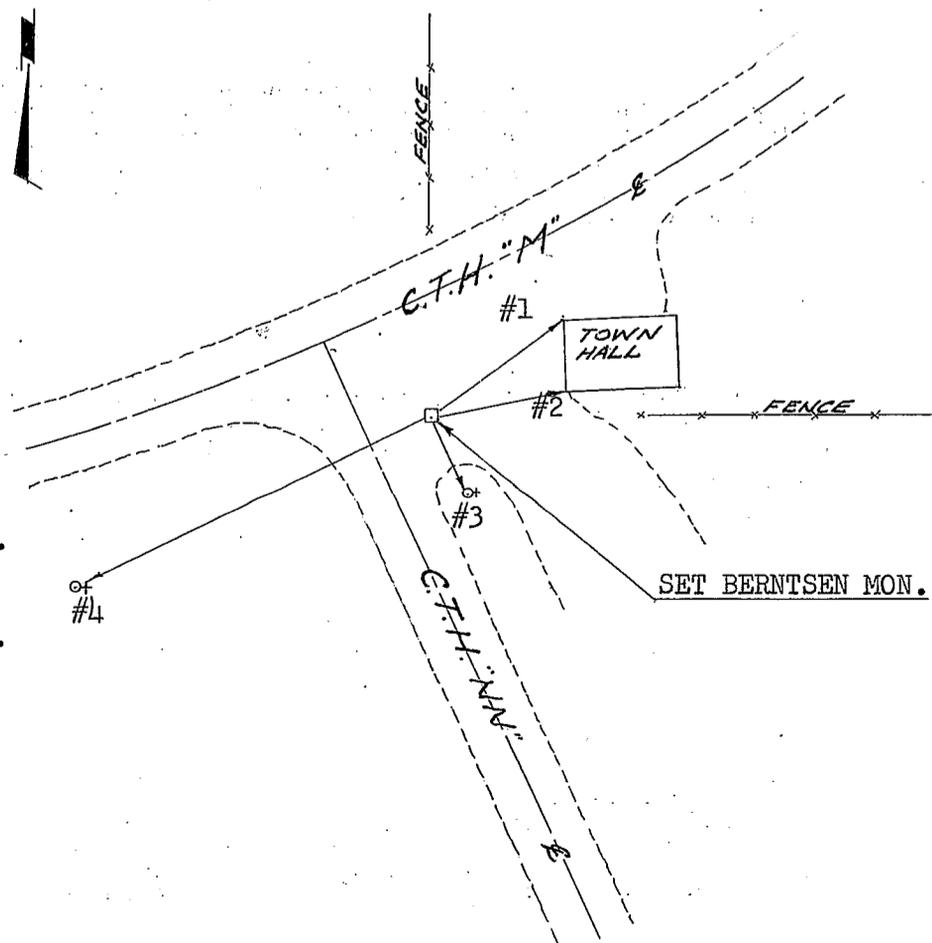

- (e) Describe any material discrepancy between the location of the corner as restored or reestablished and the location of that corner as previously restored or reestablished by distance and direction. Show the discrepancy on the plan view drawing under (d), above. Show the distances between the corner as previously restored or reestablished and (1) the corner as restored or reestablished, and (2) to at least 2 of the witness monuments shown on the drawing in (d), above.

N/A

- (f) Was the corner restored through acceptance of (1) an obliterated evidence location, or, (2) a found perpetuated location?

A found perpetuated location.

- (g&h) Was the corner reestablished through lost corner proportionate methods? If so, show the method, including the directions and distances to other public land survey corners used as evidence or used for proportioning in determining the corner location?

No. Corner was set as indicated in section (b).

- (i) I, Robert M. Lampman, R.L.S. S-1296
(type or print name) certify that the corner location shown on this record was determined by me or under my direction and control and that this U.S. Public Land Survey Monument Record is correct and complete to the best of my knowledge and belief.

Robert M. Lampman
Signature

6-24-83
Date

