


U. S. PUBLIC LAND SURVEY MONUMENT RECORD

SECTION 27 T 15 N, R 6 W, TOWN OF GREENFIELD  
 LA CROSSE COUNTY

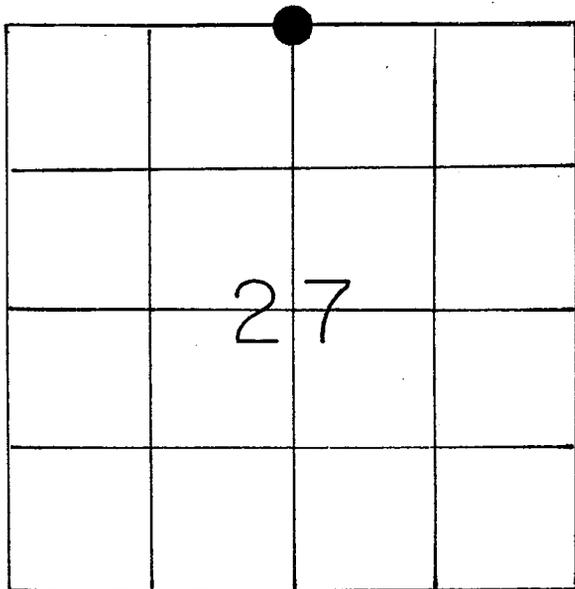

LOCATION OF LANDMARK

WISCONSIN COORDINATE SYSTEM
North
East
Theta Angle
Horiz. Order
Vert. Order
TYPE OF LANDMARK
SET LUNDE CAP ON IRON PIPE
BEARINGS ARE REFERENCED TO
ASSUMED NORTH

Crew: WILLIAM C. JUNG  
 PETER F. FOLLANSBEE

Date: 4/26/1989

Describe any record evidence, monument evidence, testimonial evidence or any other material evidence you considered and whether the monument was found or restored through acceptance of an obliterated evidence location.

I set the corner equidistant between the section corners and on line with the section line as established by Maxwell with his surveys to the East. This causes there to be a bend at this corner, but this location best fits the field evidence. I set a brass capped Lunde cap on an iron pipe in a rock mound.


Describe or show any material discrepancy between the location of the restored corner and that of the corner previously restored or reestablished.

NONE KNOWN

RECORD OF DURABLE WITNESS MONUMENTS  
MAGNETIC

NO	DESCRIPTION	BEARING	DISTANCE
1	Set P.K. Nail in 10" White Oak(Dbl. Blzd)	S 70° W	13.39 Ft.
2	Set P.K. Nail in 18" Burr Oak (Sgl. Blzd)	N 56° W	54.05 Ft.
3	Set P.K. Nail in 11" White Oak(Dbl. Blzd)	N 34° E	29.69 Ft.
4	Set P.K. Nail in 11" White Oak(Dbl. Blzd)	N 63° E	23.65 Ft.


(NOT TO SCALE)

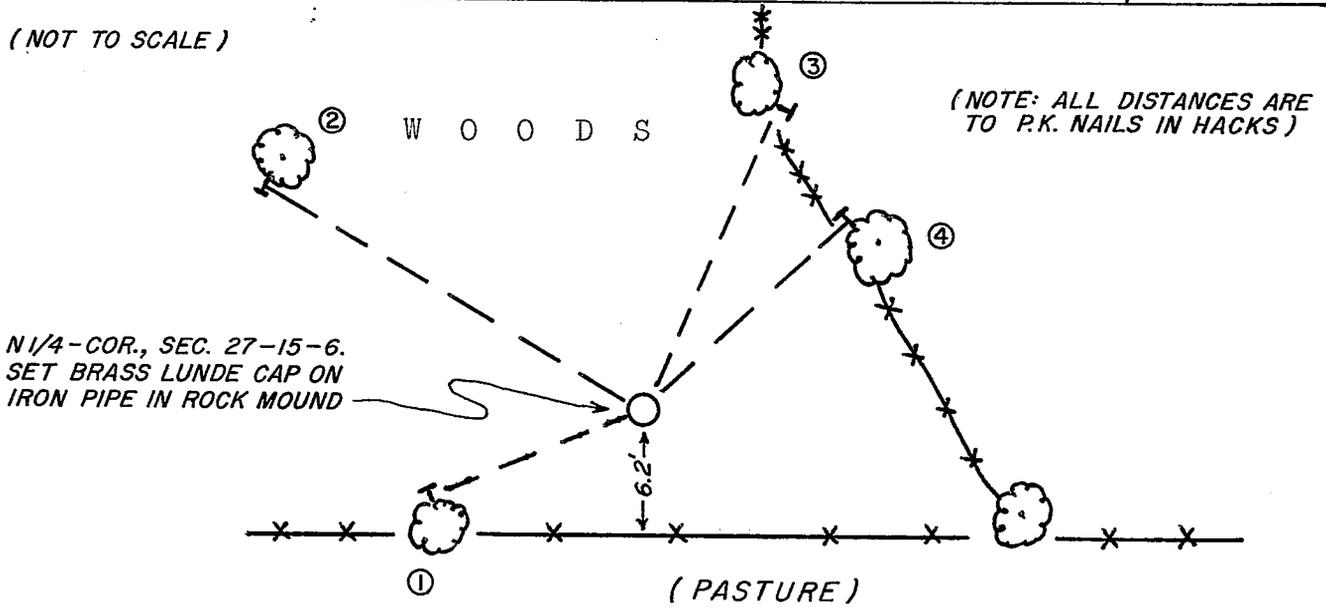

PLAN VIEW DRAWING OF REFERENCE TIES

MAP SHOWING DISTANCE AND DIRECTION TO OTHER PUBLIC LAND SURVEY CORNERS USED FOR REESTABLISHING THE CORNER

(not to scale)

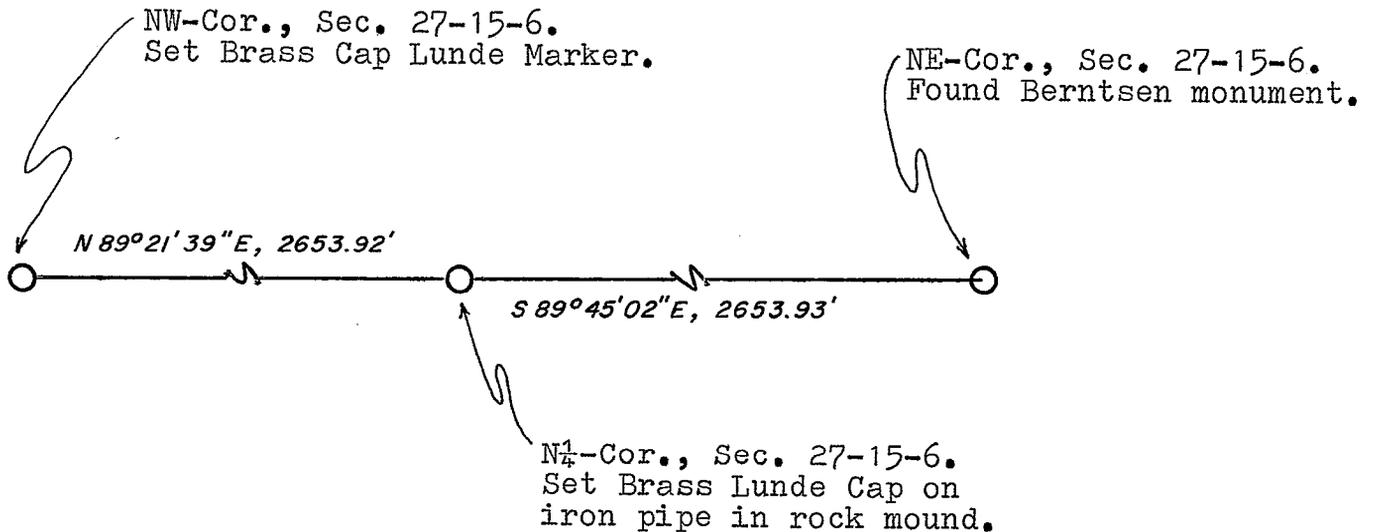

I, William C. Jung, Deputy County Surveyor  
HEREBY CERTIFY THAT THE CORNER LOCATION SHOWN ON THIS RECORD  
WAS DETERMINED BY ME OR UNDER MY DIRECTION AND CONTROL AND  
THAT THIS U. S. PUBLIC LAND SURVEY MONUMENT RECORD IS CORRECT  
AND COMPLETE TO THE BEST OF MY KNOWLEDGE AND BELIEF.

William C. Jung  
Signature

December 26, 1989  
Date



Seal