


U. S. PUBLIC LAND SURVEY MONUMENT RECORD

SECTION 23 T 15 N, R 6 W, TOWN OF Greenfield
 LA CROSSE COUNTY

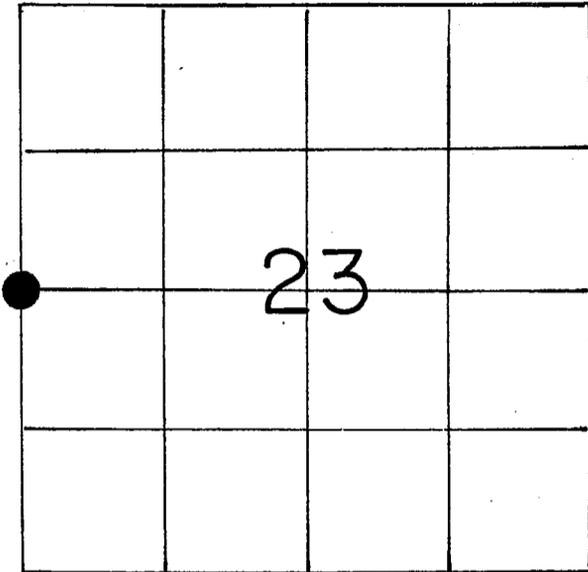

LOCATION OF LANDMARK

Crew: William C. Jung
 Peter F. Follansbee

Date: March 21, 1994

Describe any record evidence, monument evidence, testimonial evidence or any other material evidence you considered and whether the monument was found or restored through acceptance of an obliterated evidence location.

I set this corner by single proportionate measurement.


Describe or show any material discrepancy between the location of the restored corner and that of the corner previously restored or reestablished.

None known.

WISCONSIN COORDINATE SYSTEM
North
East
Theta Angle
Horiz. Order
Vert. Order
TYPE OF LANDMARK
Brass capped Lunde marker
BEARINGS ARE REFERENCED TO
True

RECORD OF DURABLE WITNESS MONUMENTS
MAGNETIC


NO	DESCRIPTION	BEARING	DISTANCE
1	Set P.K. Nail in NW-side 12" Hickory(dbl. blazed)	N 44° E	Sl.= 30.13'
2	Set P.K. Nail in N.-side 15" W. Oak (dbl. blazed)	S 55° E	Sl.= 64.89'
3	Existing 1" Iron Pipe.	S 23° E	40.87 Ft.
4	Center of 3½" gas pipe furthest north.	S 20° E	Sl.=109.66'

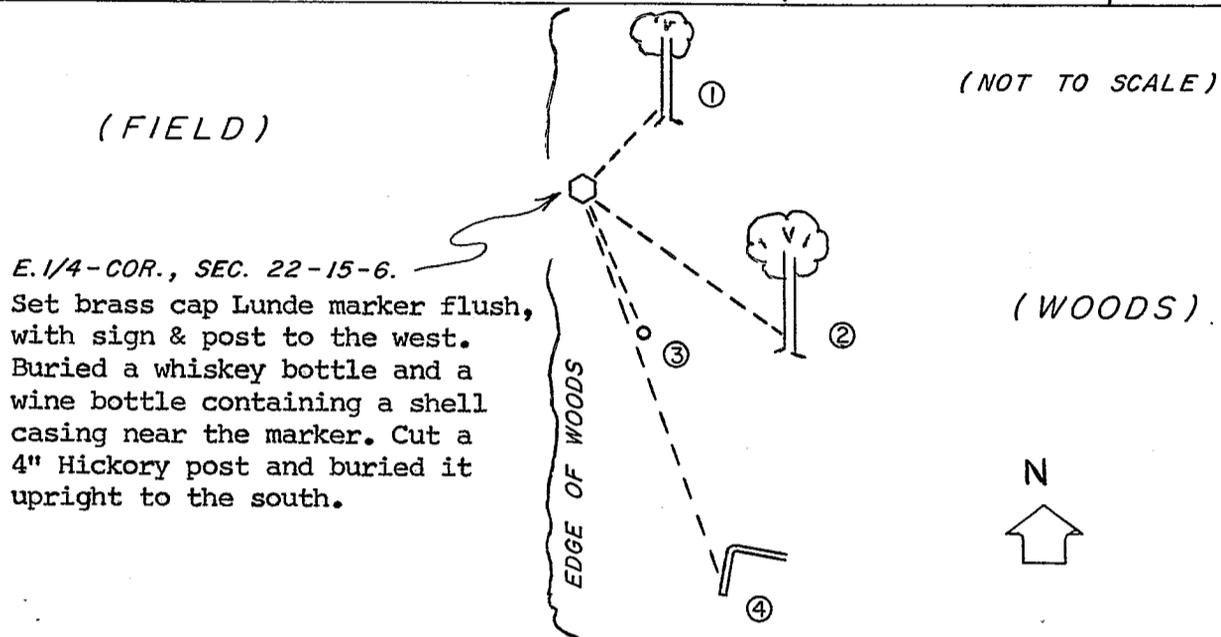

PLAN VIEW DRAWING OF REFERENCE TIES

MAP SHOWING DISTANCE AND DIRECTION TO OTHER PUBLIC LAND SURVEY CORNERS USED FOR REESTABLISHING THE CORNER


(not to scale)

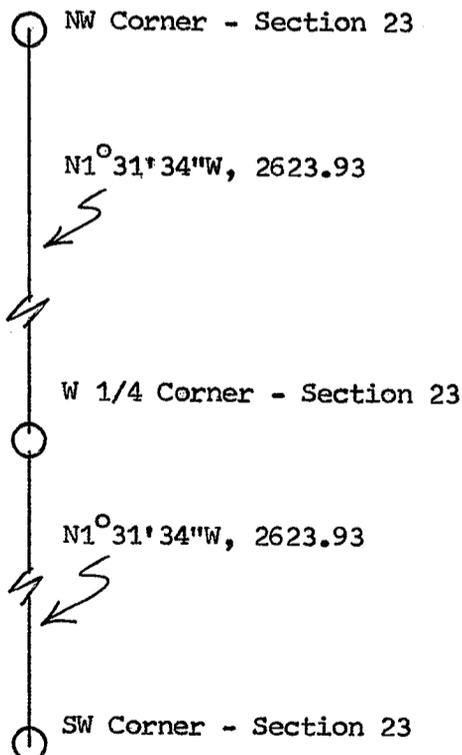

I, William C. Jung, County Surveyor,
HEREBY CERTIFY THAT THE CORNER LOCATION SHOWN ON THIS RECORD WAS DETERMINED BY ME OR UNDER MY DIRECTION AND CONTROL AND THAT THIS U. S. PUBLIC LAND SURVEY MONUMENT RECORD IS CORRECT AND COMPLETE TO THE BEST OF MY KNOWLEDGE AND BELIEF.

William C. Jung
Signature

April 25, 1994
Date

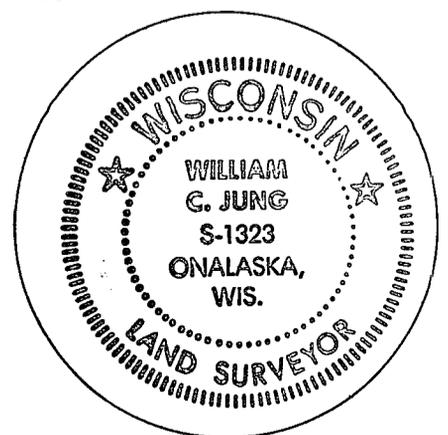

Seal