


21506232000

## U. S. PUBLIC LAND SURVEY MONUMENT RECORD

SECTION 23 T 15 N, R 6 W, TOWN OF GREENFIELD

LA CROSSE COUNTY

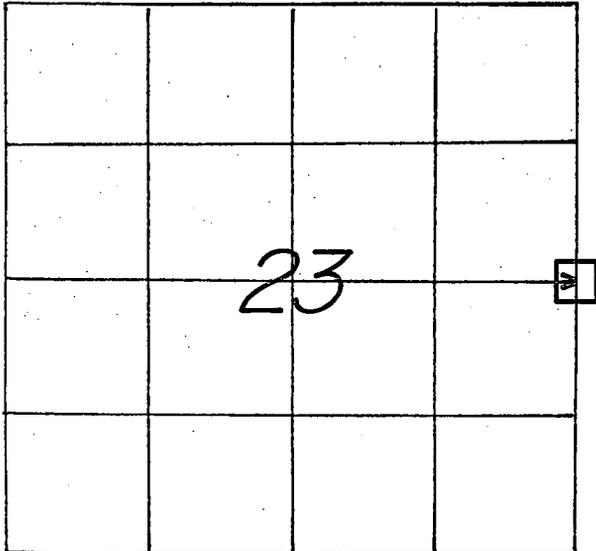

LOCATION OF LANDMARK

CREW: WILLIAM C. JUNG  
 PETER F. FOLLANSBEE  
 DATE: 11/03/2004

WISCONSIN COORDINATE SYSTEM
North
East
Theta Angle
Horiz. Order
Vert. Order
TYPE OF LANDMARK
<i>FLAT FIELD STONE.</i>
BEARINGS ARE REFERENCED TO

Describe any record evidence, monument evidence, testimonial evidence or any other material evidence you considered and whether the monument was found or restored through acceptance of an obliterated evidence location.


In an earlier plat of survey Steve Solberg shows that he found a stone at this corner. In July of this year Chris Fechner also found and used this stone in a survey. It falls on line with the fence further South and is 3 to 4 feet North of the fence to the West. Fechner's measurements indicate that the stone fits the section corners North and South very well. Like Solberg and Fechner, I accepted the stone as the best available evidence of the original government corner position.

Describe or show any material discrepancy between the location of the restored corner and that of the corner previously restored or reestablished.

This location does not agree with the position of this corner as shown on Dick Berg's section sketch, dated 6/23/80.


RECORD OF DURABLE WITNESS MONUMENTS

NO	DESCRIPTION	MAGNETIC BEARING	DISTANCE
1	SET A 3/4"x30" IRON BAR WITH A RED PLASTIC CAP, FLUSH	S 87° W	17.98 FT.
2	SET A NAIL IN N.W.-SIDE OF A 10-1/2" HICKORY	S 57° W	34.41 FT.
3	SET A NAIL IN N.W.-SIDE OF A 6-1/2" HICKORY	S 33° W	22.87 FT.
4	SET A NAIL IN W.-SIDE OF A 48" OAK	S 30° E	3.62 FT.

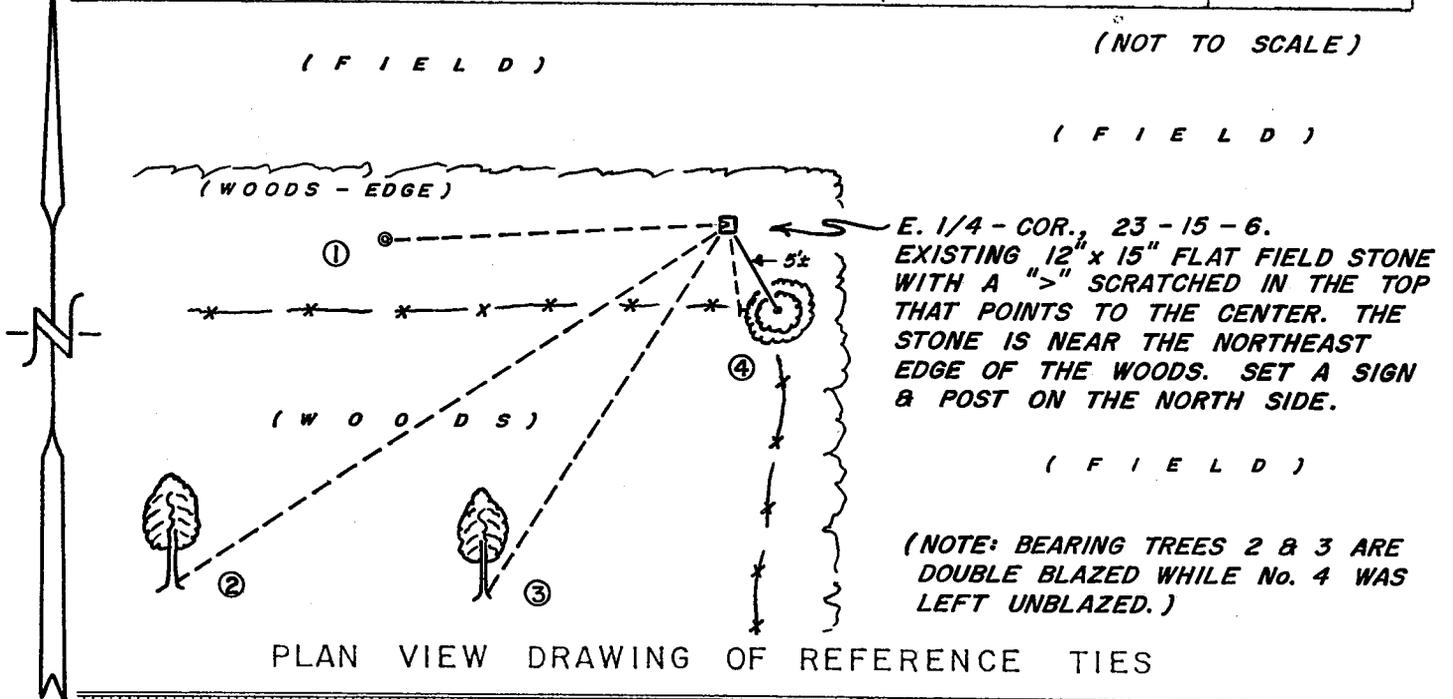

MAP SHOWING DISTANCE AND DIRECTION TO OTHER PUBLIC LAND SURVEY CORNERS USED FOR REESTABLISHING THE CORNER

( C. FECHNER MEASUREMENTS )  
( ASSUMED NORTH )

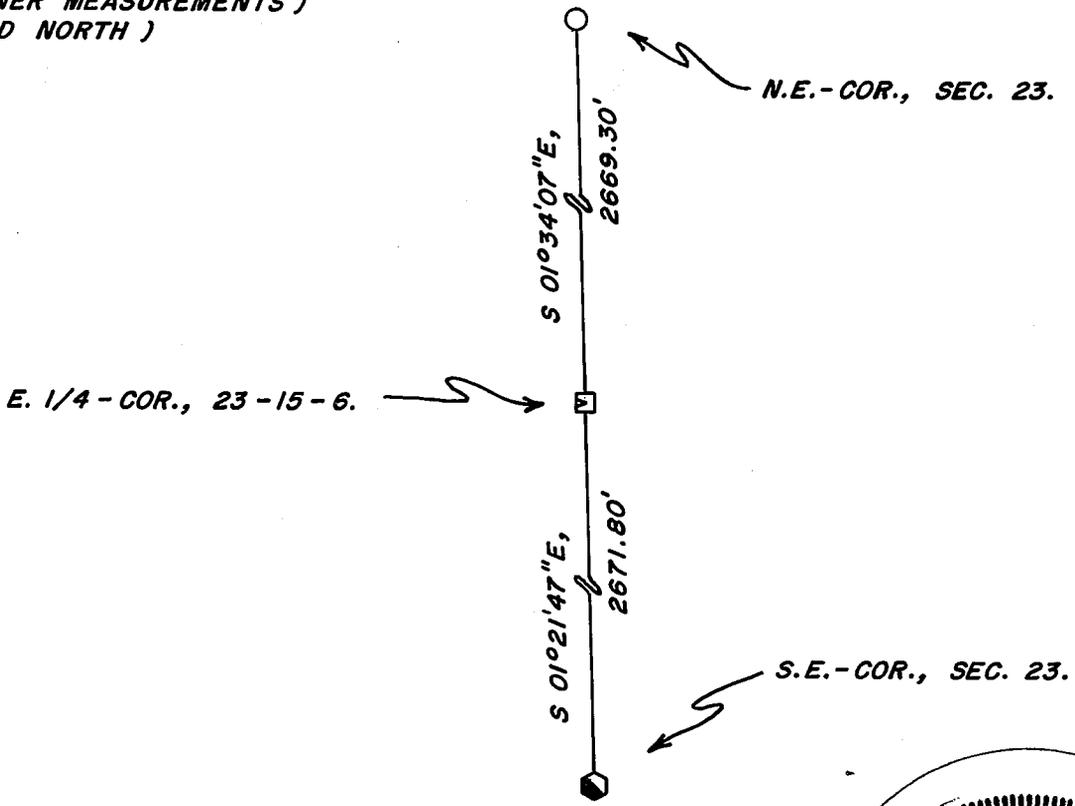

I, WILLIAM C. JUNG, COUNTY SURVEYOR  
HEREBY CERTIFY THAT THE CORNER LOCATION SHOWN ON THIS RECORD WAS DETERMINED BY ME OR UNDER MY DIRECTION AND CONTROL AND THAT THIS U. S. PUBLIC LAND SURVEY MONUMENT RECORD IS CORRECT AND COMPLETE TO THE BEST OF MY KNOWLEDGE AND BELIEF.

William C. Jung 11/10/04  
Signature Date



Seal