


## U. S. PUBLIC LAND SURVEY MONUMENT RECORD

SECTION 25 T 15 N, R 6 W, TOWN OF GREENFIELD

LA CROSSE COUNTY

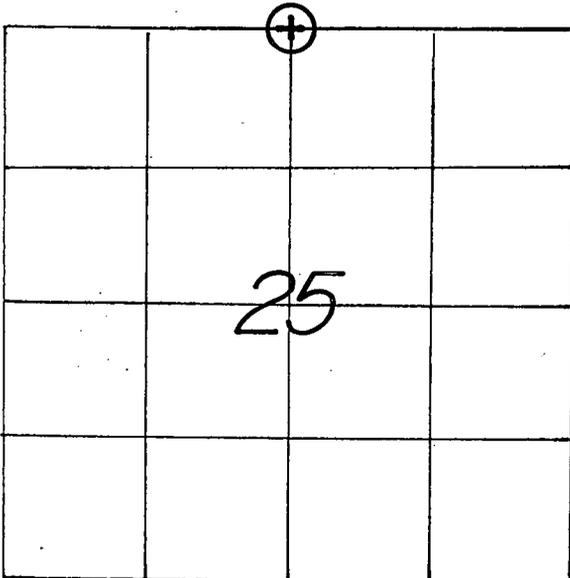

LOCATION OF LANDMARK

CREW: WILLIAM C. JUNG  
 PETER F. FOLLANSBEE  
 DATE: 9/09/2008

WISCONSIN COORDINATE SYSTEM

North

East

Theta Angle

Horiz. Order

Vert. Order

TYPE OF LANDMARK

3/4" x 30" IRON BAR WITH AN ALUMINUM CAP

BEARINGS ARE REFERENCED TO

Describe any record evidence, monument evidence, testimonial evidence or any other material evidence you considered and whether the monument was found or restored through acceptance of an obliterated evidence location.

One of the ties called for in the original government survey was the point of a rock, 4 feet high, N74°E, 52.14 feet. In 1877 Middlebrook, the County Surveyor, calls for a 8" white oak, N11°E, 3.96 feet. I set a capped iron bar S72°W, 52.14 feet from the point of a 4 foot high rock. The iron bar is S15°E, 4 feet from the center of a dead old 18" white oak. Was Middlebrook's bearing off? Set a sign on a 4½" elm sapling to the Northeast. The center of this sapling is 0.9 feet from the corner.


Describe or show any material discrepancy between the location of the restored corner and that of the corner previously restored or reestablished.

from my corner

About N1°W, 7.11 feet, I found a 1¾" iron pipe. It falls at S80°W, 51.19 feet from the rock high point. If this was intended to be the corner, I do not agree with it.

RECORD OF DURABLE WITNESS MONUMENTS

NO	DESCRIPTION	MAGNETIC	
		BEARING	DISTANCE
1	SET A NAIL IN N.W.-SIDE OF A 19-1/2" WHITE OAK	S 33° W	33.13 FT.
2	SET A NAIL IN S.E.-SIDE OF AN 18-1/2" WHITE OAK	S 77° W	32.08 FT.
3	SET A NAIL IN E.-SIDE OF A DOUBLE WHITE OAK	N 01° E	21.75 FT.
4	MEAS'NT TO HIGH POINT ON N.E.-SIDE OF 4' HIGH ROCK	N 72° E	52.14 FT.

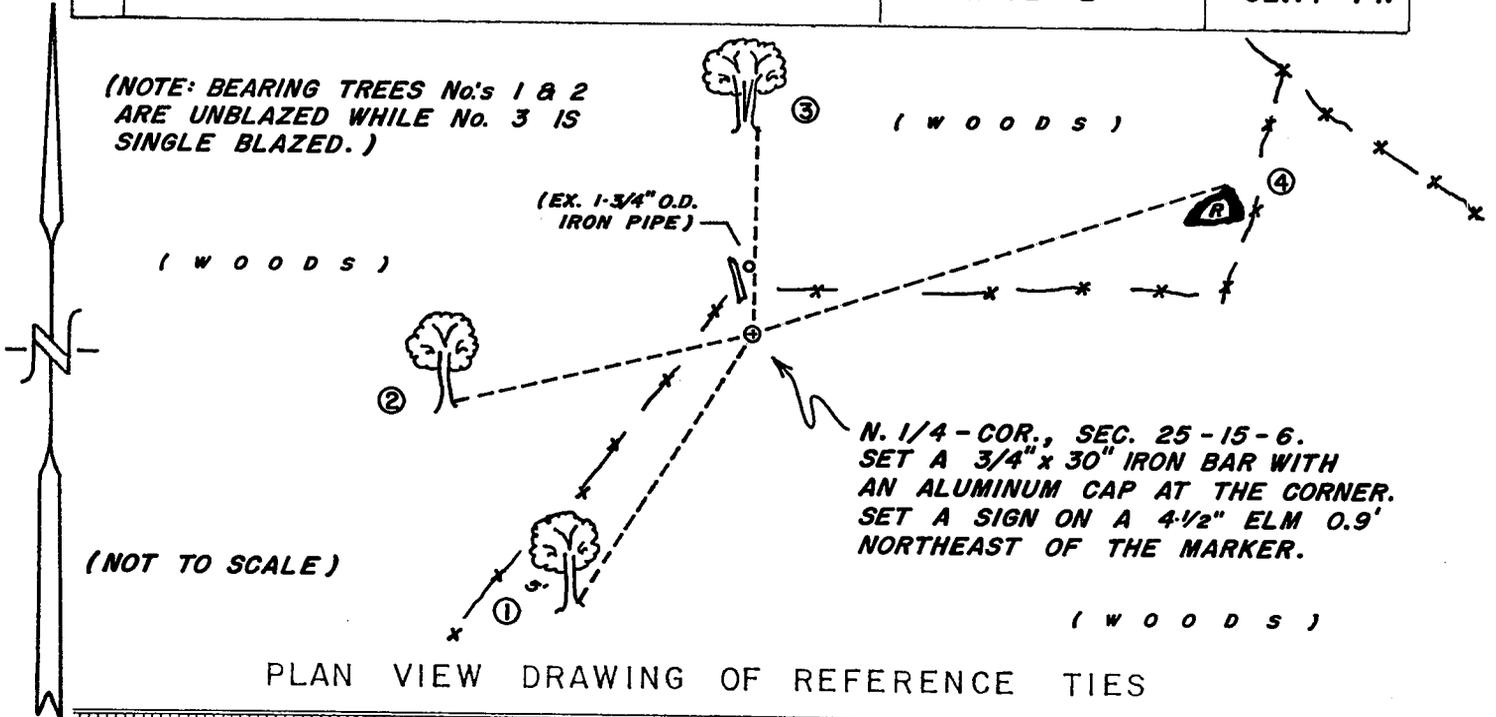


MAP SHOWING DISTANCE AND DIRECTION TO OTHER PUBLIC LAND SURVEY CORNERS USED FOR REESTABLISHING THE CORNER

(No further section measurements were made by me at this time.)

I, WILLIAM C. JUNG, COUNTY SURVEYOR  
 HEREBY CERTIFY THAT THE CORNER LOCATION SHOWN ON THIS RECORD  
 WAS DETERMINED BY ME OR UNDER MY DIRECTION AND CONTROL AND  
 THAT THIS U. S. PUBLIC LAND SURVEY MONUMENT RECORD IS CORRECT  
 AND COMPLETE TO THE BEST OF MY KNOWLEDGE AND BELIEF.

William C. Jung  
 Signature

10/29/08  
 Date

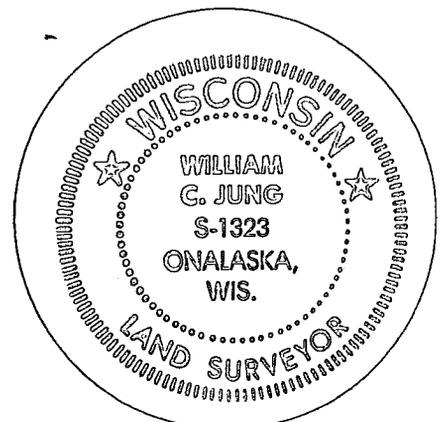

Seal