


U. S. PUBLIC LAND SURVEY MONUMENT RECORD

SECTION 26 T 15 N, R 6 W, TOWN OF GREENFIELD  
 LA CROSSE COUNTY

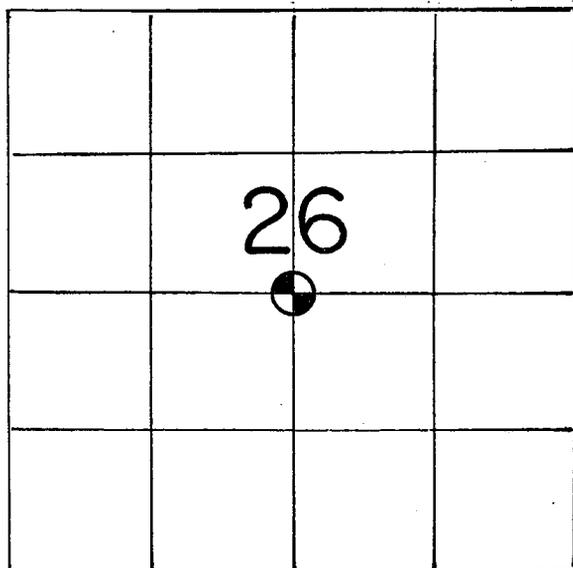

LOCATION OF LANDMARK

WISCONSIN COORDINATE SYSTEM
North
East
Theta Angle
Horiz. Order
Vert. Order
TYPE OF LANDMARK
Existing Berntsen marker.
BEARINGS ARE REFERENCED TO

Crew: WILLIAM C. JUNG  
 PETER F. FOLLANSBEE  
 Date: 8/08/1995

Describe any record evidence, monument evidence, testimonial evidence or any other material evidence you considered and whether the monument was found or restored through acceptance of an obliterated evidence location.


Rob Lampman set a Berntsen marker at this corner in 1983. I found and tied off his marker.

Describe or show any material discrepancy between the location of the restored corner and that of the corner previously restored or reestablished.

None Known.

RECORD OF DURABLE WITNESS MONUMENTS

NO	DESCRIPTION	BEARING	DISTANCE
1	Set P.K. Nail in NE-side double-trunk Crabapple	Northwesterly $\pm$	27.03 Ft.
2	Set P.K. Nail in NW-side 6½" Cedar	Northeasterly $\pm$	17.70 Ft.
3	Set P.K. Nail in S.-side 3½" Oak	Easterly $\pm$	15.61 Ft.
4	Set P.K. Nail in SE-side 3" Oak	Southwesterly $\pm$	3.08 Ft.

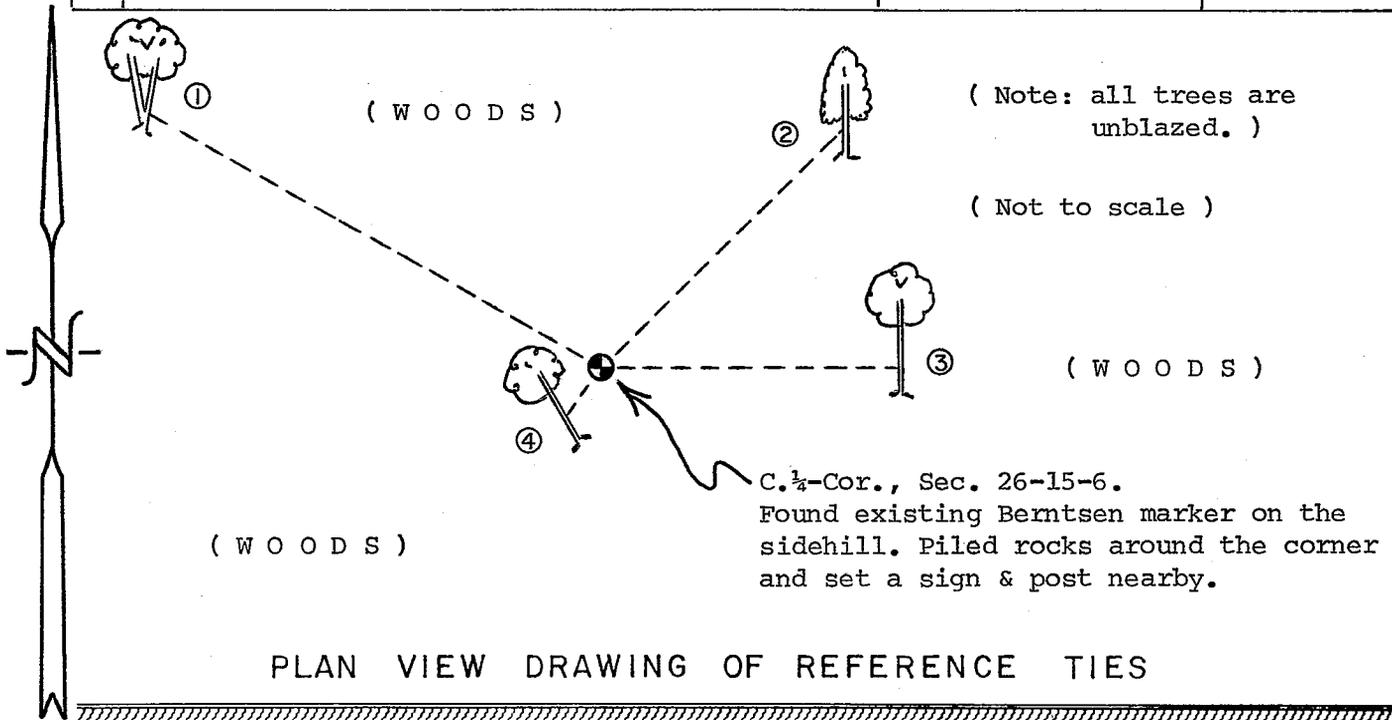

MAP SHOWING DISTANCE AND DIRECTION TO OTHER PUBLIC LAND SURVEY CORNERS USED FOR REESTABLISHING THE CORNER

This corner location was confirmed by Lampman in previous work.

I, William C. Jung, County Surveyor  
 HEREBY CERTIFY THAT THE CORNER LOCATION SHOWN ON THIS RECORD  
 WAS DETERMINED BY ME OR UNDER MY DIRECTION AND CONTROL AND  
 THAT THIS U. S. PUBLIC LAND SURVEY MONUMENT RECORD IS CORRECT  
 AND COMPLETE TO THE BEST OF MY KNOWLEDGE AND BELIEF.

William C. Jung                      9/6/95  
 Signature                                      Date



Seal