


U. S. PUBLIC LAND SURVEY MONUMENT RECORD

SECTION 26 T 15 N, R 6 W, TOWN OF GREENFIELD
 LA CROSSE COUNTY

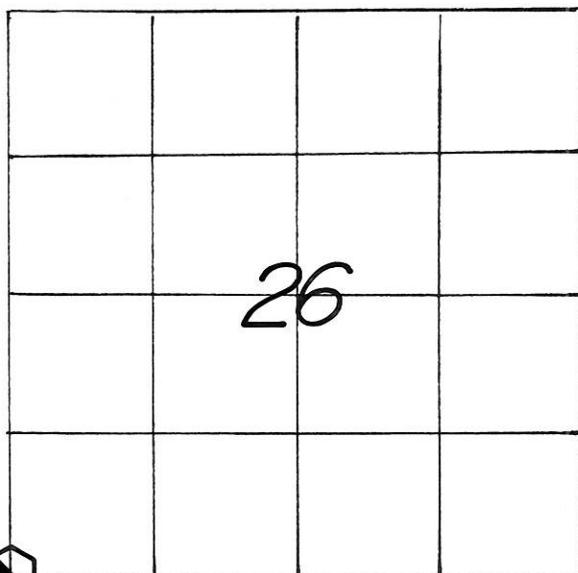

WISCONSIN COORDINATE SYSTEM	
North	635,813.127
East	1,685,512.546
Theta Angle	
Horiz. Order	
Vert. Order	
DATUM:	NAD 1983('91)
TYPE OF LANDMARK	
BERNTSEN MARKER.	
BEARINGS ARE REFERENCED TO	
GRID NORTH AS PER SECTION DATA.	

LOCATION OF LANDMARK
CREW: BRYAN H. MEYER
PETER F. FOLLANSBEE
DATE: 9/21/2009


Describe any record evidence, monument evidence, testimonial evidence or any other material evidence you considered and whether the monument was found or restored through acceptance of an obliterated evidence location.

Describe or show any material discrepancy between the location of the restored corner and that of the corner previously restored or reestablished.

RECORD OF DURABLE WITNESS MONUMENTS


MAGNETIC

NO	DESCRIPTION	BEARING	DISTANCE
1	EX. NAIL IN THE SIDE OF A 7" ELM	N 02° E	17.53 FT.
2	SET A NEW NAIL IN S.E.-SIDE OF A 16" WALNUT	N 30° E	29.88 FT.
3	SET A NEW NAIL IN S.-SIDE OF A 9-1/2" ELM	N 70° E	20.22 FT.
4	SET A NAIL IN N.W.-ROOT OF A 10-1/2" HACKBERRY	N 89° E	13.04 FT.

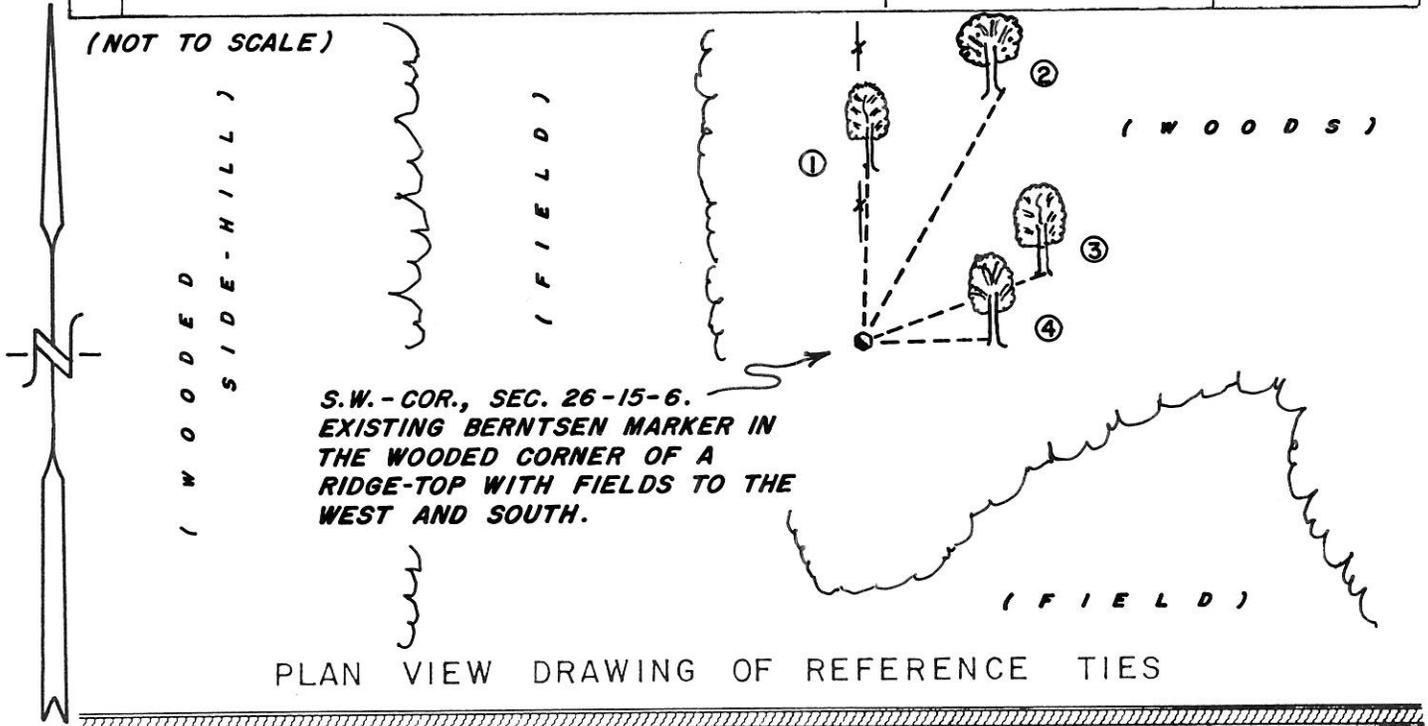

MAP SHOWING DISTANCE AND DIRECTION TO OTHER PUBLIC LAND SURVEY CORNERS USED FOR REESTABLISHING THE CORNER

(GRID BEARINGS AND DISTANCES)
(GRID FACTOR: 0.999888)
(NOT TO SCALE)

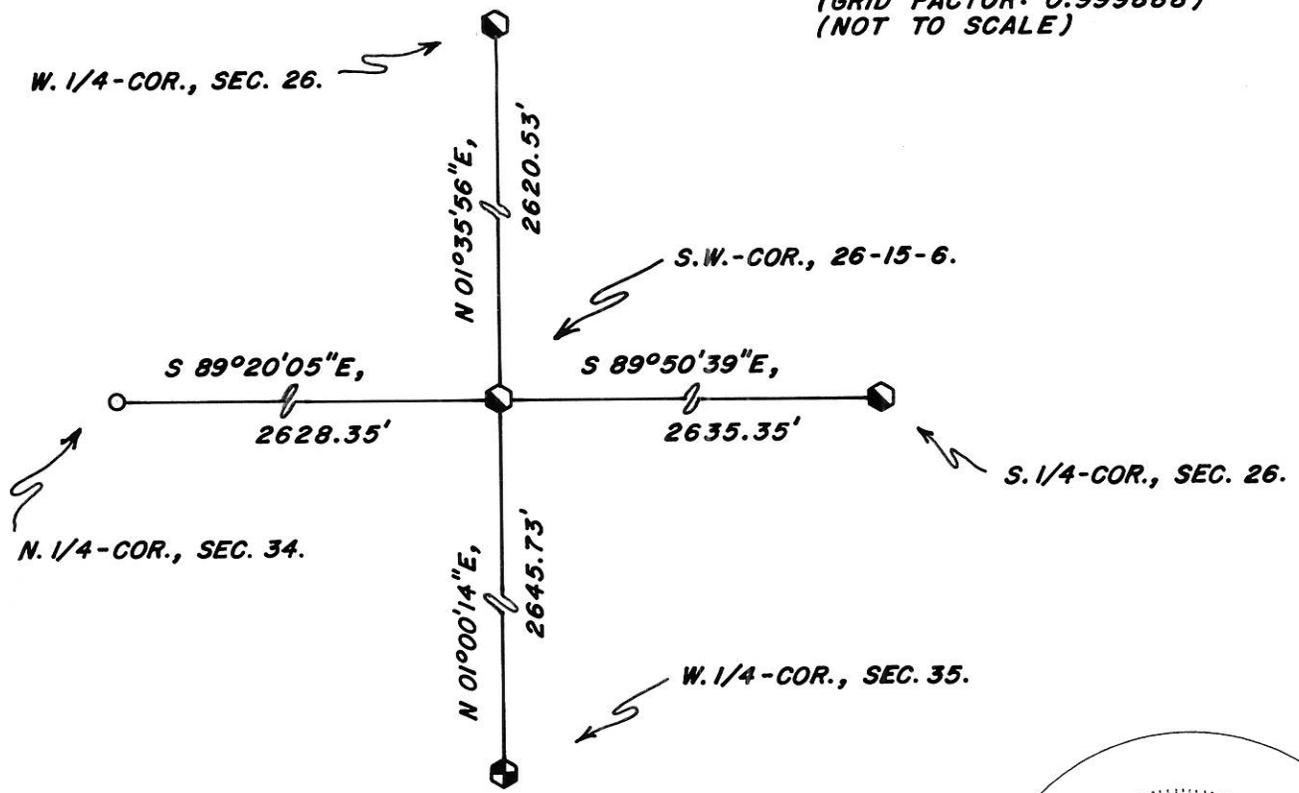

I, BRYAN H. MEYER, COUNTY SURVEYOR
 HEREBY CERTIFY THAT THE CORNER LOCATION SHOWN ON THIS RECORD
 WAS DETERMINED BY ME OR UNDER MY DIRECTION AND CONTROL AND
 THAT THIS U. S. PUBLIC LAND SURVEY MONUMENT RECORD IS CORRECT
 AND COMPLETE TO THE BEST OF MY KNOWLEDGE AND BELIEF.

Signature: [Signature] Date: 9/30/2009



Seal


U. S. PUBLIC LAND SURVEY MONUMENT RECORD

INSTRUCTIONS: This record shall show the location of the corner and shall include all of the following nine elements (a through i).

(a) Identify the corner by reference to the U.S. public land survey system.

○ = Corner monument restored.

Southwest Corner of Section 26,
Town 15 North, Range 6 West, Town of
Greenfield, LaCrosse County, Wisconsin.

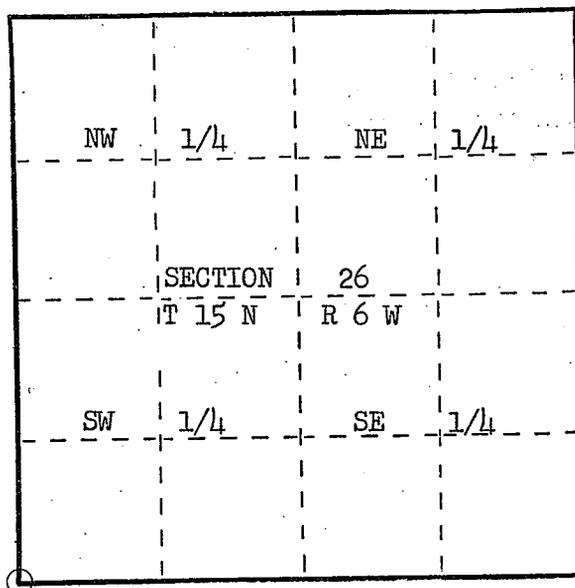

(b) Describe any record evidence, monument evidence, occupational evidence, testimonial evidence or any other material evidence you considered, and whether the monument was found or placed.

The subdivision of Town 15 North, Range 6 West was completed by Alfred L. Brown, Deputy Surveyor, in November 1846.


Corner was re-established by acceptance of occupational evidence. Placed Berntsen Monument.

(c) In the plan view drawing below, provide reference ties to at least 4 witness monuments, or, if the location is within a municipality, to at least 2 witness monuments. (Witness monuments shall be made of concrete, natural stone, iron or other equally durable material.) Describe witness monuments.

(d) Show a plan view drawing depicting the relevant monuments and reference ties which is sufficient in detail to enable accurate relocation of the corner monument if the corner monument is disturbed. Indicate north.

TIES:

- 1. ELM 4" DIAM. N 2° E 17.42 FEET
- 2. WALNUT 10" DIAM. N30° E 29.81 FEET
- 3. ELM 4" DIAM. N70° E 20.47 FEET
- 4. ELM 8" DIAM. S78° E 28.71 FEET

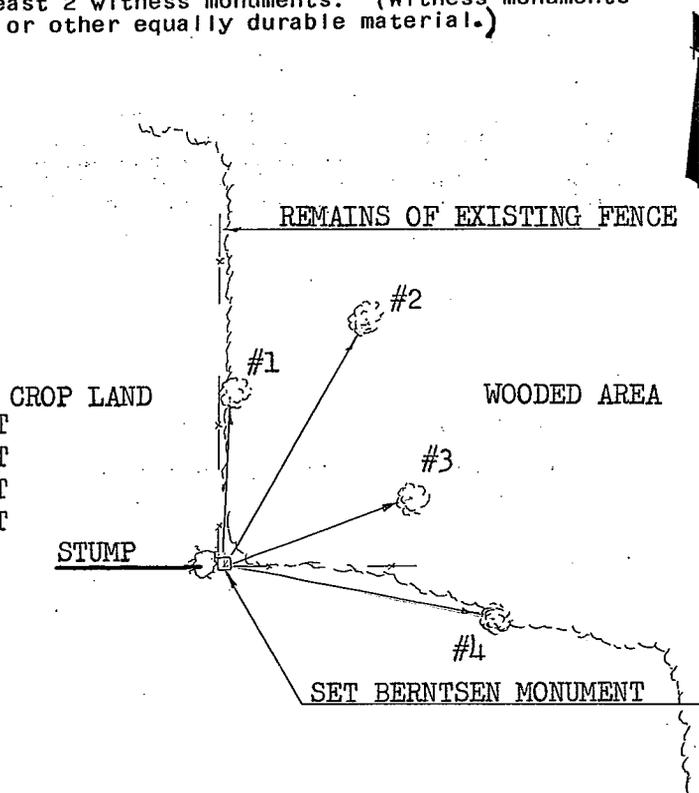

- (e) Describe any material discrepancy between the location of the corner as restored or reestablished and the location of that corner as previously restored or reestablished by distance and direction. Show the discrepancy on the plan view drawing under (d), above. Show the distances between the corner as previously restored or reestablished and (1) the corner as restored or reestablished, and (2) to at least 2 of the witness monuments shown on the drawing in (d), above.

N/A

- (f) Was the corner restored through acceptance of (1) an obliterated evidence location, or, (2) a found perpetuated location?

An obliterated evidence location.

- (g&h) Was the corner reestablished through lost corner proportionate methods? If so, show the method, including the directions and distances to other public land survey corners used as evidence or used for proportioning in determining the corner location?

Corner re-established by acceptance of occupational evidence.

- (i) I, Robert M. Lampman R.L.S. S-1296
(type or print name) certify that the corner location shown on this record was determined by me or under my direction and control and that this U.S. Public Land Survey Monument Record is correct and complete to the best of my knowledge and belief.

Robert M. Lampman
Signature

6-24-23
Date

