


21506270020

U. S. PUBLIC LAND SURVEY MONUMENT RECORD

SECTION 27 T 15 N, R 6 W, TOWN OF Greenfield

LA CROSSE COUNTY

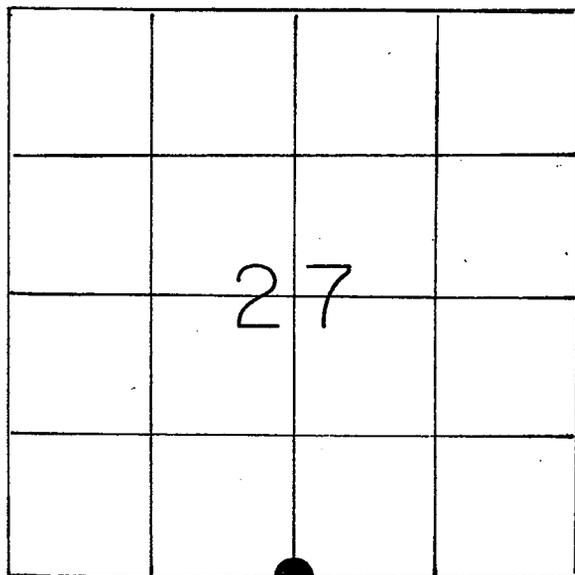

LOCATION OF LANDMARK

Crew: William C. Jung
Peter Follansbee

Date: April 12, 1989

Describe any record evidence, monument evidence, testimonial evidence or any other material evidence you considered and whether the monument was found or restored through acceptance of an obliterated evidence location.

The original notes called for a post in a stone mound. Follansbee and I found what we believe to be the remnants of the original survey stone mound. The rest of the mound was scattered down the slope 10' or so. The remnants were in the shape of a fire pit with the middle open where the post would have been. We set a 1" iron pipe in the center and rebuilt the stone mound around it.

Describe or show any material discrepancy between the location of the restored corner and that of the corner previously restored or reestablished.

None known.

WISCONSIN COORDINATE SYSTEM

North

East

Theta Angle

Horiz. Order

Vert. Order

TYPE OF LANDMARK


1" iron pipe in stone mound

BEARINGS ARE REFERENCED TO

Assumed North


RECORD OF DURABLE WITNESS MONUMENTS
Magnetic

NO	DESCRIPTION	BEARING	DISTANCE
1	P.K. in double blazed white oak	N70°W	slope=94.15
2	" " " " 11" white oak	N63°W	6.77
3	" " " " 12" " "	N19°W	16.26
4	" " " " 13" hickory	N15°W	37.70

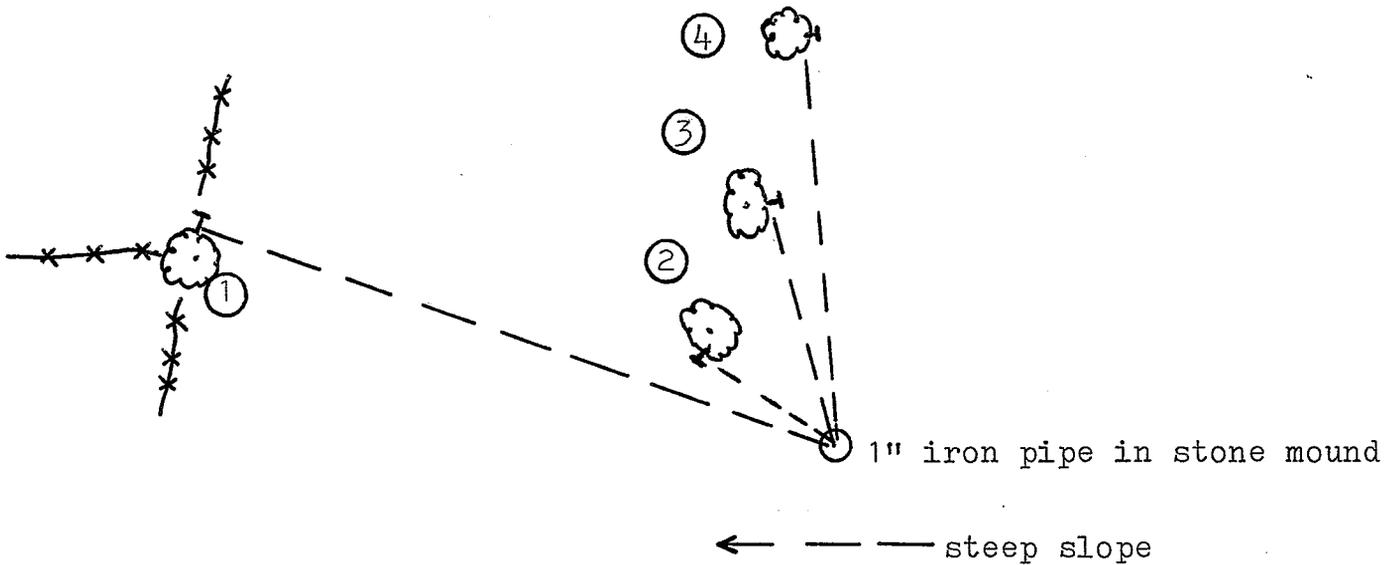


PLAN VIEW DRAWING OF REFERENCE TIES

MAP SHOWING DISTANCE AND DIRECTION TO OTHER PUBLIC LAND SURVEY CORNERS USED FOR REESTABLISHING THE CORNER
(not to scale)

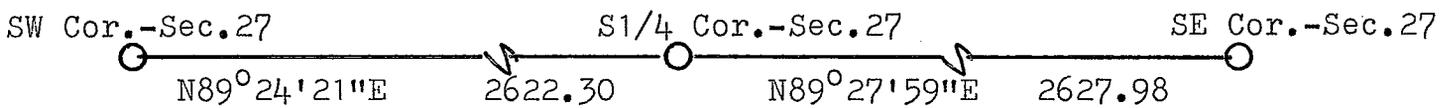

I, William C. Jung, Deputy County Surveyor,
HEREBY CERTIFY THAT THE CORNER LOCATION SHOWN ON THIS RECORD
WAS DETERMINED BY ME OR UNDER MY DIRECTION AND CONTROL AND
THAT THIS U. S. PUBLIC LAND SURVEY MONUMENT RECORD IS CORRECT
AND COMPLETE TO THE BEST OF MY KNOWLEDGE AND BELIEF.

William C. Jung December 27, 1989
Signature Date

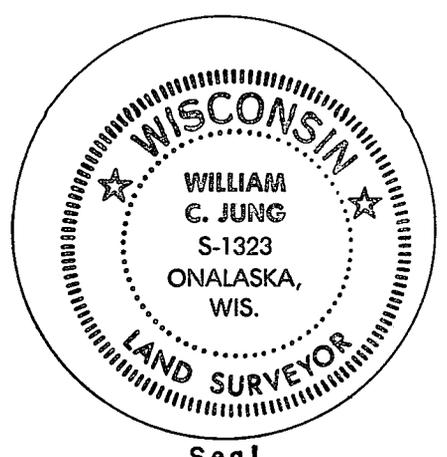

Seal