


21506280000

U. S. PUBLIC LAND SURVEY MONUMENT RECORD

SECTION 27 T 15 N, R 6 W, TOWN OF Greenfield

LA CROSSE COUNTY

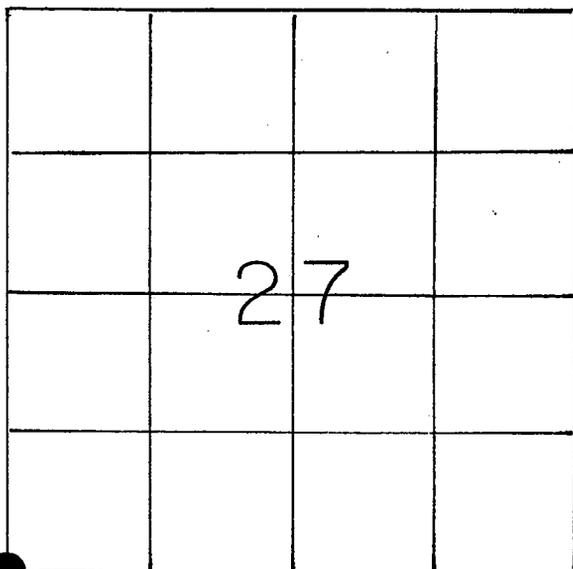

LOCATION OF LANDMARK

Crew: William C. Jung
Peter Follansbee

Date: April 24, 1989

Describe any record evidence, monument evidence, testimonial evidence or any other material evidence you considered and whether the monument was found or restored through acceptance of an obliterated evidence location.

I set this corner by projecting the fence along the West line of the SW1/4 of the NW1/4 of Section 34 North and intersecting this line with the old East-West section line fence. This fits the field evidence and original survey very well. This falls 58' East of the fence corner, but Mr. Willer said that his wife told of how her grandfather spoke of how a Roesler moved the fence West about 75 years ago. I set a Lunde on the South side of the fence and mounded the corner with rocks. I buried a wine bottle on the West side of the marker.

Describe or show any material discrepancy between the location of the restored corner and that of the corner previously restored or reestablished.

None known.

WISCONSIN COORDINATE SYSTEM

North

East

Theta Angle

Horiz. Order

Vert. Order

TYPE OF LANDMARK


Brass capped Lunde marker

BEARINGS ARE REFERENCED TO

Assumed North

RECORD OF DURABLE WITNESS MONUMENTS
Magnetic


NO	DESCRIPTION	BEARING	DISTANCE
1	P.K. nail in double blazed 13" aspen	N41°W	49.62
2	" " " " " 6" hickory	N19°E	18.96
3	" " " " " 9" white oak	N30°E	8.32
4	" " " " " 13" oak	N34°E	25.30

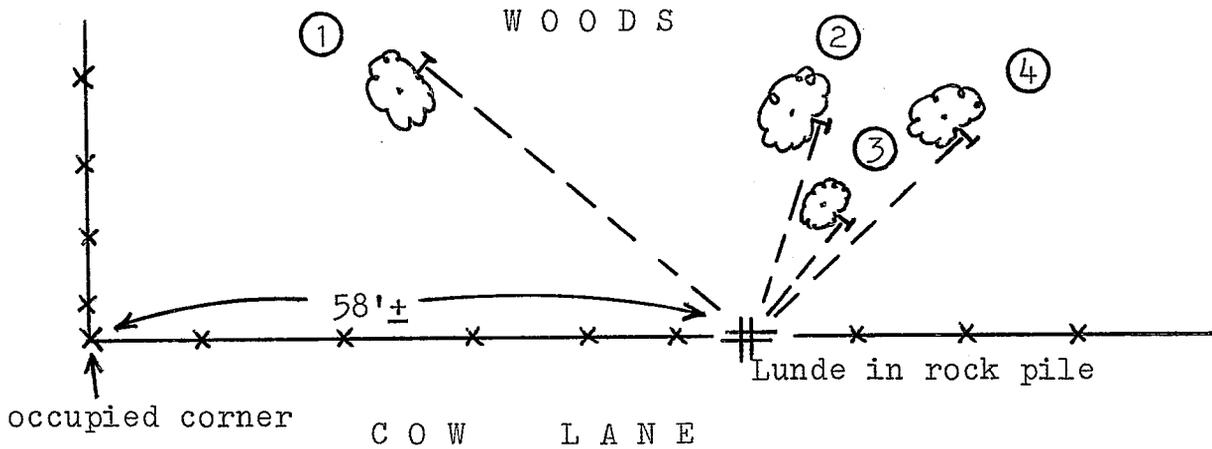

PLAN VIEW DRAWING OF REFERENCE TIES

MAP SHOWING DISTANCE AND DIRECTION TO OTHER PUBLIC LAND SURVEY CORNERS USED FOR REESTABLISHING THE CORNER

(not to scale)

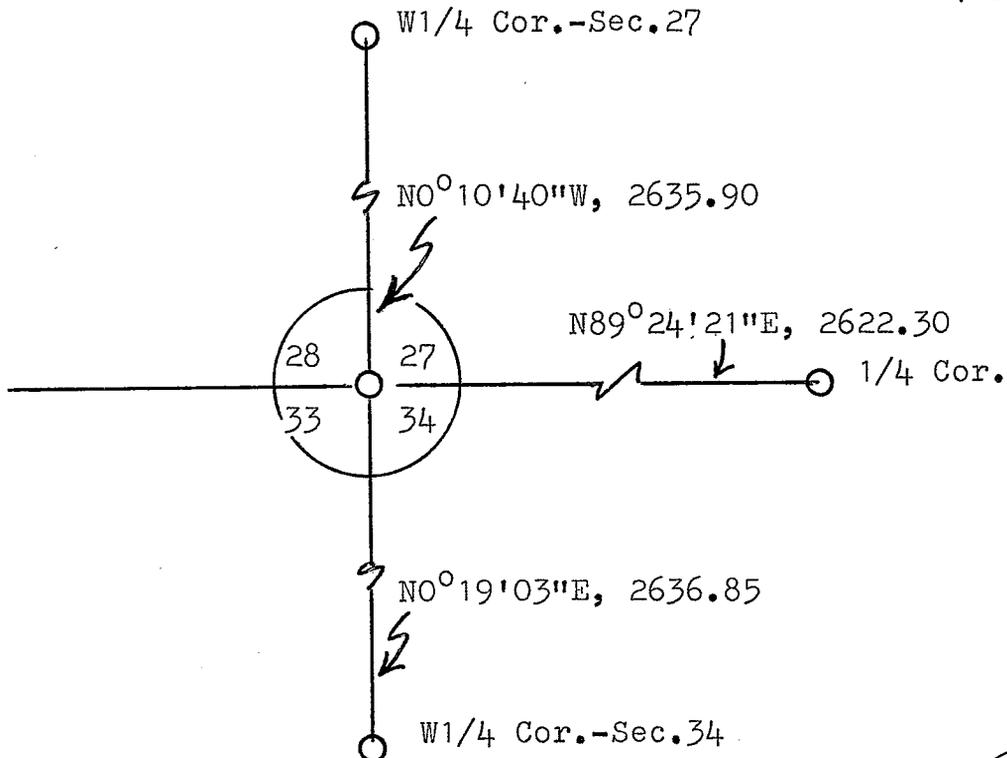

I, William C. Jung, Deputy County Surveyor,
HEREBY CERTIFY THAT THE CORNER LOCATION SHOWN ON THIS RECORD
WAS DETERMINED BY ME OR UNDER MY DIRECTION AND CONTROL AND
THAT THIS U. S. PUBLIC LAND SURVEY MONUMENT RECORD IS CORRECT
AND COMPLETE TO THE BEST OF MY KNOWLEDGE AND BELIEF.

William C. Jung
Signature

December 27, 1989
Date



Seal