


21506290020

U. S. PUBLIC LAND SURVEY MONUMENT RECORD

SECTION 29 T 15 N, R 6 W, TOWN OF GREENFIELD
 LA CROSSE COUNTY

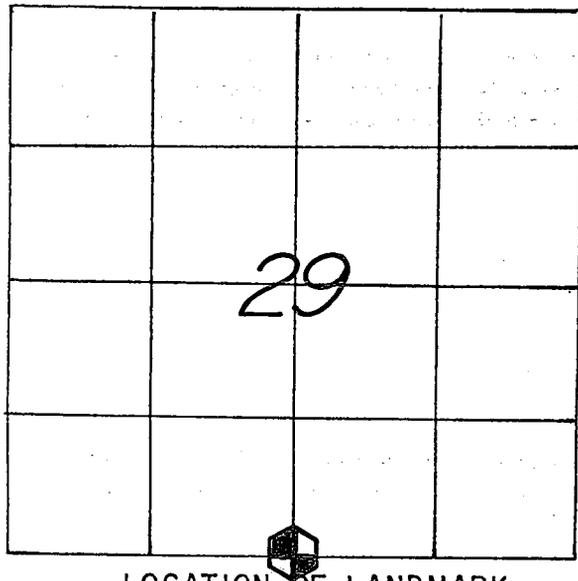

LOCATION OF LANDMARK

CREW: WILLIAM G. JUNG
 PETER F. FOLLANSBEE
 DATE: 4/02/2004

WISCONSIN COORDINATE SYSTEM	
North	636,016.736
East	1,672,408.029
Theta Angle	
Horiz. Order	
Vert. Order	
DATUM:	1983('91)
TYPE OF LANDMARK	
BRASS CAP LUNDE MARKER.	
BEARINGS ARE REFERENCED TO	
GRID NORTH AS PER SECTION DATA.	

Describe any record evidence, monument evidence, testimonial evidence or any other material evidence you considered and whether the monument was found or restored through acceptance of an obliterated evidence location.

We found an iron pipe at the corner that had been used as the corner in previous survey work. I accepted the pipe as the best available evidence of the original government corner position. The pipe was replaced with a brass capped Lunde marker.


Describe or show any material discrepancy between the location of the restored corner and that of the corner previously restored or reestablished.

NONE KNOWN.

RECORD OF DURABLE WITNESS MONUMENTS


ASSUMED NORTH

NO	DESCRIPTION	BEARING	DISTANCE
1	SET A P.K. NAIL IN S.-SIDE OF A 28" "TAMARAK"(UNBLAZED)	N 82°12'04" W	249.20 FT.
2	SET A 3/4"x30" IRON BAR WITH A RED PLASTIC CAP	N 00°09'00" E	90.12 FT.
3	SET A 3/4"x30" IRON BAR WITH A RED PLASTIC CAP	S 79° 15'05" E	85.01 FT.
4	SET A 3/4"x30" IRON BAR WITH A RED PLASTIC CAP	S 00°00'00" E	33.08 FT.

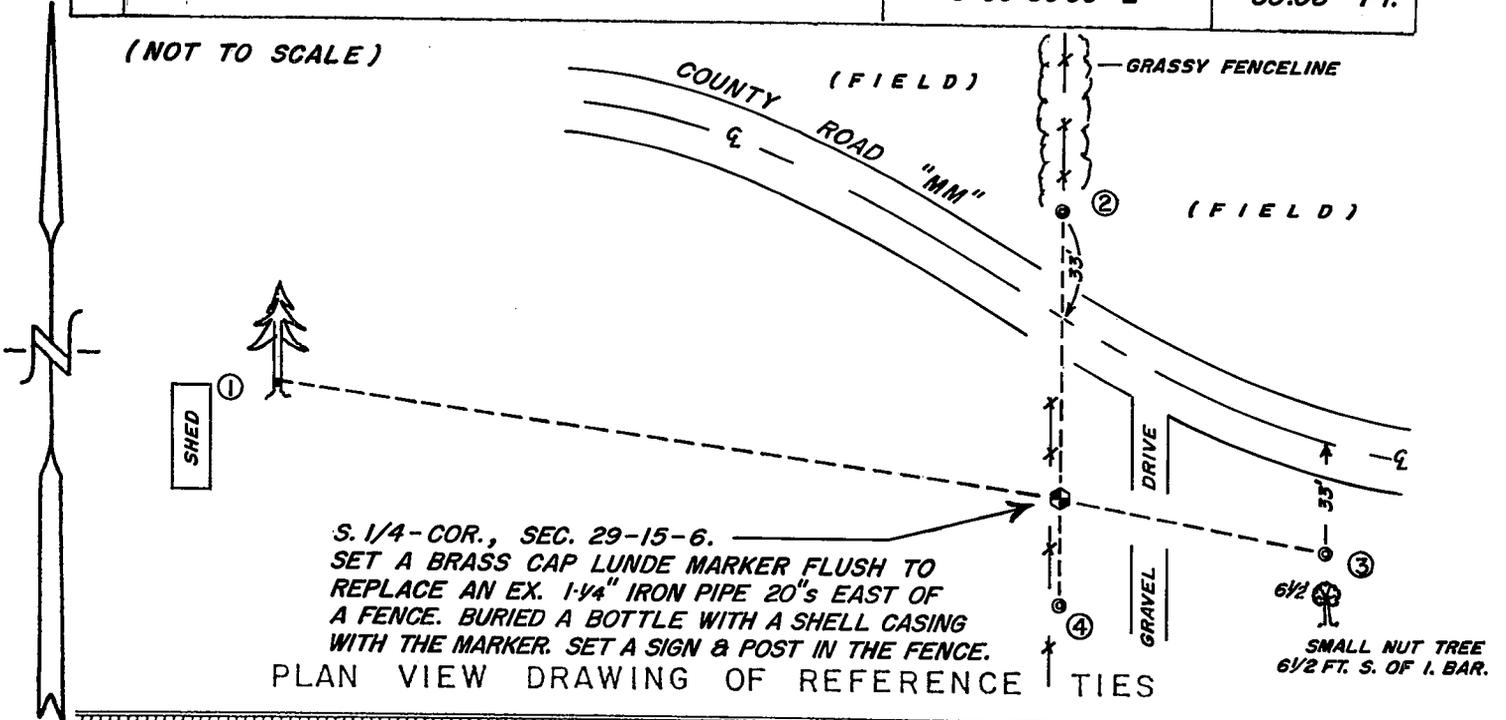

MAP SHOWING DISTANCE AND DIRECTION TO OTHER PUBLIC LAND SURVEY CORNERS USED FOR REESTABLISHING THE CORNER


(GRID BEARINGS & DISTANCES)
 (GRID FACTOR: 0.999889)
 (NOT TO SCALE)

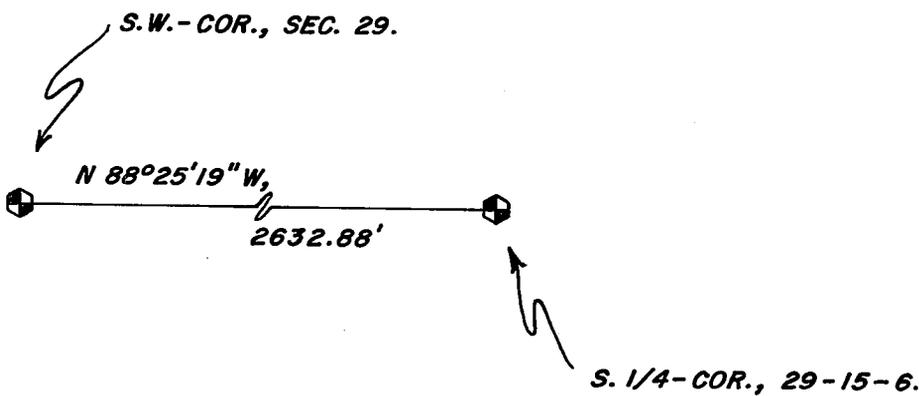

I, WILLIAM G. JUNG, COUNTY SURVEYOR
 HEREBY CERTIFY THAT THE CORNER LOCATION SHOWN ON THIS RECORD
 WAS DETERMINED BY ME OR UNDER MY DIRECTION AND CONTROL AND
 THAT THIS U. S. PUBLIC LAND SURVEY MONUMENT RECORD IS CORRECT
 AND COMPLETE TO THE BEST OF MY KNOWLEDGE AND BELIEF.

William G. Jung
 Signature

1/5/05
 Date

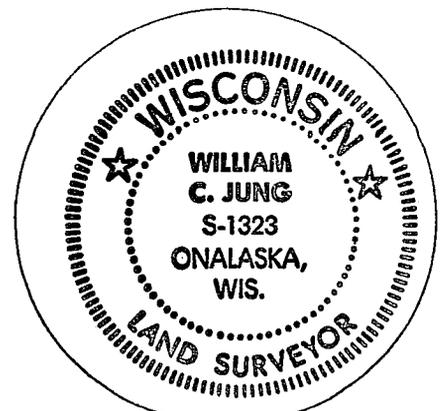

Seal