


U. S. PUBLIC LAND SURVEY MONUMENT RECORD

SECTION 30 T 15 N, R 6 W, TOWN OF SHELBY

LA CROSSE COUNTY

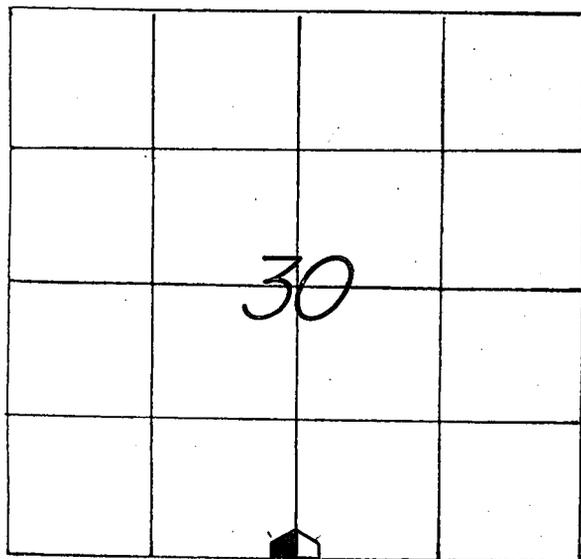

LOCATION OF LANDMARK

CREW: **WILLIAM C. JUNG**
PETER F. FOLLANSBEE
 DATE: **9/21/2006**

WISCONSIN COORDINATE SYSTEM

North **636,142.118**East **1,667,143.965**

Theta Angle

Horiz. Order

Vert. Order

DATUM: 1983('91)

TYPE OF LANDMARK

Existing Lunde marker, down 4 feet

BEARINGS ARE REFERENCED TO

GRID NORTH AS PER SECTION DATA.

Describe any record evidence, monument evidence, testimonial evidence or any other material evidence you considered and whether the monument was found or restored through acceptance of an obliterated evidence location.


After receiving calls from concerned citizens, we went to this corner and found that a contractor had buried this corner while in the process of building a new private road to a new house site. Using his backhoe, the contractor dug up the new road. We found our Lunde in good condition, down about 4 feet. As the new road was not quite done, and since the road was still taking a lot of heavy construction traffic, we did not set another marker over the Lunde at this time as it would have been knocked off

Describe or show any material discrepancy between the location of the restored center. corner and that of the corner previously restored or reestablished.

NONE KNOWN.


RECORD OF DURABLE WITNESS MONUMENTS

NO	DESCRIPTION	GRID BEARINGS	GROUND DIST.'s
		BEARING	DISTANCE
1	EX. 3/4" IRON BAR C.S.M. LOT CORNER	N 89°31'06"W	252.71 FT.
2	SET A 3/4"x 30" IRON BAR 6' WEST OF 911 No. POST	N 52°05'03"W	73.58 FT.
3	EX. 3/4" IRON BAR C.S.M. LOT CORNER	N 01°39'51"E	518.86 FT.
4	SET A 12" SPIKE TO REPLACE A BENT IRON BAR	S 72°04'48"W	30.88 FT.

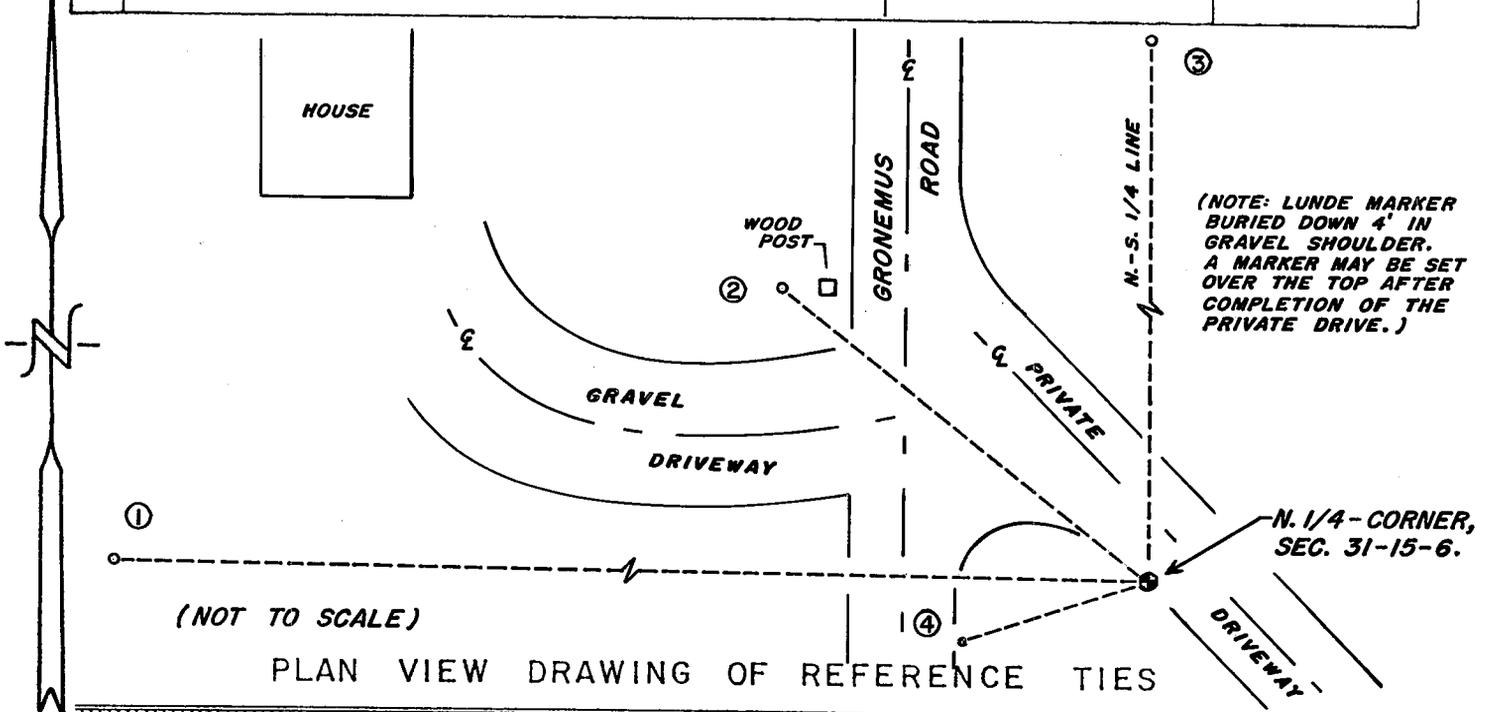

MAP SHOWING DISTANCE AND DIRECTION TO OTHER PUBLIC LAND SURVEY CORNERS USED FOR REESTABLISHING THE CORNER


(GRID BEARINGS AND DISTANCES)
 (GRID FACTOR: 0.999889)
 (NOT TO SCALE)

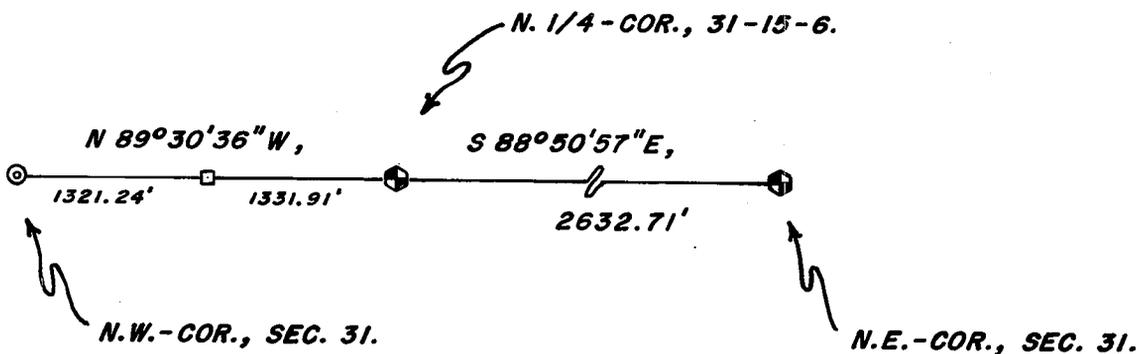

I, WILLIAM G. JUNG, COUNTY SURVEYOR
 HEREBY CERTIFY THAT THE CORNER LOCATION SHOWN ON THIS RECORD
 WAS DETERMINED BY ME OR UNDER MY DIRECTION AND CONTROL AND
 THAT THIS U. S. PUBLIC LAND SURVEY MONUMENT RECORD IS CORRECT
 AND COMPLETE TO THE BEST OF MY KNOWLEDGE AND BELIEF.

William C. Jung
 Signature


11/29/06
 Date

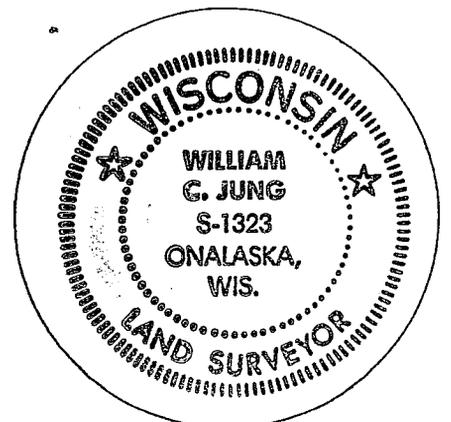

Seal

U. S. PUBLIC LAND SURVEY MONUMENT RECORD

SECTION 30 T 15 N, R 6 W, TOWN OF SHELBY
 LA CROSSE COUNTY

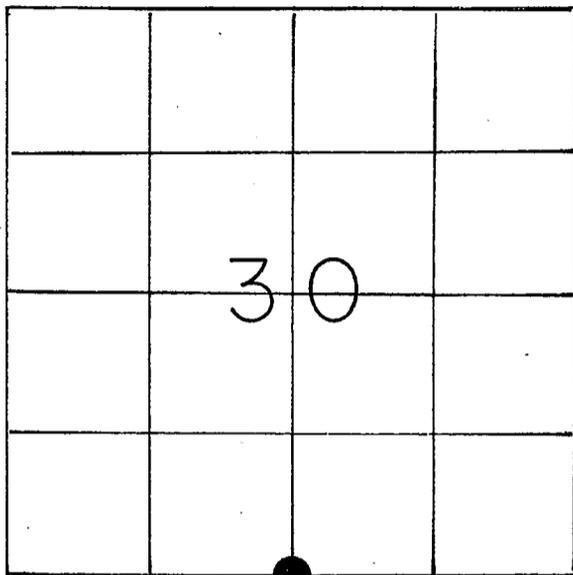

LOCATION OF LANDMARK

Crew: William C. Jung
 Peter F. Follansbee

Date: 9/6/91

Describe any record evidence, monument evidence, testimonial evidence or any other material evidence you considered and whether the monument was found or restored through acceptance of an obliterated evidence location.

I set this corner at a computed location, on line with the iron pipe at the SW corner and the stone at the S1/16SW and at a distance from the stone proportional to the distance between between the stone and pipe. Interestingly these 1/4 mile distances are both 16' short of Middlebrook's distances. I set a Lunde at the corner. There was no evidence of any occupation at the corner.


Describe or show any material discrepancy between the location of the restored corner and that of the corner previously restored or reestablished.

None known.

WISCONSIN COORDINATE SYSTEM
North
East
Theta Angle
Horiz. Order
Vert. Order
TYPE OF LANDMARK
Brass capped Lunde marker
BEARINGS ARE REFERENCED TO
Assumed

RECORD OF DURABLE WITNESS MONUMENTS


NO	DESCRIPTION	BEARING	DISTANCE
1	Set a rebar w/yellow DOT plastic cap at the base of a utility pole anchor	-----	11.20
2	Rebar survey point on East shoulder of the rd.	S71°19'W	30.91
3	P.K. nail in a power pole	-----	35.84
4	"	-----	28.75

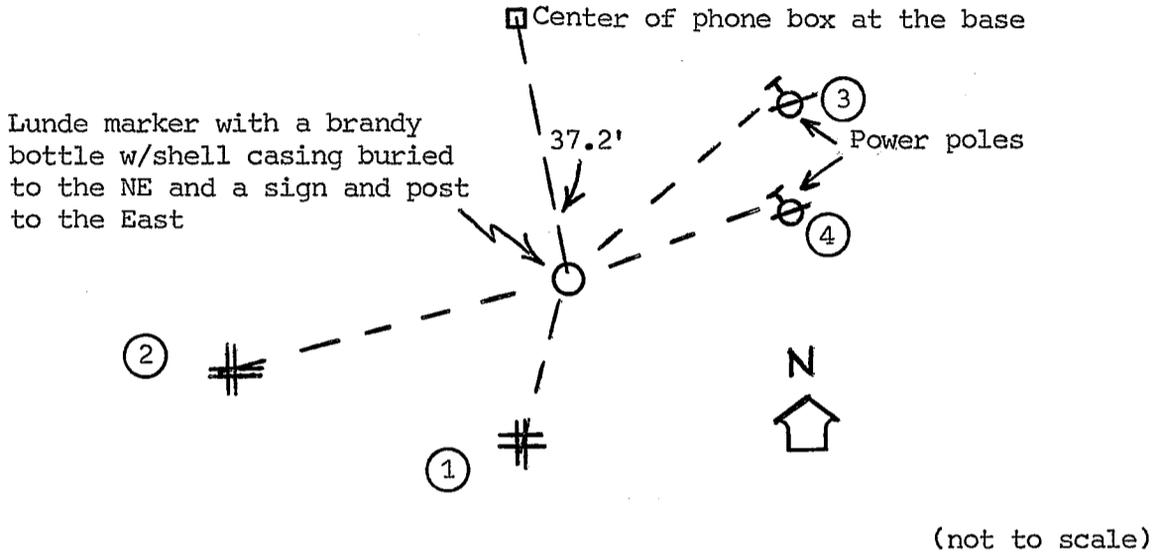

PLAN VIEW DRAWING OF REFERENCE TIES

MAP SHOWING DISTANCE AND DIRECTION TO OTHER PUBLIC LAND SURVEY CORNERS USED FOR REESTABLISHING THE CORNER

(not to scale)

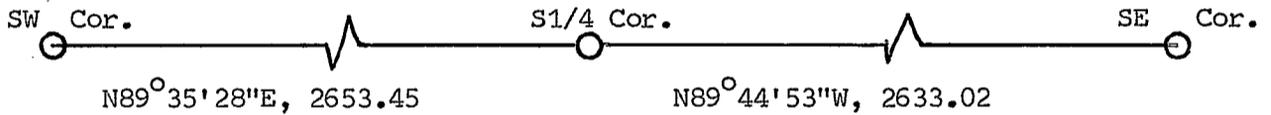

I, William C. Jung, Deputy County Surveyor
 HEREBY CERTIFY THAT THE CORNER LOCATION SHOWN ON THIS RECORD
 WAS DETERMINED BY ME OR UNDER MY DIRECTION AND CONTROL AND
 THAT THIS U. S. PUBLIC LAND SURVEY MONUMENT RECORD IS CORRECT
 AND COMPLETE TO THE BEST OF MY KNOWLEDGE AND BELIEF.

William C. Jung 9/12/91
 Signature Date



Seal