


U. S. PUBLIC LAND SURVEY MONUMENT RECORD

SECTION 30 T 15 N, R 6 W, TOWN OF SHELBY

LA CROSSE COUNTY

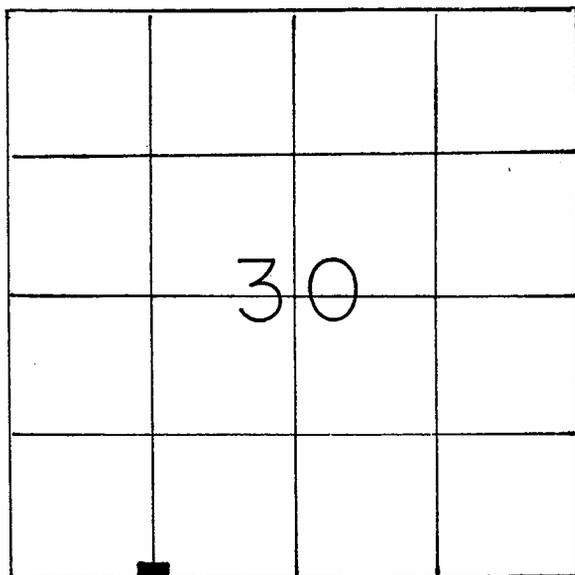

LOCATION OF LANDMARK

WISCONSIN COORDINATE SYSTEM

North

East

Theta Angle

Horiz. Order

Vert. Order

TYPE OF LANDMARK

4"x5" stone, up 18"

BEARINGS ARE REFERENCED TO

Assumed

Crew: William C. Jung
Peter F. Follansbee

Date: 9/6/91

Describe any record evidence, monument evidence, testimonial evidence or any other material evidence you considered and whether the monument was found or restored through acceptance of an obliterated evidence location.


I accepted an existing stone as the best evidence of the old "40" corner location. I originally found a stone at this corner in 1986. It was leaning to the South. I again found the stone and plumbed it up. The stone measures 4"x5", is shaped rather like an obelisk, and is 18" above the ground. To the Southeast is a leaning and rotting corner post. Fences go to the East and South. The corner has been occupied this way for some time, probably since the turn of the century or before. I believe this stone to be an unrecorded survey marker set by an earlier surveyor. Could it have been Middlebrook in the 1870's?

Describe or show any material discrepancy between the location of the restored corner and that of the corner previously restored or reestablished.

None known.

RECORD OF DURABLE WITNESS MONUMENTS


NO	DESCRIPTION	BEARING	DISTANCE
1	P.K. nail in a power pole	-----	96.64
2	P.K. nail in an unblazed 6" elm	-----	10.60
3	" 6" white oak	-----	14.74
4			

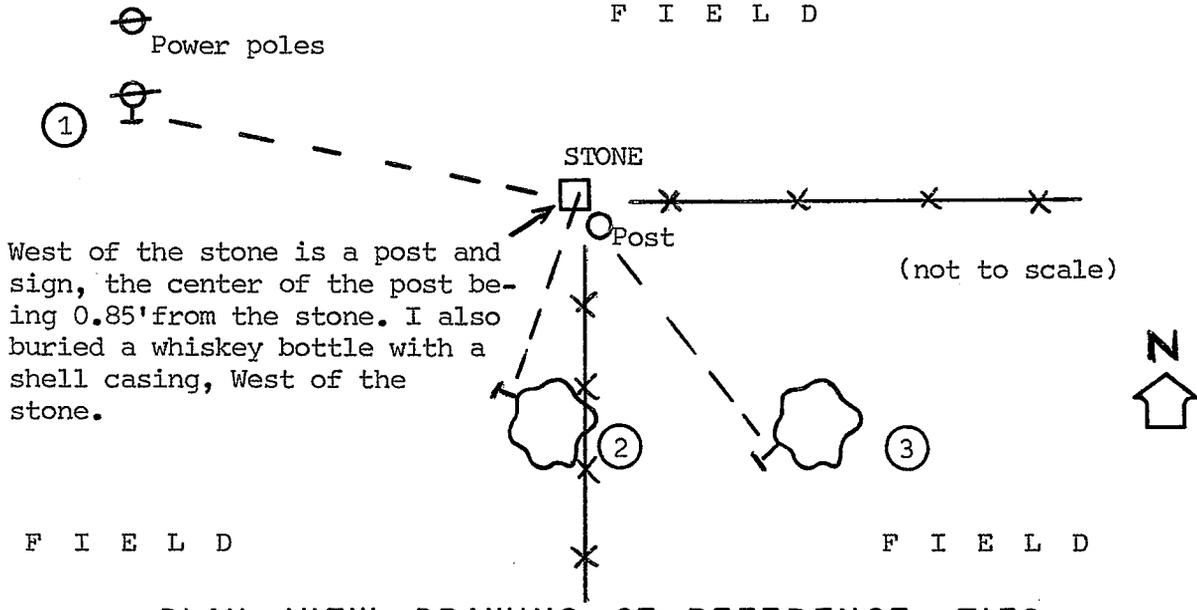

PLAN VIEW DRAWING OF REFERENCE TIES

MAP SHOWING DISTANCE AND DIRECTION TO OTHER PUBLIC LAND SURVEY CORNERS USED FOR REESTABLISHING THE CORNER


(not to scale)

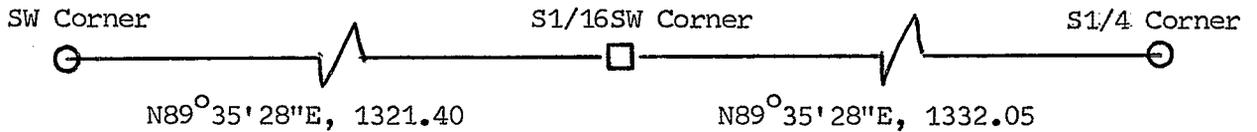

I, William C. Jung, Deputy County Surveyor,
 HEREBY CERTIFY THAT THE CORNER LOCATION SHOWN ON THIS RECORD
 WAS DETERMINED BY ME OR UNDER MY DIRECTION AND CONTROL AND
 THAT THIS U. S. PUBLIC LAND SURVEY MONUMENT RECORD IS CORRECT
 AND COMPLETE TO THE BEST OF MY KNOWLEDGE AND BELIEF.

William C. Jung
 Signature

9/12/91
 Date

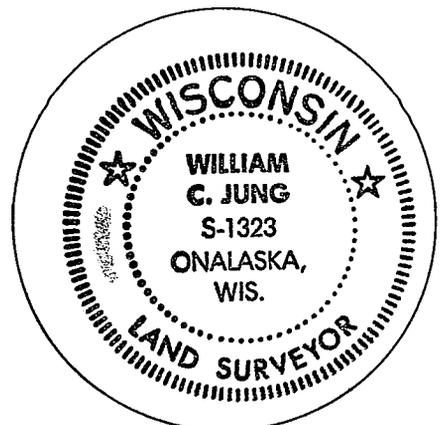

Seal