


## U. S. PUBLIC LAND SURVEY MONUMENT RECORD

SECTION 31 T 15 N, R 6 W, TOWN OF SHELBY

LA CROSSE COUNTY

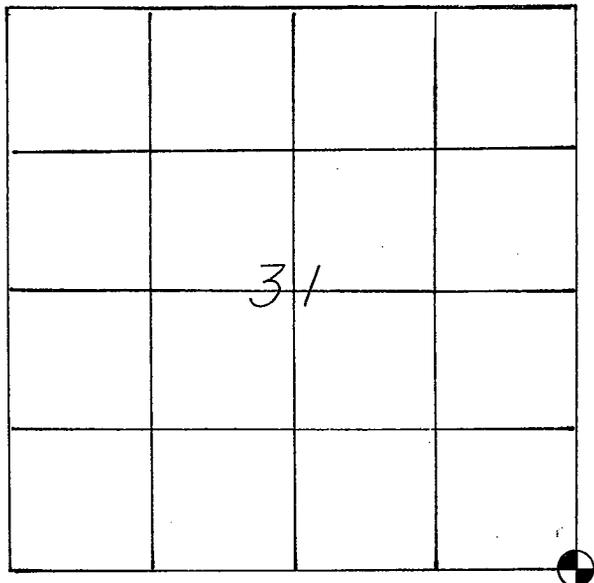

LOCATION OF LANDMARK

WISCONSIN COORDINATE SYSTEM

North

East

Theta Angle

Horiz. Order

Vert. Order

TYPE OF LANDMARK

BRASS CAPPED LUNDE MARKER

BEARINGS ARE REFERENCED TO

Assumed

CREW: BILL JUNG DATE: 8-6-86

PERRY DAHL

Describe any record evidence, monument evidence, testimonial evidence or any other material evidence you considered and whether the monument was found or restored through acceptance of an obliterated evidence location.

Rob Lampman set a pipe at this corner in 1978. I accepted this location as the best available evidence of the original government corner position. I removed the pipe and replaced it with a brass capped Lunde marker.


Describe or show any material discrepancy between the location of the restored corner and that of the corner previously restored or reestablished.

None known.

RECORD OF DURABLE WITNESS MONUMENTS

MAGNETIC


NO	DESCRIPTION	BEARING	DISTANCE
1	1 1/4" IRON PIPE	S87°W	20.14'
2	P.K. NAIL IN 13" DOUBLE-BLAZED HICKORY TREE	S79°W	34.47'
3	P.K. NAIL IN 6" DOUBLE-BLAZED ELM TREE	S53°W	71'
4	NORTHWEST CORNER OF BARN	S71°E	119'

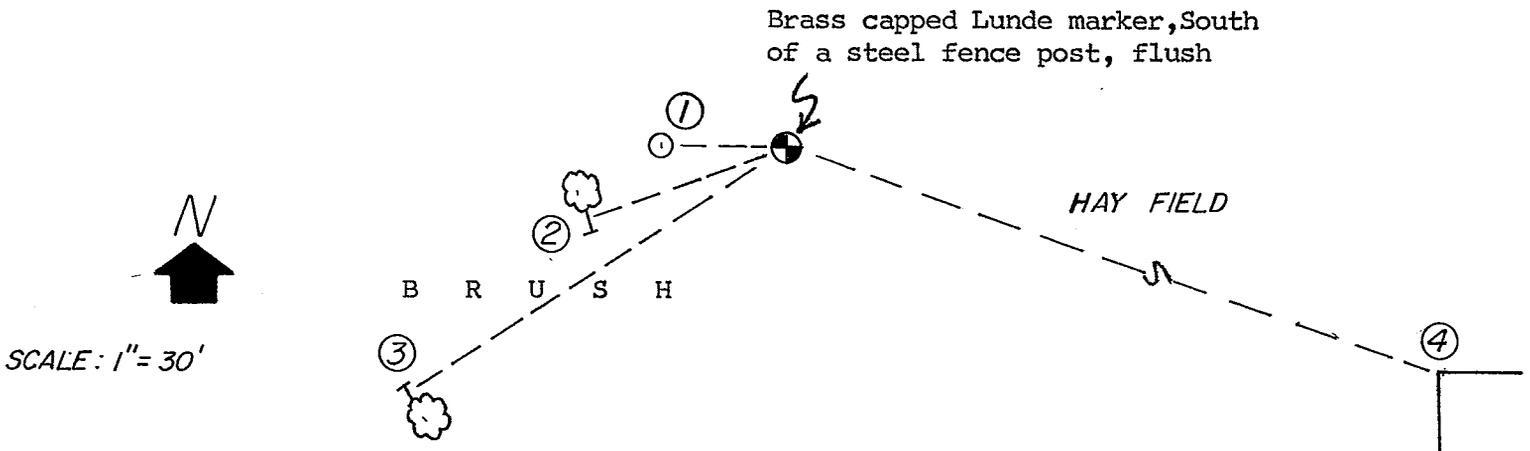

PLAN VIEW DRAWING OF REFERENCE TIES

MAP SHOWING DISTANCE AND DIRECTION TO OTHER PUBLIC LAND SURVEY CORNERS USED FOR REESTABLISHING THE CORNER

(not to scale)

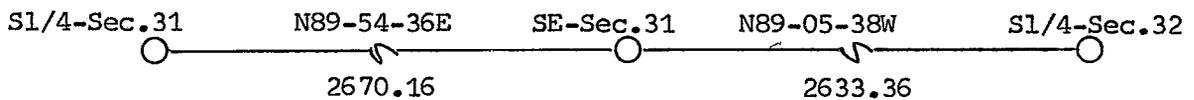

I, William C. Jung, Deputy County Surveyor,  
 HEREBY CERTIFY THAT THE CORNER LOCATION SHOWN ON THIS RECORD  
 WAS DETERMINED BY ME OR UNDER MY DIRECTION AND CONTROL AND  
 THAT THIS U. S. PUBLIC LAND SURVEY MONUMENT RECORD IS CORRECT  
 AND COMPLETE TO THE BEST OF MY KNOWLEDGE AND BELIEF.

William C. Jung      March 6, 1987  
 Signature      Date



Seal