


21506322000

U. S. PUBLIC LAND SURVEY MONUMENT RECORD

SECTION 32 T 15 N, R 6 W, TOWN OF Greenfield
 LA CROSSE COUNTY

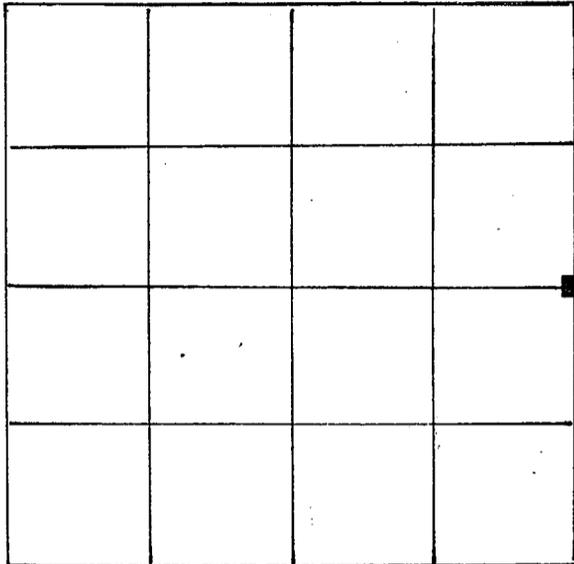

LOCATION OF LANDMARK

WISCONSIN COORDINATE SYSTEM

North

East

Theta Angle

Horiz. Order

Vert. Order

TYPE OF LANDMARK

Found a 1 1/4" iron pipe

BEARINGS ARE REFERENCED TO
 Bearings are referenced to the
 East line of Section 32 and
 assumed to bear N 00° 49' 47" E.


Describe any record evidence, monument evidence, testimonial evidence or any other material evidence you considered and whether the monument was found or restored through acceptance of an obliterated evidence location.

Found a 1 1/4 inch iron pipe as found by Robert Lampman during a survey performed for Ellsworth Austin, on July 27, 1978.

Describe or show any material discrepancy between the location of the restored corner and that of the corner previously restored or reestablished.


RECORD OF DURABLE WITNESS MONUMENTS

NO	DESCRIPTION	BEARING	DISTANCE
1	3/4 inch iron bar set at the 40 corner between the NE Corner and the E 1/4 corner	N 00° 49' 47" E	1315.835
2	3/4 inch by 30" iron bar set for a witness in the down fence line	S 03° 27' 15" W	54.90'
3	3/4" by 30" iron bar set for a witness in the woods	S 55° 22' 08" W	150.64'
4	18" Shagbark Hickory, with a spike nail in the south side.	S 74° 38' 00" W	133.10'

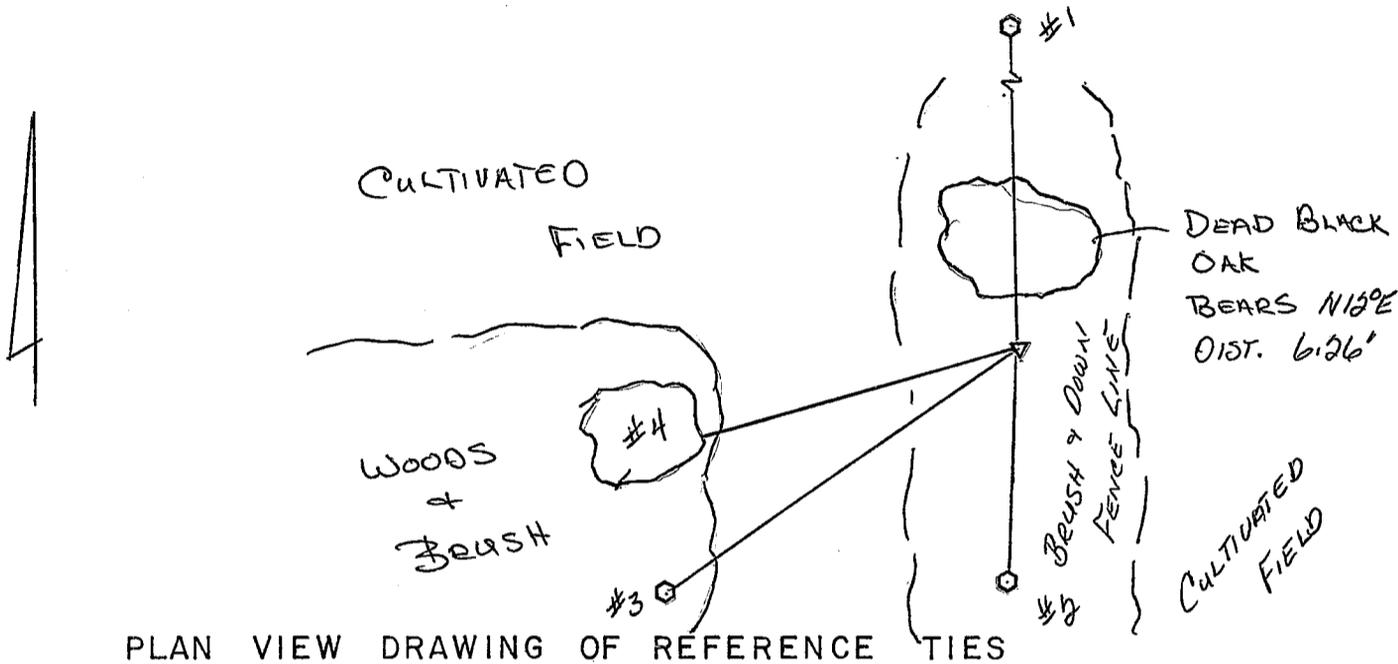

PLAN VIEW DRAWING OF REFERENCE TIES


MAP SHOWING DISTANCE AND DIRECTION TO OTHER PUBLIC LAND SURVEY CORNERS USED FOR REESTABLISHING THE CORNER

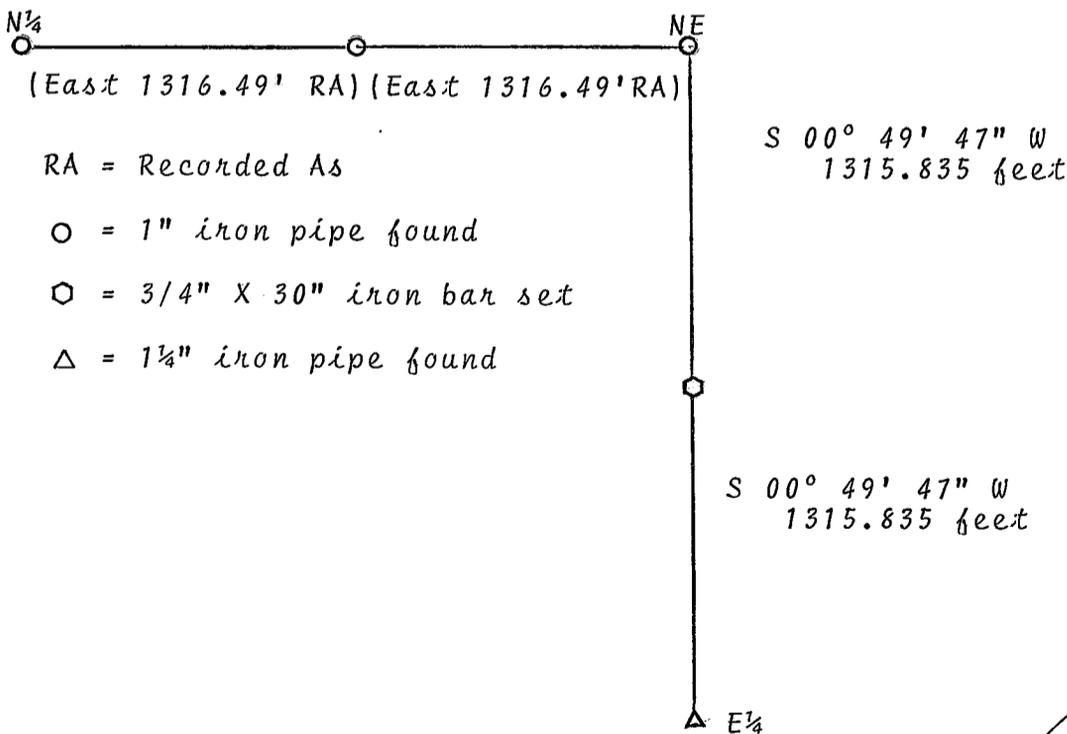

I, Ronald R. Hayden
 HEREBY CERTIFY THAT THE CORNER LOCATION SHOWN ON THIS RECORD
 WAS DETERMINED BY ME OR UNDER MY DIRECTION AND CONTROL AND
 THAT THIS U. S. PUBLIC LAND SURVEY MONUMENT RECORD IS CORRECT
 AND COMPLETE TO THE BEST OF MY KNOWLEDGE AND BELIEF.

Ronald R. Hayden
 Signature

8/06/86
 Date

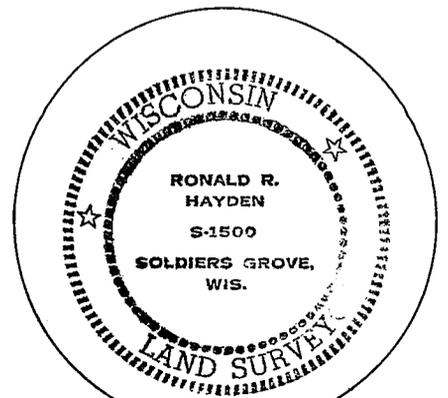

Seal



William C. Jung, County Surveyor

LA CROSSE COUNTY, WISCONSIN

Courthouse, La Crosse, Wisconsin 54601-3200

Telephone: 785-9722


TO WHOM IT MAY CONCERN:

This is to certify that on May 19, 1995, Peter Follansbee and I found an iron pipe at the East 1/4 Corner of Section 32-T15N-R6W. We set a Berntsen "shorty" top in the iron pipe and set a sign and post to the South of the marker.

William C. Jung

County Surveyor

February 5, 1996

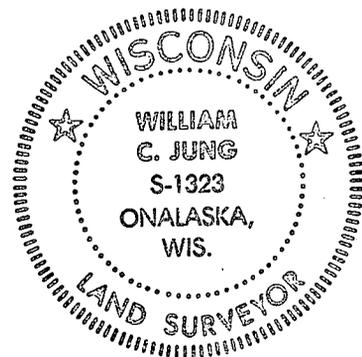

10

THE UNIVERSITY OF CHICAGO

PHILOSOPHY DEPARTMENT

PHILOSOPHY 101

PHILOSOPHY 102