


U. S. PUBLIC LAND SURVEY MONUMENT RECORD

SECTION 32 T 15 N, R 6 W, TOWN OF Greenfield

LA CROSSE COUNTY

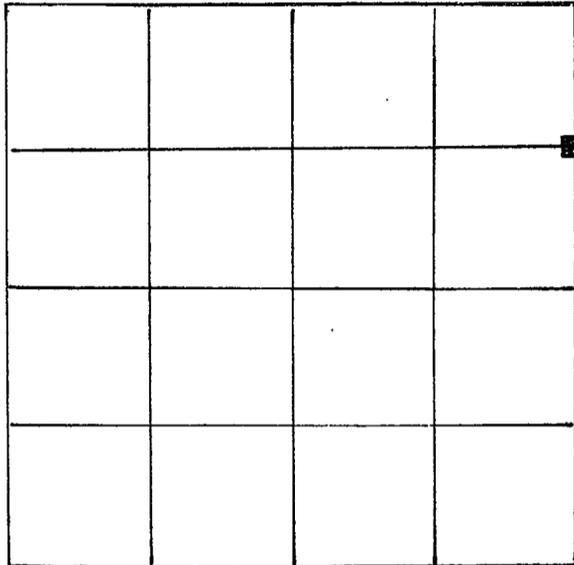

LOCATION OF LANDMARK

WISCONSIN COORDINATE SYSTEM

North

East

Theta Angle

Horiz. Order

Vert. Order

TYPE OF LANDMARK

Set 3/4" X 30" iron bar.

BEARINGS ARE REFERENCED TO
 Bearings are referenced to the
 East line of Section 32 and
 assumed to bear N 00° 49' 47" E

Describe any record evidence, monument evidence, testimonial evidence or any other material evidence you considered and whether the monument was found or restored through acceptance of an obliterated evidence location.


After an extensive search, I found no evidence of the corner or its witnesses. The corner falls in Ober Road. I reestablished the corner and set a 3/4" X 30" iron rod beneath the gravel road at a depth of 8 inches.

Describe or show any material discrepancy between the location of the restored corner and that of the corner previously restored or reestablished.

RECORD OF DURABLE WITNESS MONUMENTS


NO	DESCRIPTION	BEARING	DISTANCE
1	3/4" X 30" iron bar used for a witness	S 38° 52' 13" W	57.80'
2	3/4" X 30" iron bar used for a witness	S 52° 40' 49" W	16.25'
3	3/4" X 30" iron bar used for witness	N 82° 14' 48" W	39.60'
4	3/4" X 30" iron bar used for witness	N 26° 12' 30" W	180.40'

IRON BARS SET ARE
 CORNERS OF A CERTIFIED
 SURVEY MAP PERFORMED
 BY ME FOR JIM QUINN.

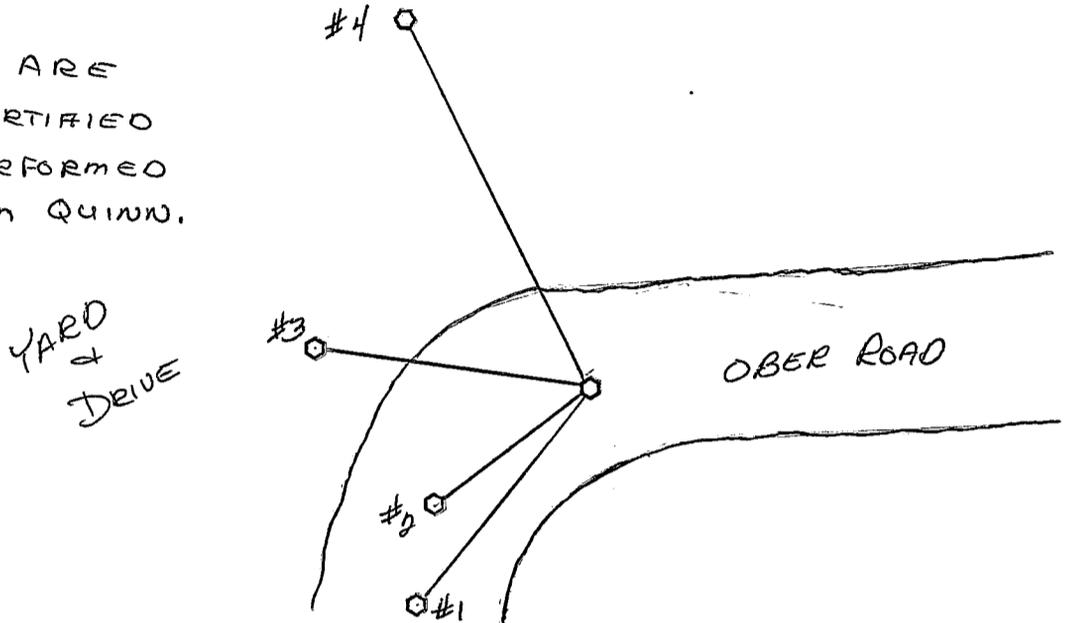

PLAN VIEW DRAWING OF REFERENCE TIES


MAP SHOWING DISTANCE AND DIRECTION TO OTHER PUBLIC LAND SURVEY CORNERS USED FOR REESTABLISHING THE CORNER

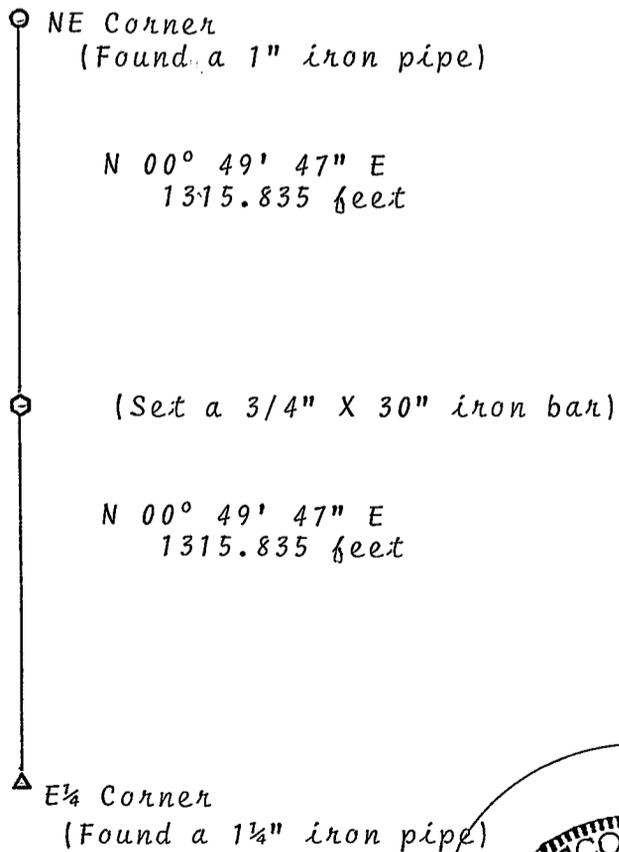

I, Ronald R. Hayden
 HEREBY CERTIFY THAT THE CORNER LOCATION SHOWN ON THIS RECORD
 WAS DETERMINED BY ME OR UNDER MY DIRECTION AND CONTROL AND
 THAT THIS U. S. PUBLIC LAND SURVEY MONUMENT RECORD IS CORRECT
 AND COMPLETE TO THE BEST OF MY KNOWLEDGE AND BELIEF.

Ronald R. Hayden
 Signature

8/06/86
 Date

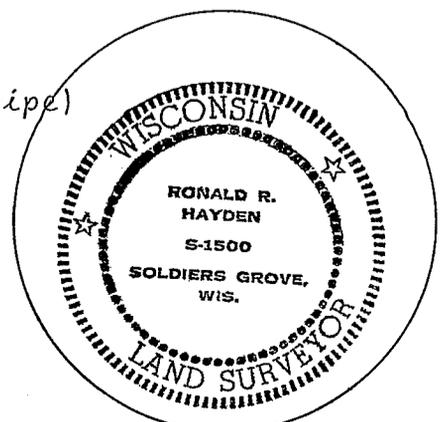

Seal