


21506330000

U. S. PUBLIC LAND SURVEY MONUMENT RECORD

SECTION 34 T 15 N, R 6 W, TOWN OF GREENFIELD

LA CROSSE COUNTY

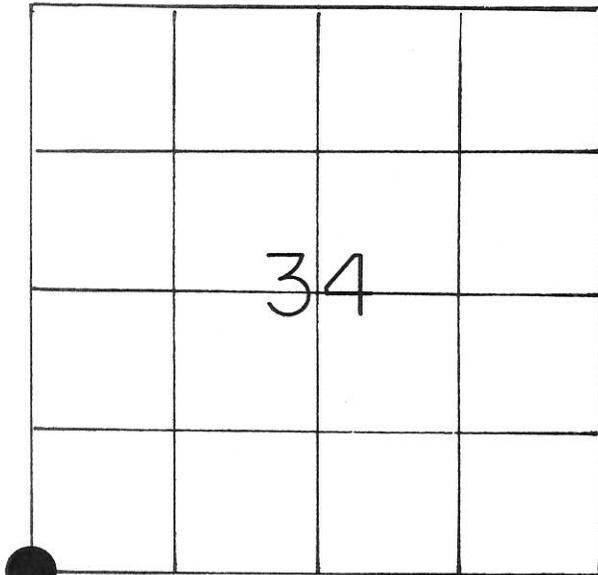

LOCATION OF LANDMARK

WISCONSIN COORDINATE SYSTEM

North

East

Theta Angle

Horiz. Order

Vert. Order

TYPE OF LANDMARK

SET BRASS CAP LUNDE MARKER

BEARINGS ARE REFERENCED TO

ASSUMED NORTH

Crew: WILLIAM C. JUNG
PETER F. FOLLANSBEE

Date: 7/26/1989

Describe any record evidence, monument evidence, testimonial evidence or any other material evidence you considered and whether the monument was found or restored through acceptance of an obliterated evidence location.


Survey records indicate that there was a stone at this corner. I found a stone leaning against a tree and a bent iron pipe at the corner. My measurements show that the pipe was at the old stone's position. The stone was probably set by the Vernon County Surveyor over a century ago. I removed the iron pipe and set a brass capped Lunde marker.

Describe or show any material discrepancy between the location of the restored corner and that of the corner previously restored or reestablished.

NONE KNOWN

RECORD OF DURABLE WITNESS MONUMENTS
MAGNETIC


NO	DESCRIPTION	BEARING	DISTANCE
1	NW-Cor. of a 28" x 28" base stone	S 29° E	110.35 Ft.
2	Set P.K. Nail in North side 12" Walnut	S 43° E	49.66 Ft.
3	NW-Cor. of a 16½" x 16½" base stone	S 55° E	101.74 Ft.
4	Set P.K. Nail in North side 15" Walnut	S 58° E	61.72 Ft.

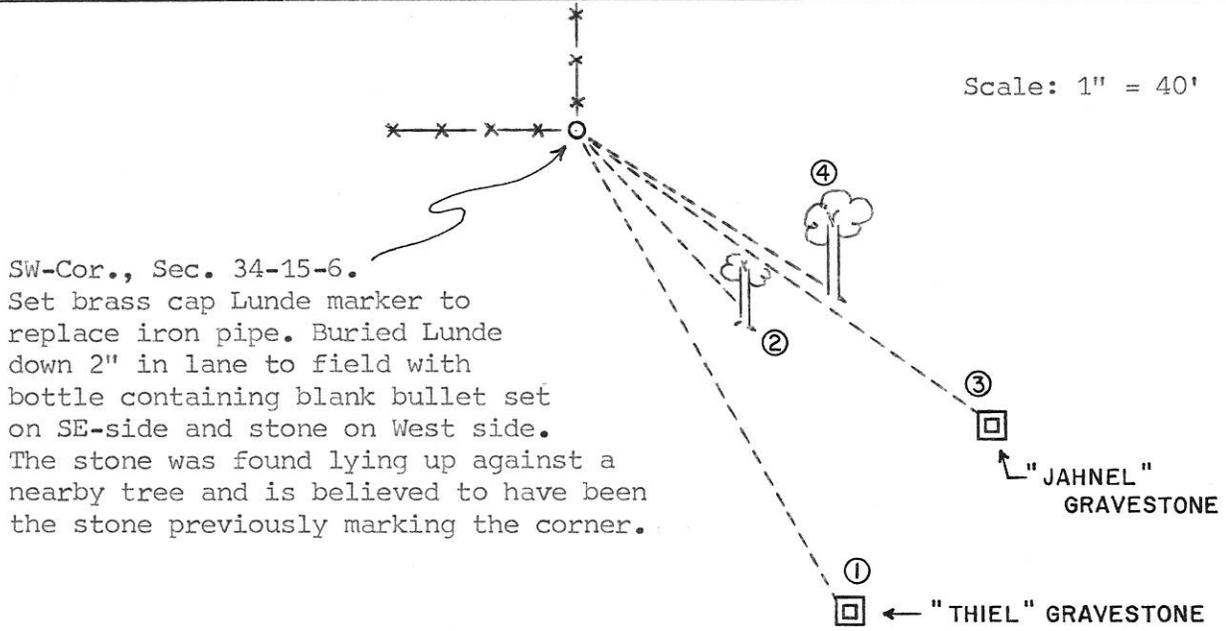

PLAN VIEW DRAWING OF REFERENCE TIES

MAP SHOWING DISTANCE AND DIRECTION TO OTHER PUBLIC LAND SURVEY CORNERS USED FOR REESTABLISHING THE CORNER

(not to scale)

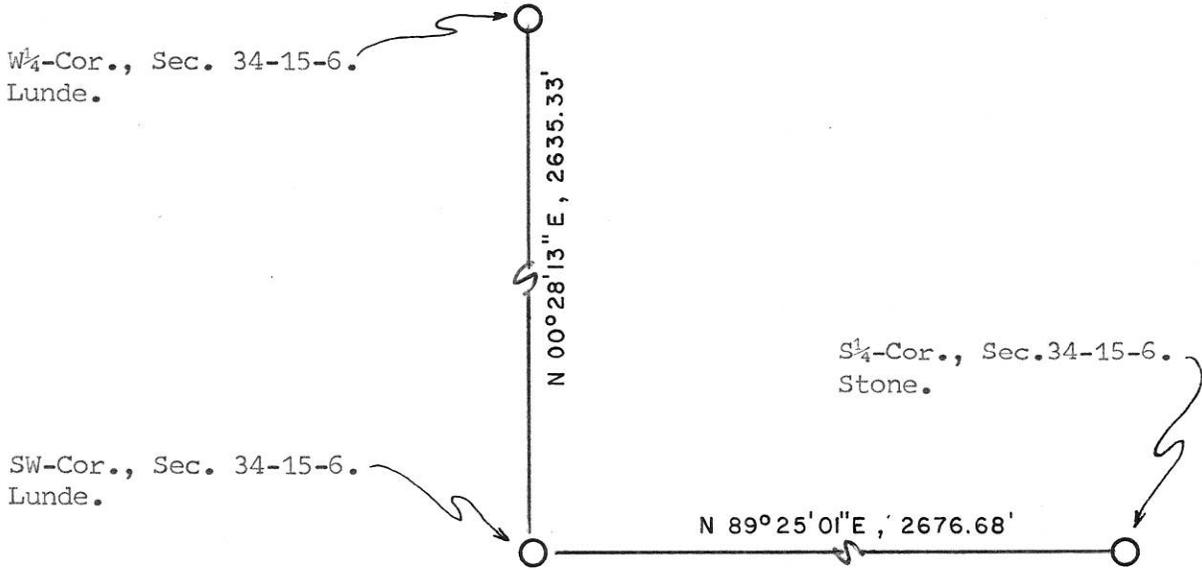

I, William C. Jung, Deputy County Surveyor
HEREBY CERTIFY THAT THE CORNER LOCATION SHOWN ON THIS RECORD WAS DETERMINED BY ME OR UNDER MY DIRECTION AND CONTROL AND THAT THIS U. S. PUBLIC LAND SURVEY MONUMENT RECORD IS CORRECT AND COMPLETE TO THE BEST OF MY KNOWLEDGE AND BELIEF.

William C. Jung 12/26/1989
Signature Date



Seal