


U. S. PUBLIC LAND SURVEY MONUMENT RECORD

SECTION 33 T 15 N, R 6 W, TOWN OF GREENFIELD
 LA CROSSE COUNTY

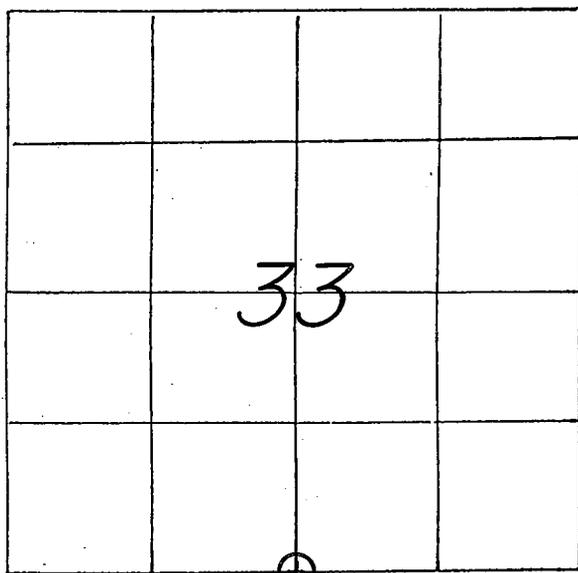

LOCATION OF LANDMARK

CREW: WILLIAM C. JUNG
 PETER F. FOLLANSBEE
 DATE: 4/26/1999

WISCONSIN COORDINATE SYSTEM
North
East
Theta Angle
Horiz. Order
Vert. Order
TYPE OF LANDMARK
3/4" x 30" ROUND IRON BAR w/ALUMINUM CAP.
BEARINGS ARE REFERENCED TO
GRID NORTH.

Describe any record evidence, monument evidence, testimonial evidence or any other material evidence you considered and whether the monument was found or restored through acceptance of an obliterated evidence location.

After surveying out the section, I accepted the old occupied corner as the best available evidence of the original government corner position and monumented it with an iron bar and cap.


Describe or show any material discrepancy between the location of the restored corner and that of the corner previously restored or reestablished.

NONE KNOWN.

RECORD OF DURABLE WITNESS MONUMENTS

MAGNETIC


NO	DESCRIPTION	BEARING	DISTANCE
1	SET A NAIL IN N.-SIDE OF A 20" OAK	S 81° W	24.44 FT.
2	SET A P.K. NAIL IN E.-SIDE OF A 7" ASH	N 10° W	16.66 FT.
3	SET A NAIL IN N.E.-SIDE OF A 6-1/2" ASH ?	S 66° E	21.25 FT.
4	SET A NAIL IN N.E.-SIDE OF A 6" HICKORY	S 31° E	14.22 FT.

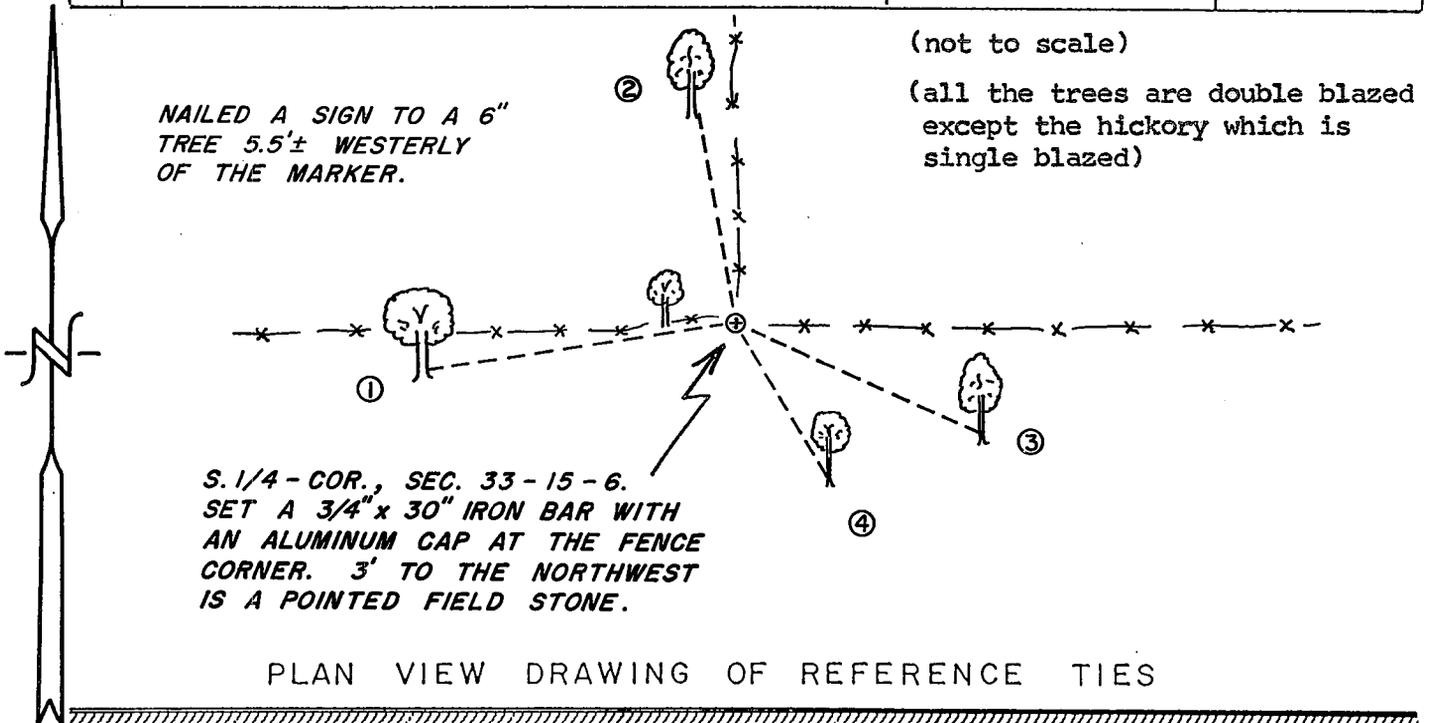

MAP SHOWING DISTANCE AND DIRECTION TO OTHER PUBLIC LAND SURVEY CORNERS USED FOR REESTABLISHING THE CORNER


(not to scale)

(grid distances)

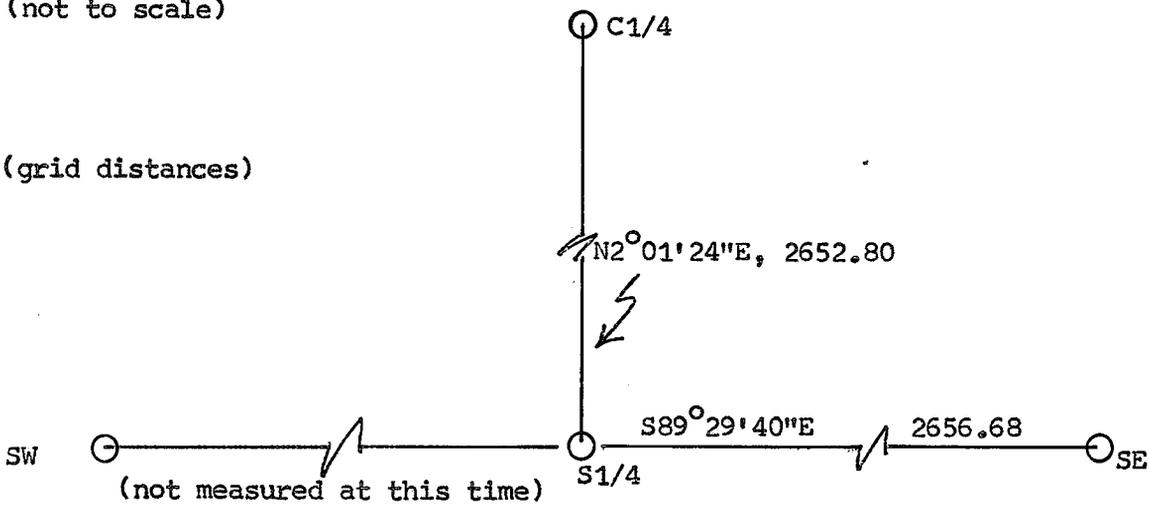

I, William C. Jung, County Surveyor,
HEREBY CERTIFY THAT THE CORNER LOCATION SHOWN ON THIS RECORD WAS DETERMINED BY ME OR UNDER MY DIRECTION AND CONTROL AND THAT THIS U. S. PUBLIC LAND SURVEY MONUMENT RECORD IS CORRECT AND COMPLETE TO THE BEST OF MY KNOWLEDGE AND BELIEF.

William C. Jung 5/2/99
Signature Date

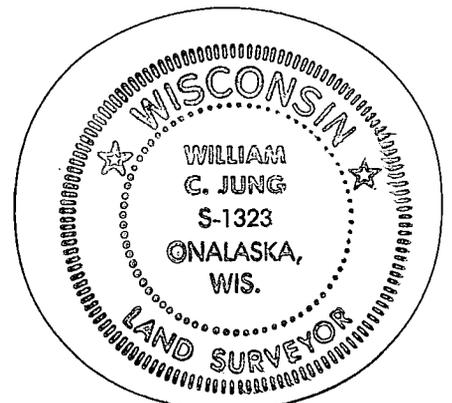

Seal