


21506340000

U. S. PUBLIC LAND SURVEY MONUMENT RECORD

SECTION 34 T 15 N, R 6 W, TOWN OF GREENFIELD

LA CROSSE COUNTY

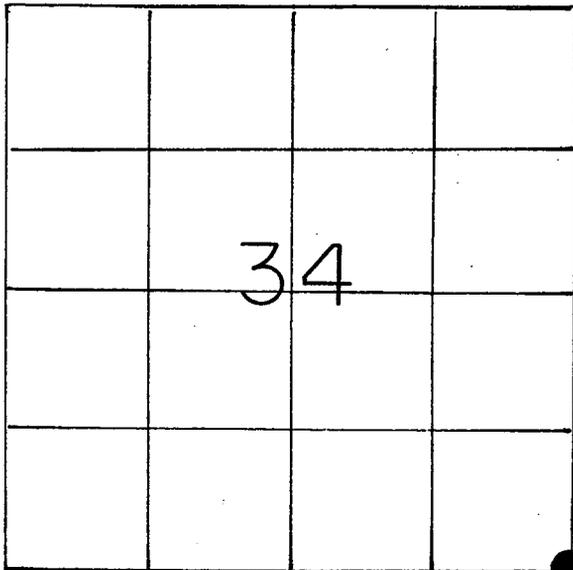

LOCATION OF LANDMARK

WISCONSIN COORDINATE SYSTEM

North

East

Theta Angle

Horiz. Order

Vert. Order

TYPE OF LANDMARK

SET BRASS CAP LUNDE MARKER

BEARINGS ARE REFERENCED TO

ASSUMED NORTH

Crew: WILLIAM C. JUNG
PETER F. FOLLANSBEE

Date: 8/24/1989

Describe any record evidence, monument evidence, testimonial evidence or any other material evidence you considered and whether the monument was found or restored through acceptance of an obliterated evidence location.

Based on the evidence found in Section 3-T14N-R6W, I feel that the Vernon County Surveyor set a stone at this corner over a century ago. I found many pieces of broken stone and set a brass capped Lunde marker for a corner at this position. This location fits the field evidence and section measurements very well. Mr. Roland Weimar and his brother both remembered a stone at this corner. He said that the location of the stone placed the house over the county line. He looked at our corner and agreed that this was where the stone was as best as he could remember. He also remembered that the people in the house were Vernon County residents because they slept in Vernon County even though the county line went ***


Describe or show any material discrepancy between the location of the restored corner and that of the corner previously restored or reestablished.

*** into the house. We searched the area at great length. Based on my survey, I feel certain that this location is where the old stone was. The stone was either destroyed by equipment or more than likely by the "herd" of children that used to live in the house. Mr. Weimar thought that the latter was the most likely.

This location does not agree with the old county highway R/W map.

U. S. PUBLIC LAND SURVEY MONUMENT RECORD

SECTION 2 T 14 N, R 6 W, TOWN OF HAMBURG
VERNON COUNTY

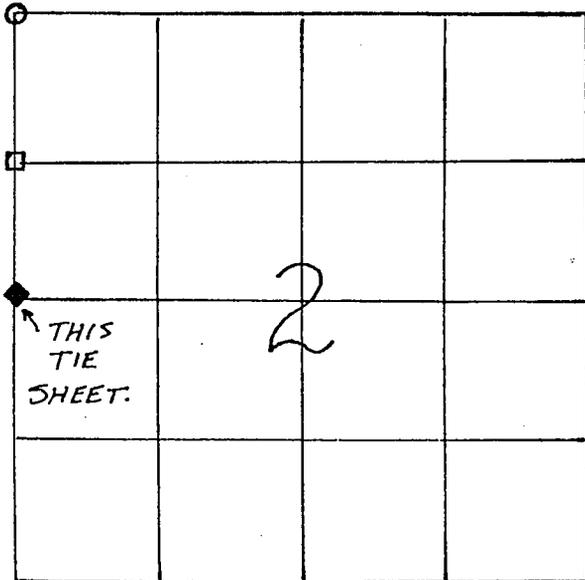

LOCATION OF LANDMARK

WISCONSIN COORDINATE SYSTEM
North
East
Theta Angle
Horiz. Order
Vert. Order
TYPE OF LANDMARK
EXIST. STONE W/"X"
BEARINGS ARE REFERENCED TO STATE PLANE COORDINATE SYSTEM; D.O.T. "ROTCHETT" & "WAYSIDE" MONUMENTS ON U.S.H. 14 & 61.

Describe any record evidence, monument evidence, testimonial evidence or any other material evidence you considered and whether the monument was found or restored through acceptance of an obliterated evidence location.


5"X7" STONE FOUND.
 B.T., N 11° W, 68 LINKS, CHECKED LOCATION.
 (ONLY STUMP, DECAYED, REMAINED.)

Describe or show any material discrepancy between the location of the restored corner and that of the corner previously restored or reestablished.

NONE.


RECORD OF DURABLE WITNESS MONUMENTS

NO	DESCRIPTION	BEARING	DISTANCE
1	30"φ WHITE OAK, P.K. NAIL SET E. SIDE.	N30°W ±	18.42'
2	FOUND: 1" I.P. (FROM PROP. SURVEY.)	N25°32'-50"W	8.82'
3	1/2" I.P. SET.	N74°03'-52"E	8.05'
4	3/4" I.P. SET.	S16°26'-27"E	16.99'

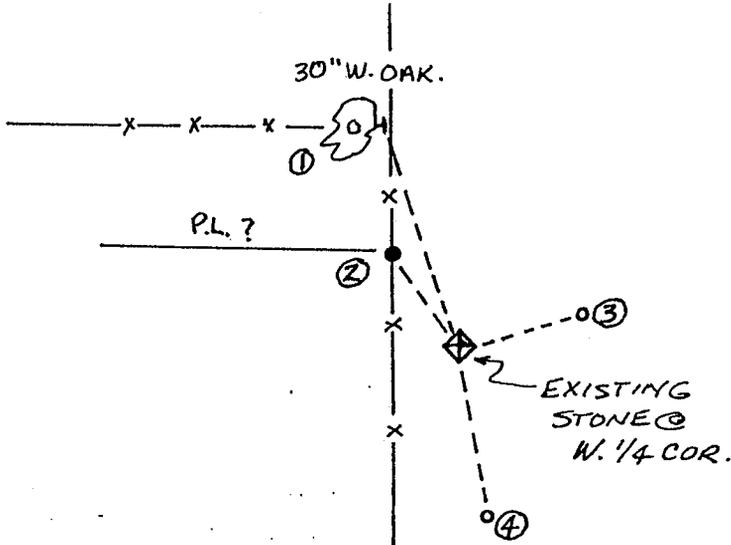

PLAN VIEW DRAWING OF REFERENCE TIES

MAP SHOWING DISTANCE AND DIRECTION TO OTHER PUBLIC LAND SURVEY CORNERS USED FOR REESTABLISHING THE CORNER

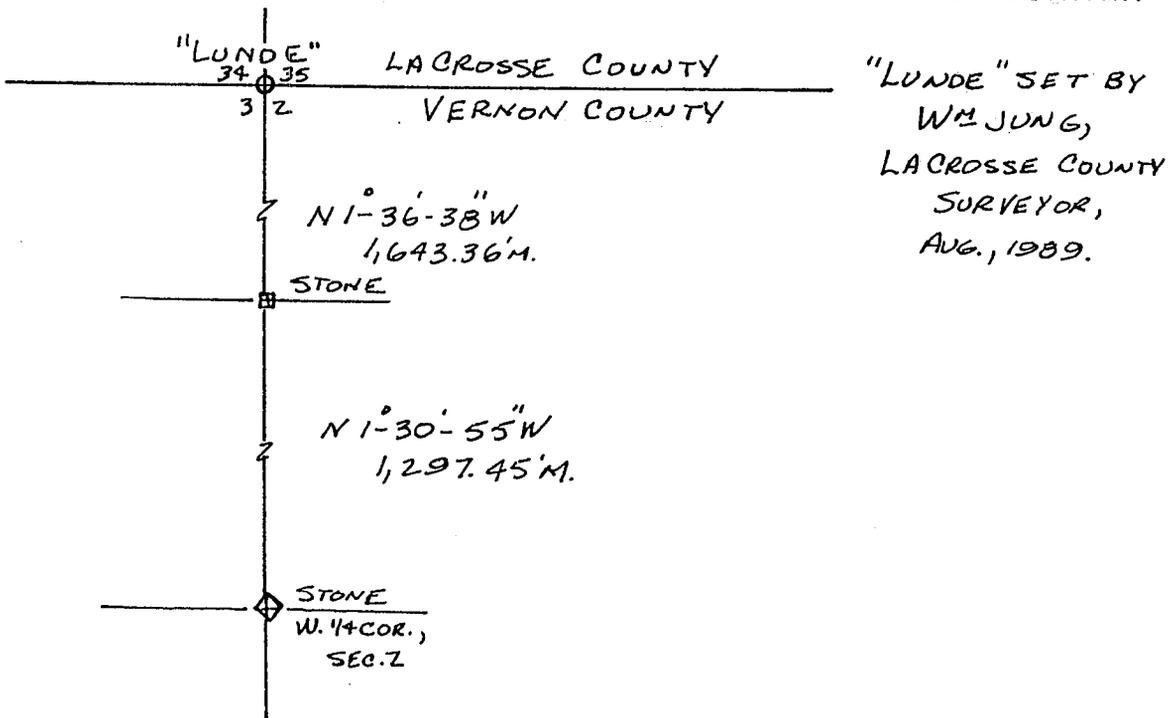

I, WILBUR L. CLARK, R.L.S. No. 914,
 HEREBY CERTIFY THAT THE CORNER LOCATION SHOWN ON THIS RECORD
 WAS DETERMINED BY ME OR UNDER MY DIRECTION AND CONTROL AND
 THAT THIS U. S. PUBLIC LAND SURVEY MONUMENT RECORD IS CORRECT
 AND COMPLETE TO THE BEST OF MY KNOWLEDGE AND BELIEF.

Wilbur L. Clark. 4-27-1995.
 Signature Date

