


U. S. PUBLIC LAND SURVEY MONUMENT RECORD

SECTION 34 T 15 N, R 6 W, TOWN OF GREENFIELD

LA CROSSE COUNTY

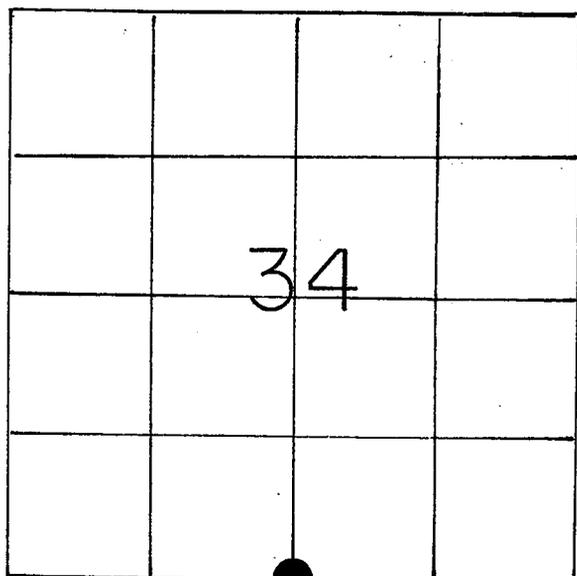

LOCATION OF LANDMARK

WISCONSIN COORDINATE SYSTEM
North
East
Theta Angle
Horiz. Order
Vert. Order
TYPE OF LANDMARK
EXISTING 4" x 5" STONE
BEARINGS ARE REFERENCED TO
ASSUMED NORTH

Crew: WILLIAM C. JUNG
 PETER F. FOLLANSBEE

Crew: William C. Jung
 Peter F. Follansbee

Date: 5/02/1989

Date: 3/19/07

Describe any record evidence, monument evidence, testimonial evidence or any other material evidence you considered and whether the monument was found or restored through acceptance of an obliterated evidence location.


I found a stone at the corner. This stone had been used in previous survey work. It was probably set by the Vernon County Surveyor over a century ago. I accepted the stone as the best available evidence of the original government corner position.

Describe or show any material discrepancy between the location of the restored corner and that of the corner previously restored or reestablished.

I do not agree with the pipe set at the fence corner to the Northeast. This pipe was probably set by Clayton Solberg.


RECORD OF DURABLE WITNESS MONUMENTS
MAGNETIC

NO	DESCRIPTION	BEARING	DISTANCE
1	Set 8" Nail in SE-side 8" Maple	S 40 W	25.89 Ft.
2	Existing P.K. Nail in 6" B.T.(SW-side)	N 64 W	25.61 Ft.
3	Ex. P.K. Nail in SW-side 6" White Oak	N 12 W	38.59 Ft.
4	Set P.K. Nail in old hack, 8" Oak(S-side)	N 80 E	8.75 Ft.

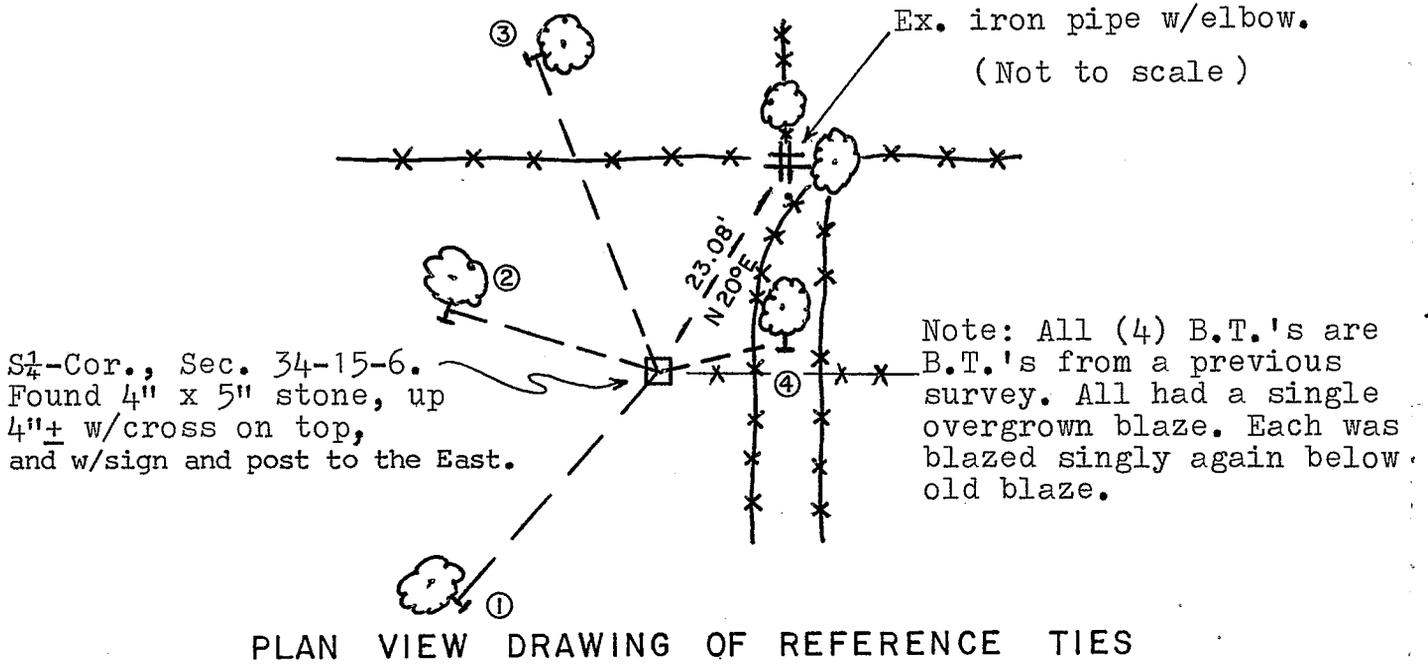

MAP SHOWING DISTANCE AND DIRECTION TO OTHER PUBLIC LAND
SURVEY CORNERS USED FOR REESTABLISHING THE CORNER

(not to scale)

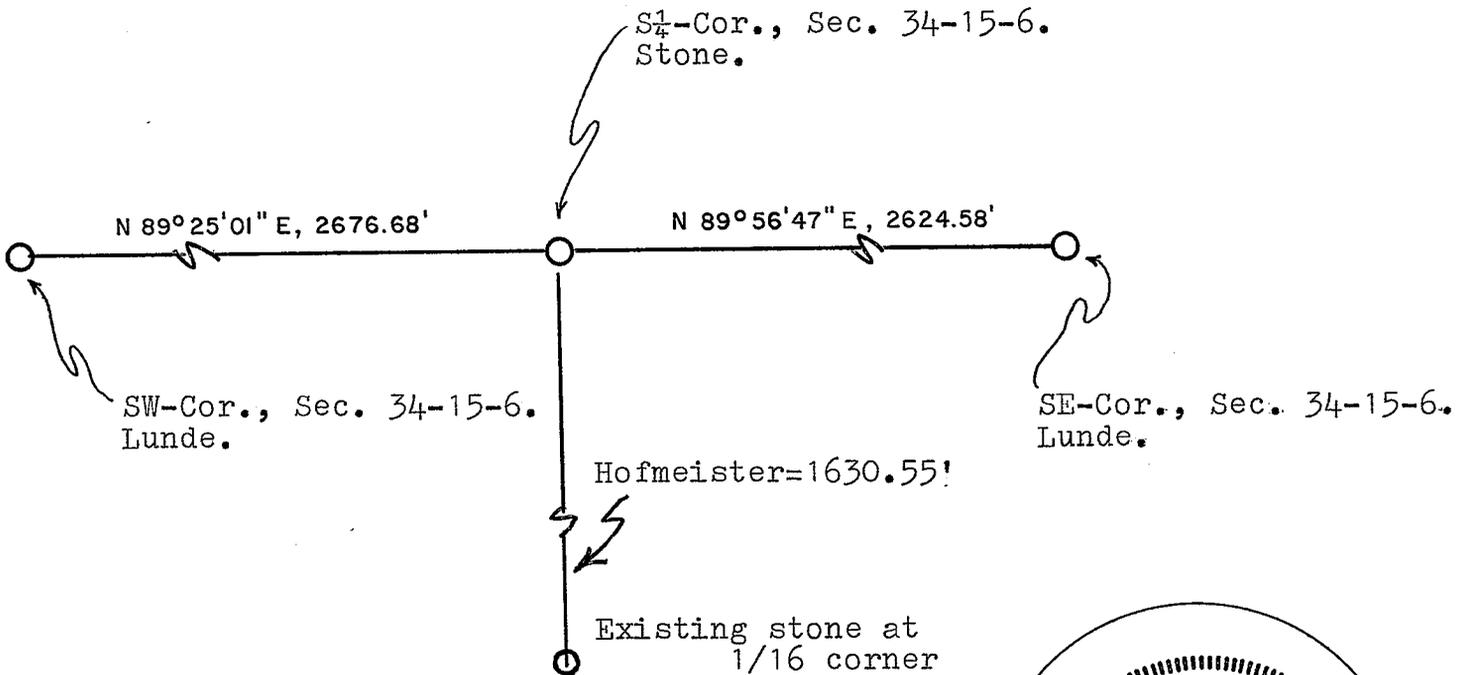

I, William C. Jung, ~~Deputy~~ County Surveyor
HEREBY CERTIFY THAT THE CORNER LOCATION SHOWN ON THIS RECORD
WAS DETERMINED BY ME OR UNDER MY DIRECTION AND CONTROL AND
THAT THIS U. S. PUBLIC LAND SURVEY MONUMENT RECORD IS CORRECT
AND COMPLETE TO THE BEST OF MY KNOWLEDGE AND BELIEF.

William C. Jung
Signature

12/26/1989

Date

Revised: 3/22/07 *wej*



Seal