


U. S. PUBLIC LAND SURVEY MONUMENT RECORD

SECTION 34 T 15 N, R 6 W, TOWN OF GREENFIELD

LA CROSSE COUNTY

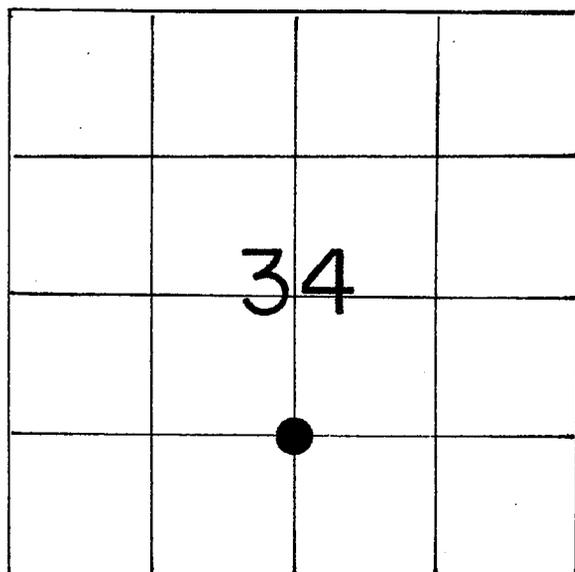

LOCATION OF LANDMARK

Crew: William C. Jung
Peter FollansbeeWitnesses: William Thoftne
Ron Hoffland

Date: October 21, 1989

Describe any record evidence, monument evidence, testimonial evidence or any other material evidence you considered and whether the monument was found or restored through acceptance of an obliterated evidence location.

I set the corner "by law" as set forth in Chapter 59.62 of the Wisconsin Statutes and using the U.S. Department of the Interior, Bureau of Land Management 1973 Manual of Surveying Instructions. I set this corner and established the 1/4 line between said corner and the South 1/4 Corner by the order of and under the direction of Charles Wuensch and William Thoftne. Mr. Thoftne assisted in the brushing of this line.

Describe or show any material discrepancy between the location of the restored corner and that of the corner previously restored or reestablished.

None known. The occupied fence corner far to the West is obviously in error. As we brushed and marked this 1/4 line, we found old fence going North-South and very close to the true line.

WISCONSIN COORDINATE SYSTEM

North

East

Theta Angle

Horiz. Order

Vert. Order

TYPE OF LANDMARK


1 1/2" (O.D.) iron pipe

BEARINGS ARE REFERENCED TO

Assumed


RECORD OF DURABLE WITNESS MONUMENTS
MAGNETIC

NO	DESCRIPTION	BEARING	DISTANCE
1	P.K. nail in double blazed 7" maple	N37°W	21.86'
2	" " " " " 14" white oak	S71°W	21.04'
3	" " " " " 14" bearing tree	S27°E	22.11'
4	" " " " " 11" white oak	N14°E	8.19'

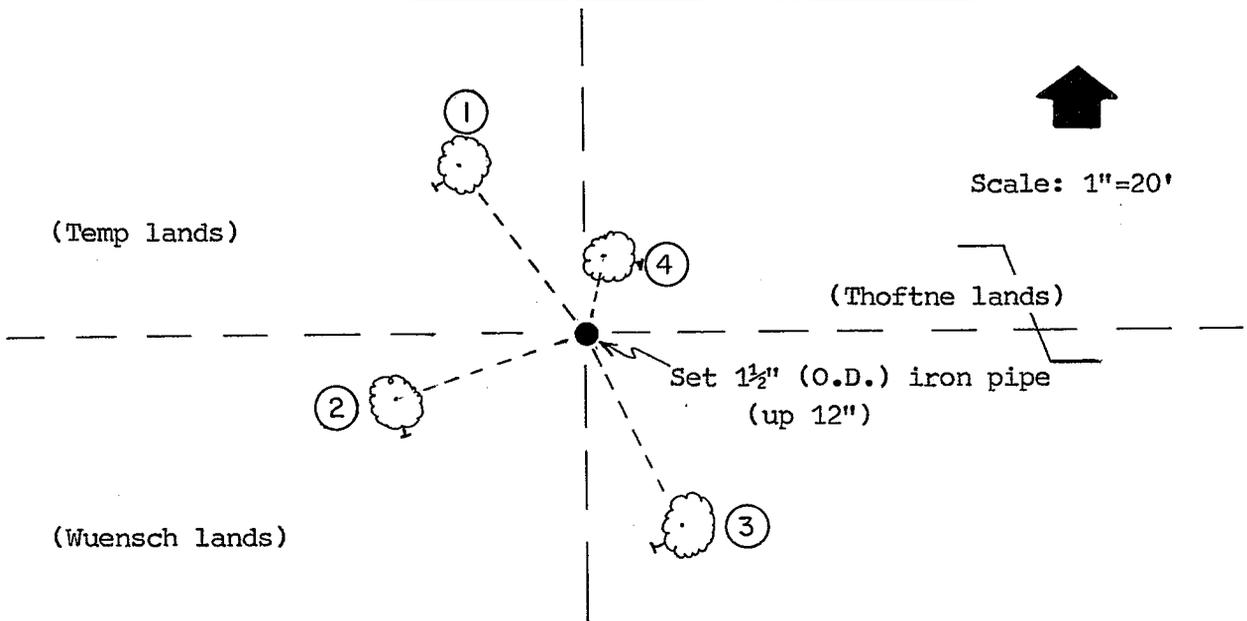

PLAN VIEW DRAWING OF REFERENCE TIES


MAP SHOWING DISTANCE AND DIRECTION TO OTHER PUBLIC LAND SURVEY CORNERS USED FOR REESTABLISHING THE CORNER

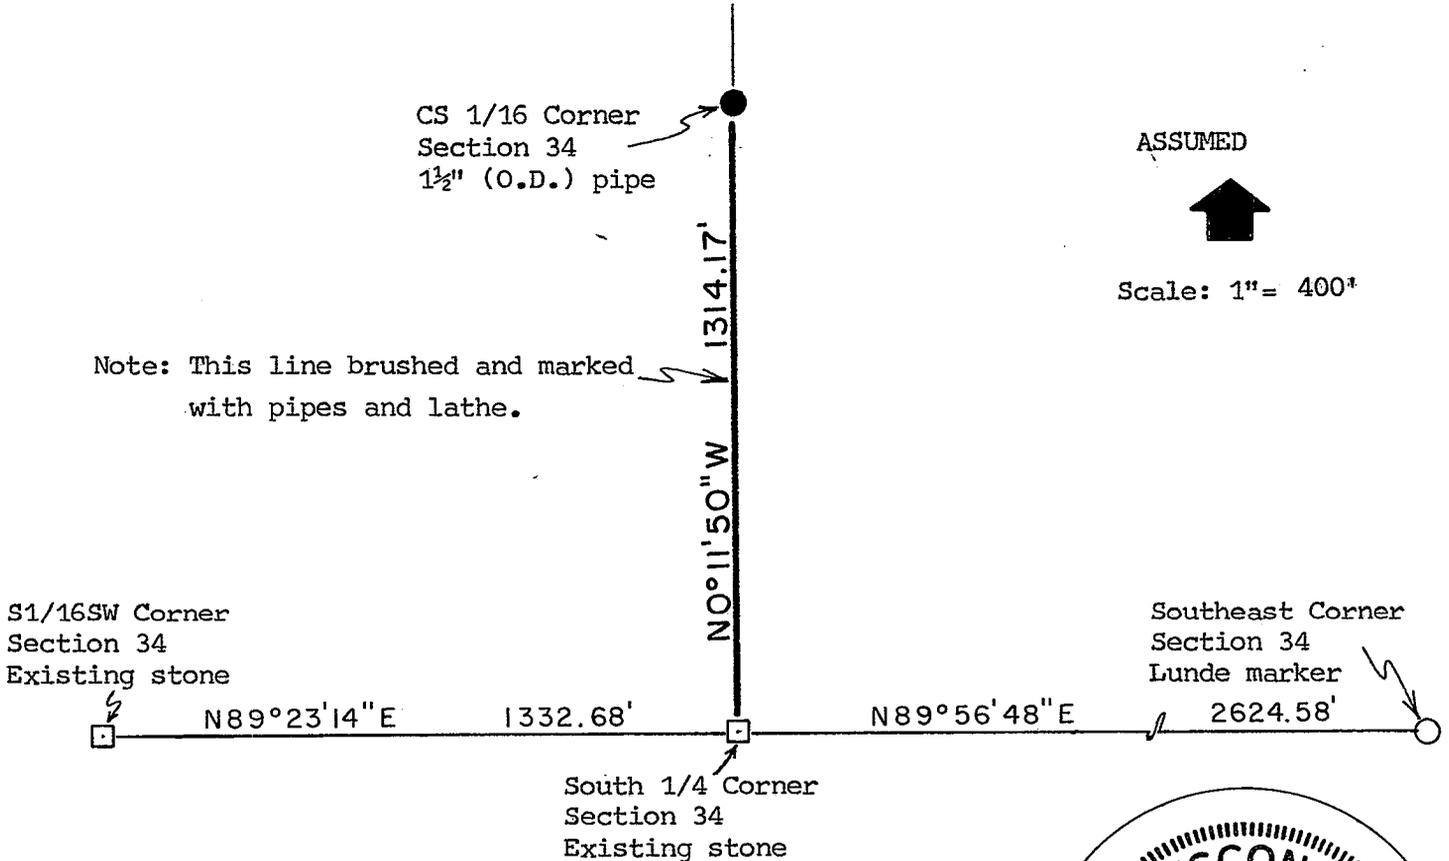

I, William C. Jung, Registered Land Surveyor,
HEREBY CERTIFY THAT THE CORNER LOCATION SHOWN ON THIS RECORD
WAS DETERMINED BY ME OR UNDER MY DIRECTION AND CONTROL AND
THAT THIS U. S. PUBLIC LAND SURVEY MONUMENT RECORD IS CORRECT
AND COMPLETE TO THE BEST OF MY KNOWLEDGE AND BELIEF.

William C. Jung
Signature

November 13, 1989
Date

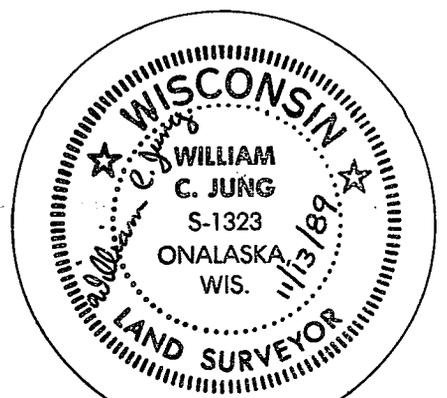

Seal