


U. S. PUBLIC LAND SURVEY MONUMENT RECORD

SECTION 35 T 15 N, R 6 W, TOWN OF GREENFIELD

LA CROSSE COUNTY

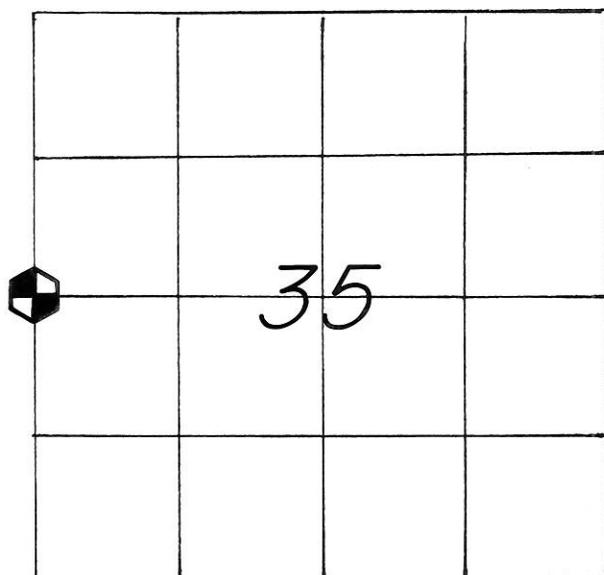

LOCATION OF LANDMARK

CREW: **BRYAN H. MEYER**
PETER F. FOLLANSBEE
 DATE: **9/21/2009**

WISCONSIN COORDINATE SYSTEM	
North	633,167.806
East	1,685,466.186
Theta Angle	
Horiz. Order	
Vert. Order	
DATUM:	NAD 1983('91)
TYPE OF LANDMARK	
BRASS CAP LUNDE MARKER.	
BEARINGS ARE REFERENCED TO	
GRID NORTH AS PER SECTION DATA.	

Describe any record evidence, monument evidence, testimonial evidence or any other material evidence you considered and whether the monument was found or restored through acceptance of an obliterated evidence location.

Describe or show any material discrepancy between the location of the restored corner and that of the corner previously restored or reestablished.


RECORD OF DURABLE WITNESS MONUMENTS

NO	DESCRIPTION	GRID BEARINGS	GRID DIST.'s
		BEARING	DISTANCE
1	SET A 3/4"x30" IRON BAR 8' W. OF CENTERLINE	N 40°02'57"E	881.92 FT.
2	SET A 3/4"x 30" I. BAR 8' W. OF E & 20' N. OF F.E.	N 69°54'02"E	761.64 FT.
3	EX. 1-1/4" IRON PIPE AT S.W.-COR. OF PROP. SURVEY	S 89°27'50"E	845.40 FT.
4	SET A NAIL IN THE SIDE OF A 6-1/2" BOX ELDER	S 86°E (MAG.)	5.53 FT.

(GRID BEARINGS AND DISTANCES)
 (GRID FACTOR: 0.999875)
 (NOT TO SCALE)
 (F.E. = FIELD ENTRANCE)

(F I E L D)


W. 1/4-COR., SEC. 35-15-6.
 EX. BRASS CAP LUNDE MARKER
 IN A BRUSHY FENCE-ROW. SET
 A SIGN & POST ON THE
 NORTH SIDE OF THE MARKER.

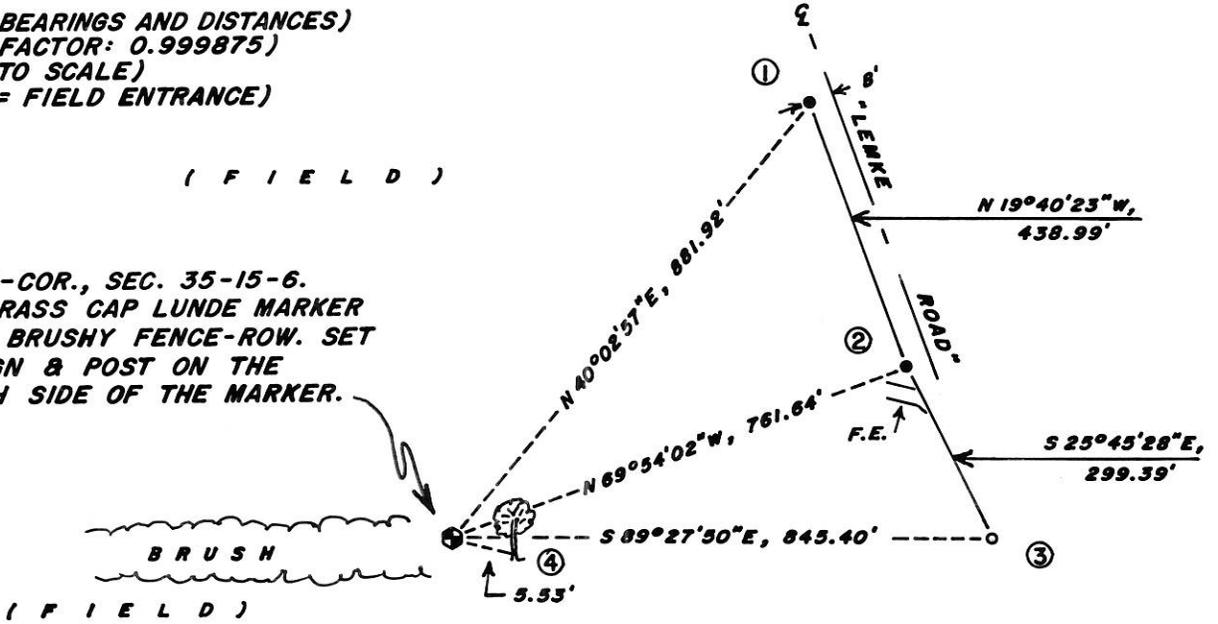

PLAN VIEW DRAWING OF REFERENCE TIES

MAP SHOWING DISTANCE AND DIRECTION TO OTHER PUBLIC LAND SURVEY CORNERS USED FOR REESTABLISHING THE CORNER

(GRID BEARINGS AND DISTANCES)
 (GRID FACTOR: 0.999875)
 (NOT TO SCALE)

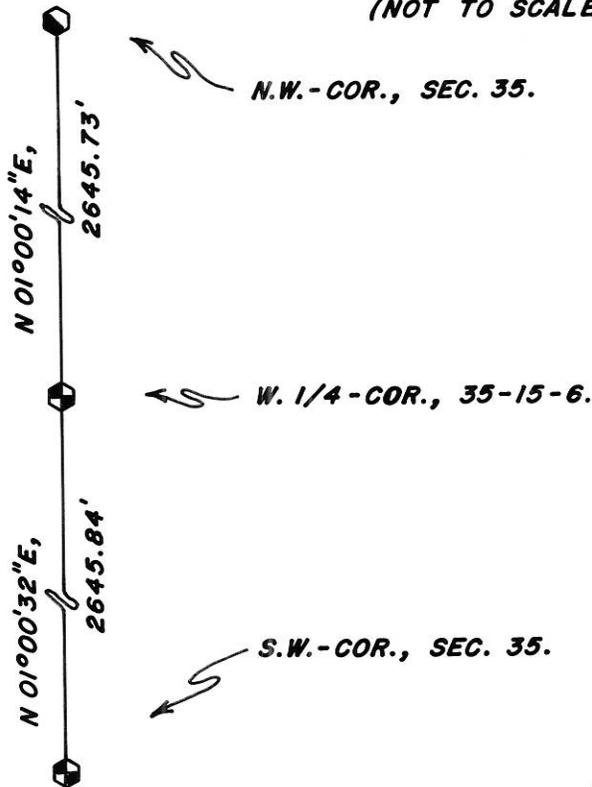

I, BRYAN H. MEYER, COUNTY SURVEYOR
 HEREBY CERTIFY THAT THE CORNER LOCATION SHOWN ON THIS RECORD
 WAS DETERMINED BY ME OR UNDER MY DIRECTION AND CONTROL AND
 THAT THIS U. S. PUBLIC LAND SURVEY MONUMENT RECORD IS CORRECT
 AND COMPLETE TO THE BEST OF MY KNOWLEDGE AND BELIEF.

Bryan H. Meyer
 Signature

9/30/2009
 Date




Seal

21506342000

U. S. PUBLIC LAND SURVEY MONUMENT RECORD

SECTION 34 T 15 N, R 6 W, TOWN OF GREENFIELD
 LA CROSSE COUNTY

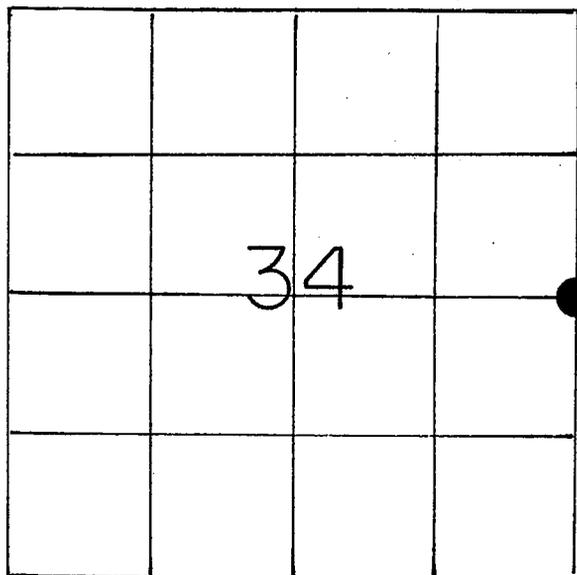

LOCATION OF LANDMARK

Crew: WILLIAM C. JUNG
 PETER F. FOLLANSBEE

Date: 8/29/1989

Describe any record evidence, monument evidence, testimonial evidence or any other material evidence you considered and whether the monument was found or restored through acceptance of an obliterated evidence location.

I set the corner by single proportionate measurement and monumented it with a brass capped Lunde marker.

Describe or show any material discrepancy between the location of the restored corner and that of the corner previously restored or reestablished.

Joe Murphy's CSM (8/2/75), Clayton Solberg's CSM (7/2/81), and Steve Solberg's CSM (1/16/87) are all tied to this corner. I do not agree with the corner location as shown on these maps. I searched but did not find a monument at this corner. I doubt if one was ever set by Murphy.

WISCONSIN COORDINATE SYSTEM

North

East

Theta Angle

Horiz. Order

Vert. Order

TYPE OF LANDMARK

SET BRASS CAP LUNDE MARKER

BEARINGS ARE REFERENCED TO

ASSUMED NORTH

