


21506350000

U. S. PUBLIC LAND SURVEY MONUMENT RECORD

SECTION 36 T 15 N, R 6 W, TOWN OF GREENFIELD

LA CROSSE COUNTY

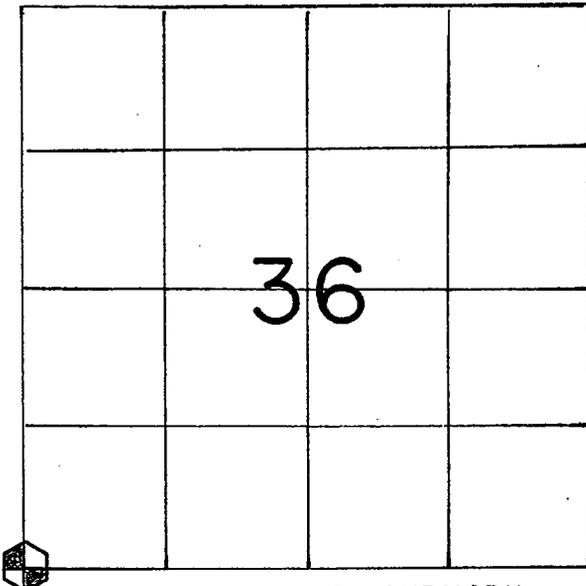

LOCATION OF LANDMARK

Crew: William C. Jung
Peter F. Follansbee

Date: May 19, 1995

Describe any record evidence, monument evidence, testimonial evidence or any other material evidence you considered and whether the monument was found or restored through acceptance of an obliterated evidence location.

I accepted the old occupied fence corner as the best available evidence of the original government corner position and monumented it with a brass capped Lunde marker. About 22.5'± to the East is a depression just North of the fence. In May of 1909, E.J. Older, Vernon County Surveyor, shows a black oak bearing tree 33 links to the East. The stump hole ? (depression) could be from that tree.

Describe or show any material discrepancy between the location of the restored corner and that of the corner previously restored or reestablished.

None Known.

WISCONSIN COORDINATE SYSTEM

North

East

Theta Angle

Horiz. Order

Vert. Order

TYPE OF LANDMARK


Set brass cap Lunde marker.

BEARINGS ARE REFERENCED TO

Grid


RECORD OF DURABLE WITNESS MONUMENTS
MAGNETIC

NO	DESCRIPTION	BEARING	DISTANCE
1	Set P.K. Nail in N.-side 19" W. Oak	S 75° W	42.57 ft.
2	Set P.K. Nail in E.-side 26" W. Oak	N 05° W	65.12 ft.
3	Set P.K. Nail in NW-side 10" Hickory	N 60° E	62.84 ft.
4	Set P.K. Nail in SW-side 16" Hickory	S 48° E	23.39 ft.

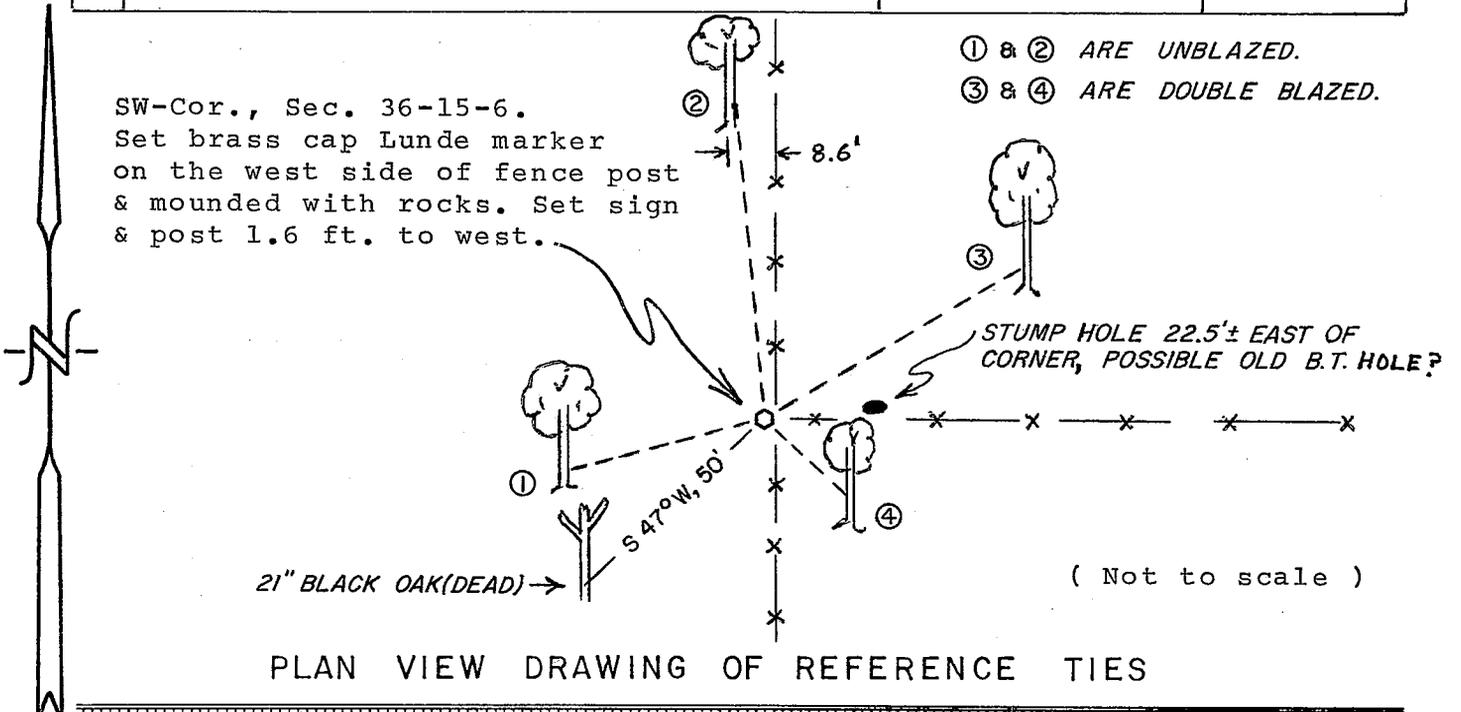


MAP SHOWING DISTANCE AND DIRECTION TO OTHER PUBLIC LAND SURVEY CORNERS USED FOR REESTABLISHING THE CORNER

(not to scale)

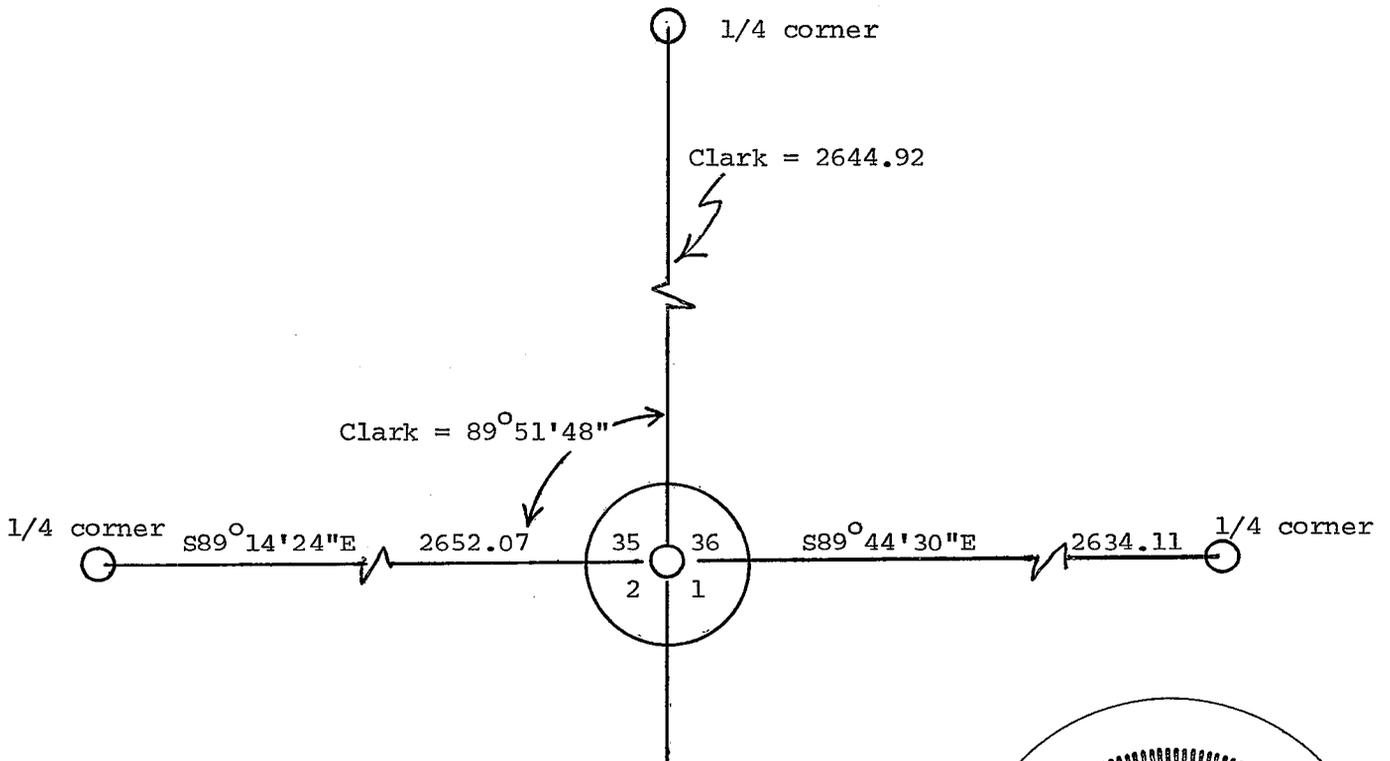

I, William C. Jung, County Surveyor
HEREBY CERTIFY THAT THE CORNER LOCATION SHOWN ON THIS RECORD
WAS DETERMINED BY ME OR UNDER MY DIRECTION AND CONTROL AND
THAT THIS U. S. PUBLIC LAND SURVEY MONUMENT RECORD IS CORRECT
AND COMPLETE TO THE BEST OF MY KNOWLEDGE AND BELIEF.

William C. Jung 1/2/96
Signature Date

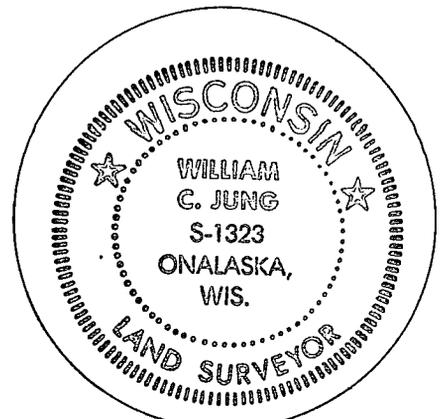

Seal