


U. S. PUBLIC LAND SURVEY MONUMENT RECORD

SECTION 35 T 15 N, R 6 W, TOWN OF GREENFIELD

LA CROSSE COUNTY

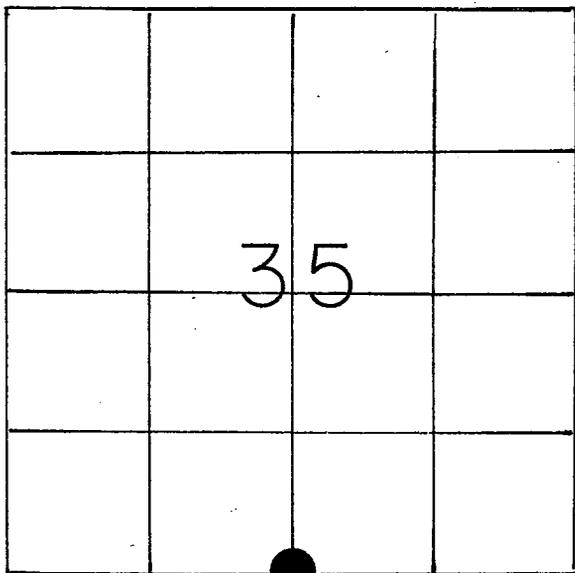

LOCATION OF LANDMARK

WISCONSIN COORDINATE SYSTEM

North

East

Theta Angle

Horiz. Order

Vert. Order

TYPE OF LANDMARK

SET BRASS CAP LUNDE MARKER

BEARINGS ARE REFERENCED TO

ASSUMED NORTH

Crew: WILLIAM C. JUNG
PETER F. FOLLANSBEE

Crew: William C. Jung
Peter F. Follansbee

Date: 7/26/1989

Date: 5/19/95

Describe any record evidence, monument evidence, testimonial evidence or any other material evidence you considered and whether the monument was found or restored through acceptance of an obliterated evidence location.

I accepted the occupied fence corner as the best available evidence of the original government corner position and monumented it with a brass capped Lunde marker.


Note: Found an old rotted down fence post at the fence intersection.
Buried a wine bottle on the East side of the Lunde marker.

Describe or show any material discrepancy between the location of the restored corner and that of the corner previously restored or reestablished.

NONE KNOWN


RECORD OF DURABLE WITNESS MONUMENTS

NO	DESCRIPTION	MAGNETIC	
		BEARING	DISTANCE
1	Set P.K. Nail in North side 13" White Oak	N 90°W	47.93 Ft.
2	Set P.K. Nail in Northeast side 10" Maple <i>gone!</i>	N 57°W	30.08 Ft.
3	Set P.K. Nail in Northeast side 12" Maple	N 38°W	40.34 Ft.
4	Set P.K. Nail in Northwest side 7" Maple	S 48°W	8.83 Ft.

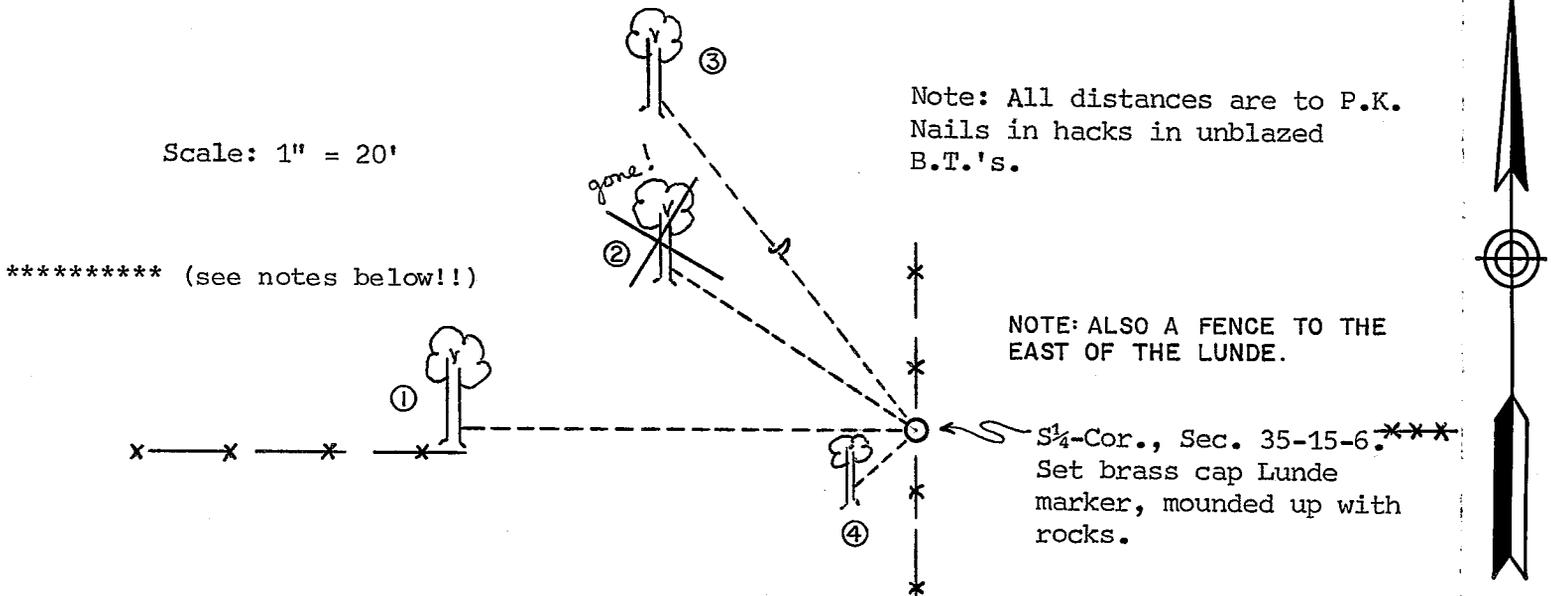

PLAN VIEW DRAWING OF REFERENCE TIES

MAP SHOWING DISTANCE AND DIRECTION TO OTHER PUBLIC LAND SURVEY CORNERS USED FOR REESTABLISHING THE CORNER

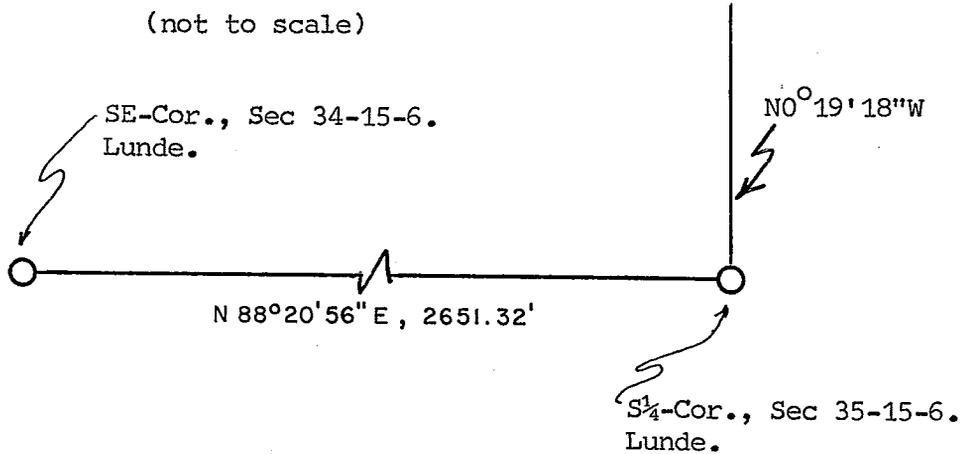

Note: 5/19/95 - We found our Lunde in the rocks and set a sign and post to the North. The area to the NW had been logged. The white oak BT to the West was still in. One of the B.T.'s to the NW was cut down. East of it and NW of the corner is an unblazed 6" maple, 27.5' from corner to center of tree. S-SW of the Lunde is an unblazed 7 1/2" elm, 3.7' from corner to center of tree.

I, William C. Jung, Deputy County Surveyor
 HEREBY CERTIFY THAT THE CORNER LOCATION SHOWN ON THIS RECORD
 WAS DETERMINED BY ME OR UNDER MY DIRECTION AND CONTROL AND
 THAT THIS U. S. PUBLIC LAND SURVEY MONUMENT RECORD IS CORRECT
 AND COMPLETE TO THE BEST OF MY KNOWLEDGE AND BELIEF.

William C. Jung
 Signature Date 12/26/1989

Revised: 2/6/96 *wey*



Seal