


U. S. PUBLIC LAND SURVEY MONUMENT RECORD

SECTION 36 T 15 N, R 6 W, TOWN OF GREENFIELD

LA CROSSE COUNTY

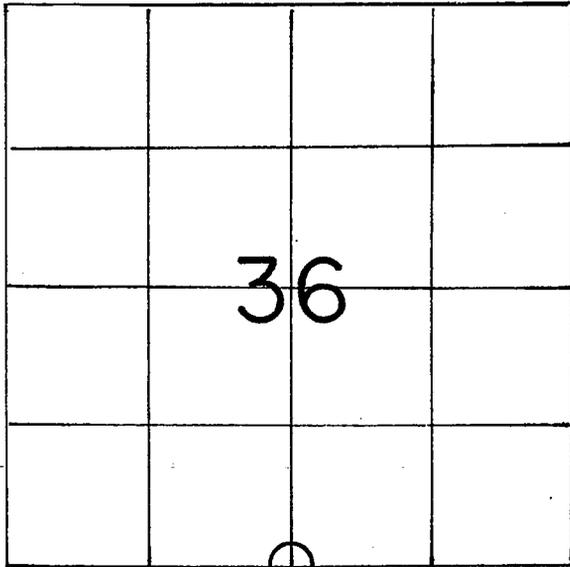

LOCATION OF LANDMARK

WILLIAM C. JUNG
PETER F. FOLLANSBEE

Date: 5/30/1995

Describe any record evidence, monument evidence, testimonial evidence or any other material evidence you considered and whether the monument was found or restored through acceptance of an obliterated evidence location.

I set this corner by single proportionate measurement and monumented it with a pipe.

Describe or show any material discrepancy between the location of the restored corner and that of the corner previously restored or reestablished.

None Known.

WISCONSIN COORDINATE SYSTEM

North

East

Theta Angle

Horiz. Order

Vert. Order

TYPE OF LANDMARK


Set 1" x 30" Iron Pipe.

BEARINGS ARE REFERENCED TO

GRID. NORTH.


RECORD OF DURABLE WITNESS MONUMENTS

NO	DESCRIPTION	BEARING	DISTANCE
1	Bolt survey point west of pavement	S 54° 17' 59" W	406.90 Ft.
2	1½" Iron Pipe survey point 12' W. of \perp	N 87° 18' 44" W	327.86 Ft.
3	Set P.K. Nail in NW-side 8" Box Elder	N 27° E (Mag.)	135.81 Ft.
4	Set P.K. Nail in NE-side 12" Elm	S 71° E (Mag.)	Sl.=113.2'

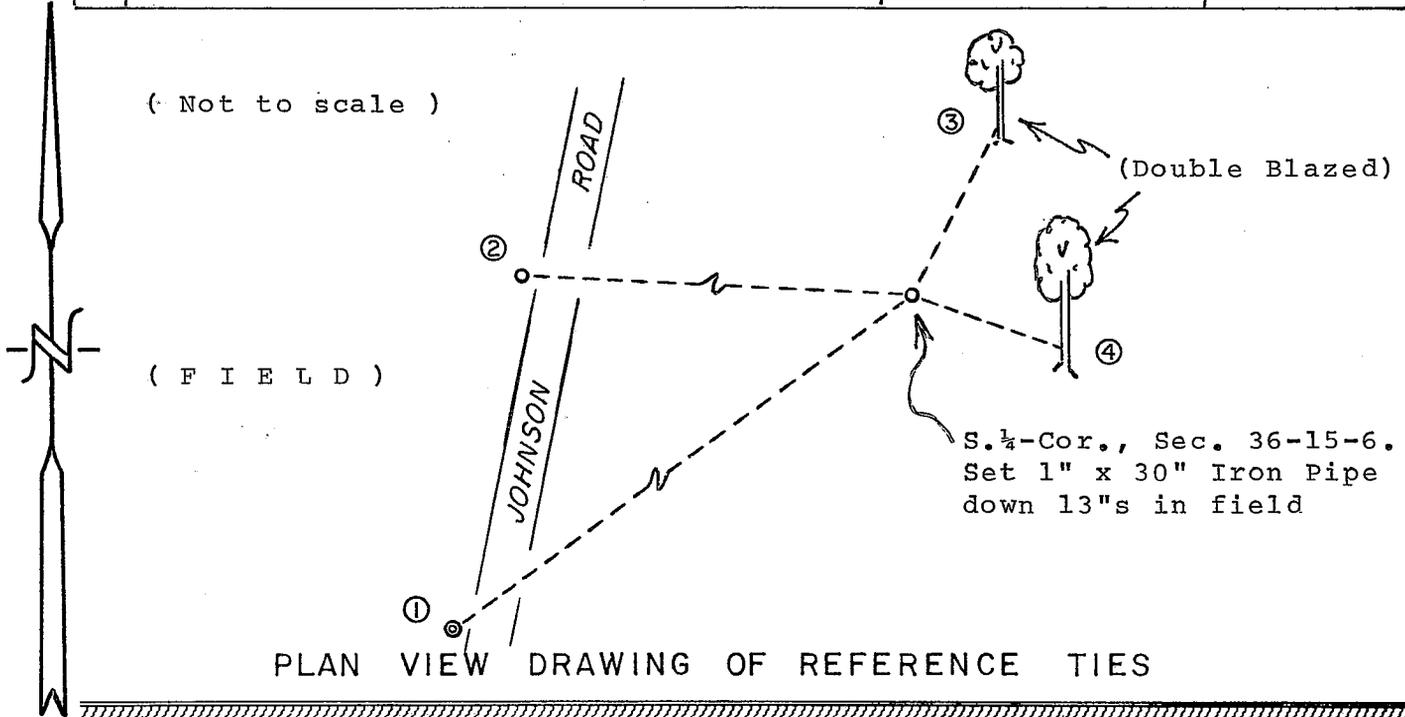


MAP SHOWING DISTANCE AND DIRECTION TO OTHER PUBLIC LAND SURVEY CORNERS USED FOR REESTABLISHING THE CORNER

(not to scale)

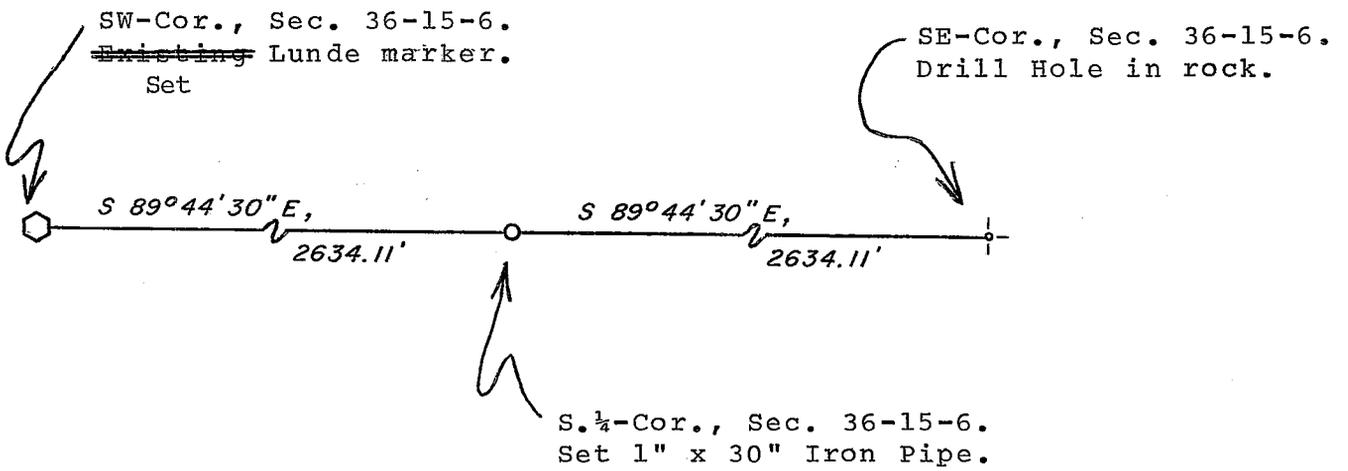

I, William C. Jung, County Surveyor
HEREBY CERTIFY THAT THE CORNER LOCATION SHOWN ON THIS RECORD
WAS DETERMINED BY ME OR UNDER MY DIRECTION AND CONTROL AND
THAT THIS U. S. PUBLIC LAND SURVEY MONUMENT RECORD IS CORRECT
AND COMPLETE TO THE BEST OF MY KNOWLEDGE AND BELIEF.

William C. Jung 1/2/96
Signature Date

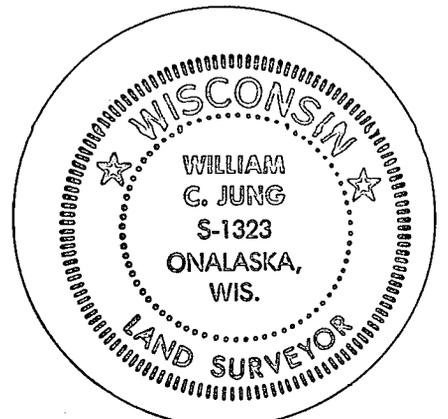

Seal