


U. S. PUBLIC LAND SURVEY MONUMENT RECORD

SECTION 6 T 15 N, R 6 W, TOWN OF SHELBY

LA CROSSE COUNTY

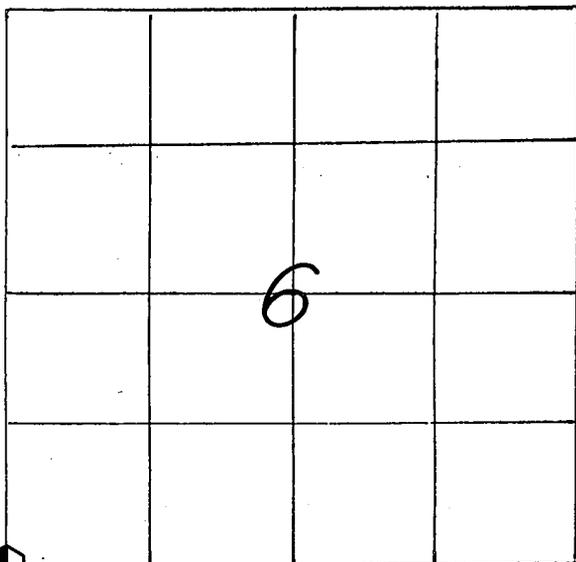

LOCATION OF LANDMARK

CREW: WILLIAM C. JUNG
 PETER F. FOLLANSBEE
 DATE: 11/24/1998

WISCONSIN COORDINATE SYSTEM
North
East
Theta Angle
Horiz. Order
Vert. Order
TYPE OF LANDMARK
BRASS CAP LUNDE MARKER.
BEARINGS ARE REFERENCED TO

Describe any record evidence, monument evidence, testimonial evidence or any other material evidence you considered and whether the monument was found or restored through acceptance of an obliterated evidence location.

We found the monument of record knocked out. The destroyed monument had been used as the section corner in many previous surveys. After the completion of his traversing, Paul Fairchild set an iron bar at the location of the old monument.

I replaced the iron bar with a brass capped Lunde marker.

Describe or show any material discrepancy between the location of the restored corner and that of the corner previously restored or reestablished.


None known.

RECORD OF DURABLE WITNESS MONUMENTS

MAGNETIC

NO	DESCRIPTION	BEARING	DISTANCE
1	CENTER OF TOP OF WELL CAP IN A BACKYARD LAWN	N 37° W	68.91 FT.
2	SET A NAIL IN S.W.-SIDE OF A POWERPOLE	N 59° W	23.38 FT.
3	SET A NAIL IN S.-SIDE OF A 30" COTTONWOOD	S 82° W	105.69 FT.
4	SET A NAIL IN S.E.-SIDE OF A 20" COTTONWOOD	S 42° W	134.48 FT.

(NOT TO SCALE)

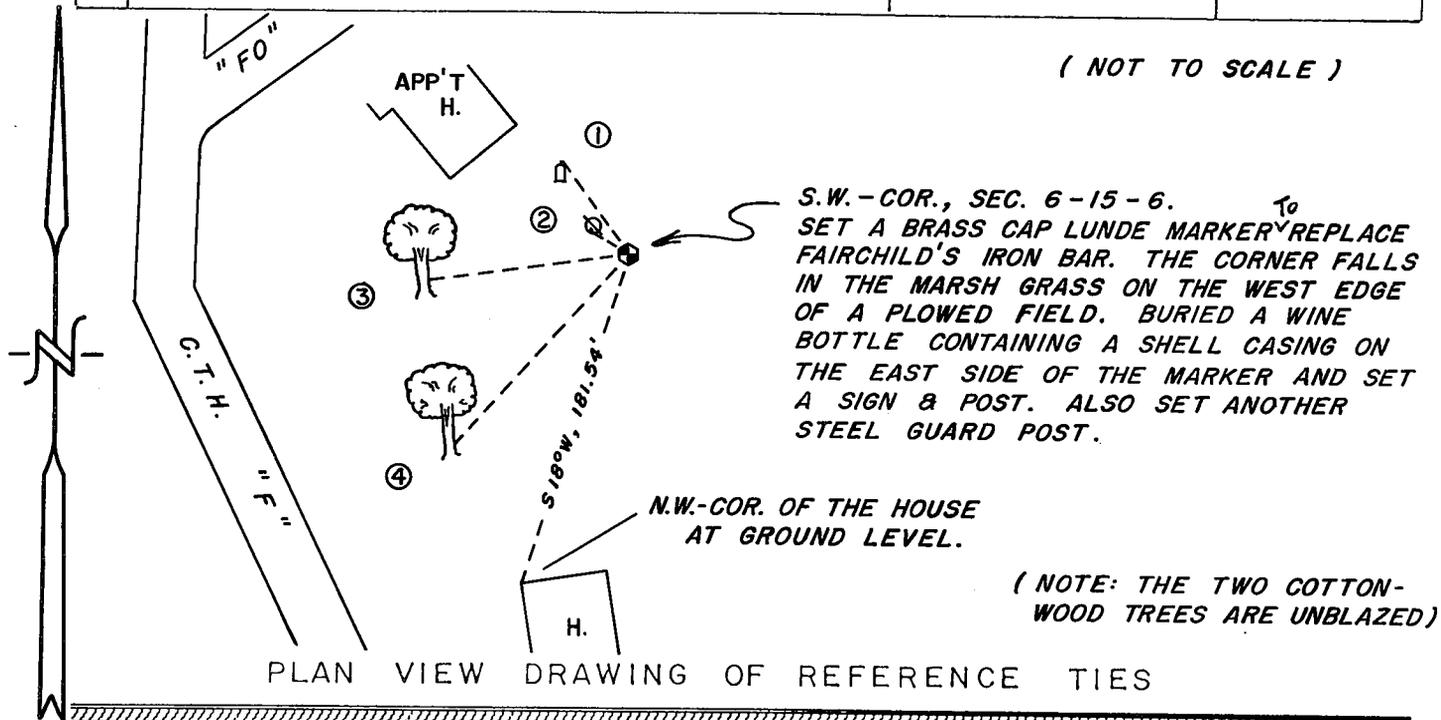


MAP SHOWING DISTANCE AND DIRECTION TO OTHER PUBLIC LAND SURVEY CORNERS USED FOR REESTABLISHING THE CORNER

No section measurements were made by me at this time. The location of this corner was confirmed by Paul Fairchild.

I, WILLIAM C. JUNG, COUNTY SURVEYOR
 HEREBY CERTIFY THAT THE CORNER LOCATION SHOWN ON THIS RECORD WAS DETERMINED BY ME OR UNDER MY DIRECTION AND CONTROL AND THAT THIS U. S. PUBLIC LAND SURVEY MONUMENT RECORD IS CORRECT AND COMPLETE TO THE BEST OF MY KNOWLEDGE AND BELIEF.

William C. Jung 1/12/99
 Signature Date

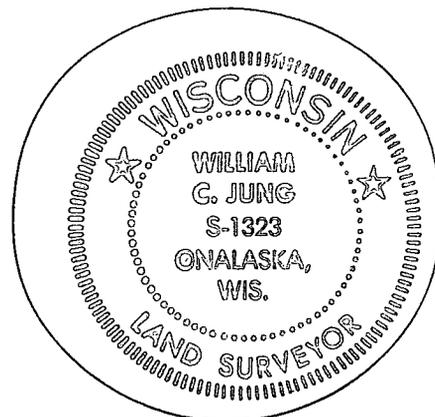

Seal