


## U. S. PUBLIC LAND SURVEY MONUMENT RECORD

SECTION 30 T 15 N, R 6 W, TOWN OF SHELBY  
LA CROSSE COUNTY

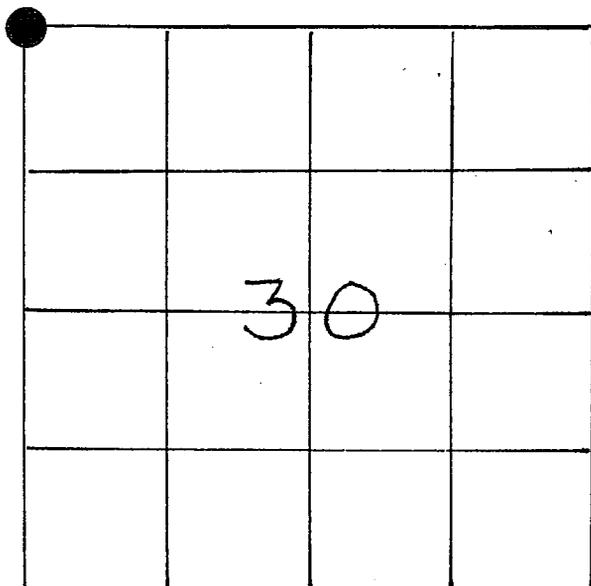

LOCATION OF LANDMARK

CREW: P. FAIRCHILD  
R. JASPERSON

## WISCONSIN COORDINATE SYSTEM

North

East

Theta Angle

Horiz. Order

Vert. Order

## TYPE OF LANDMARK

1/4" I.P.

BEARINGS ARE REFERENCED TO

Describe any record evidence, monument evidence, testimonial evidence or any other material evidence you considered and whether the monument was found or restored through acceptance of an obliterated evidence location.


FD 1/4" I.P. W/HOFFMEISTER PLUG WHICH HAS BEEN USED IN PREVIOUS SURVEYS AND ACCEPTED IT AS THE NORTHWEST SECTION CORNER

Describe or show any material discrepancy between the location of the restored corner and that of the corner previously restored or reestablished.

NO DISCREPANCY

RECORD OF DURABLE WITNESS MONUMENTS

NO	DESCRIPTION	BEARING	DISTANCE
1	R/R SPIKE E OF ROAD, 3' N. OF CULV.	N 14° 25' 55" E	647.55'
2	R/R SPIKE E OF ROAD, E OF CULV.	N 36° 12' 55" E	536.66'
3	PK IN POWER POLE	N 37° 51' 22" W	190.67'
4	PK IN POWER POLE	S 53° 06' 11" E	85.31'

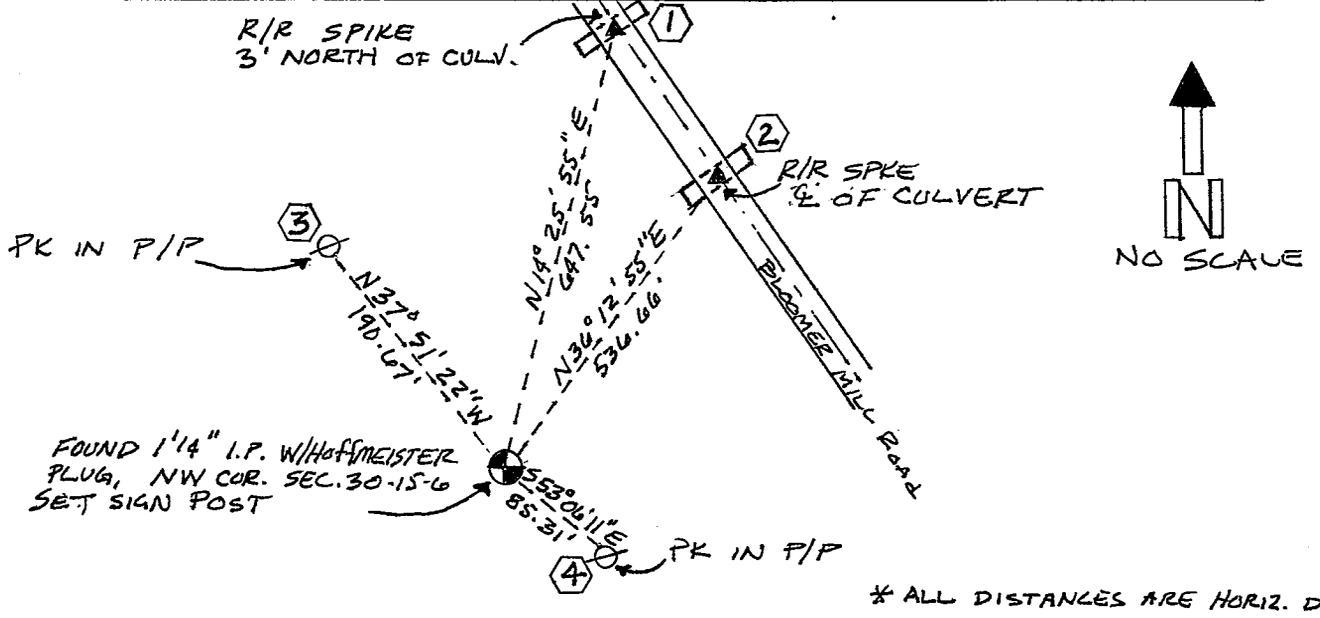

\* ALL DISTANCES ARE HORIZ. DIST.

PLAN VIEW DRAWING OF REFERENCE TIES

MAP SHOWING DISTANCE AND DIRECTION TO OTHER PUBLIC LAND SURVEY CORNERS USED FOR REESTABLISHING THE CORNER

I, Paul E. Fairchild  
 HEREBY CERTIFY THAT THE CORNER LOCATION SHOWN ON THIS RECORD  
 WAS DETERMINED BY ME OR UNDER MY DIRECTION AND CONTROL AND  
 THAT THIS U. S. PUBLIC LAND SURVEY MONUMENT RECORD IS CORRECT  
 AND COMPLETE TO THE BEST OF MY KNOWLEDGE AND BELIEF.

Paul E. Fairchild      5/17/99  
 Signature      Date



Seal